REVISED NOVEMBER 4,1987

NOTE:
- GRANULAR BACKFILL REQUIRED, COMPACTED TO 95% RELATIVE DENSITY
- CONCRETE CULVERT PIPE MAY BE USED

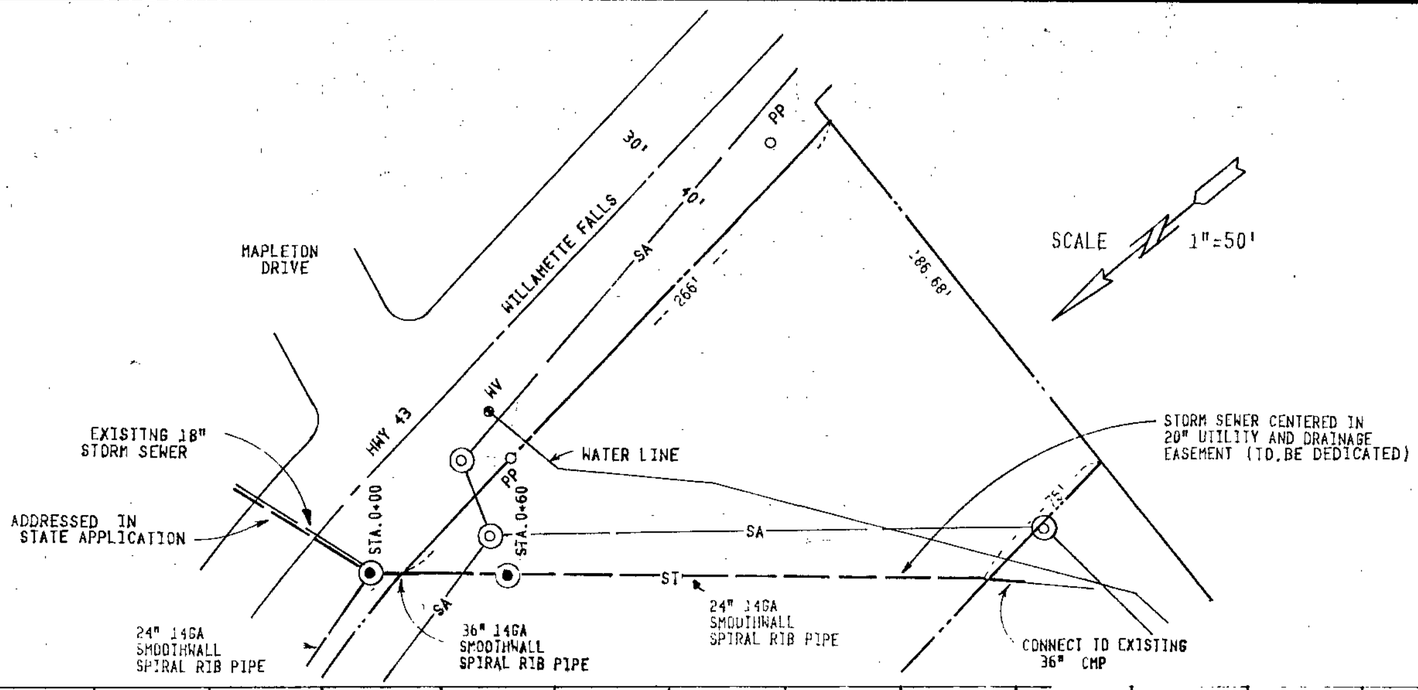

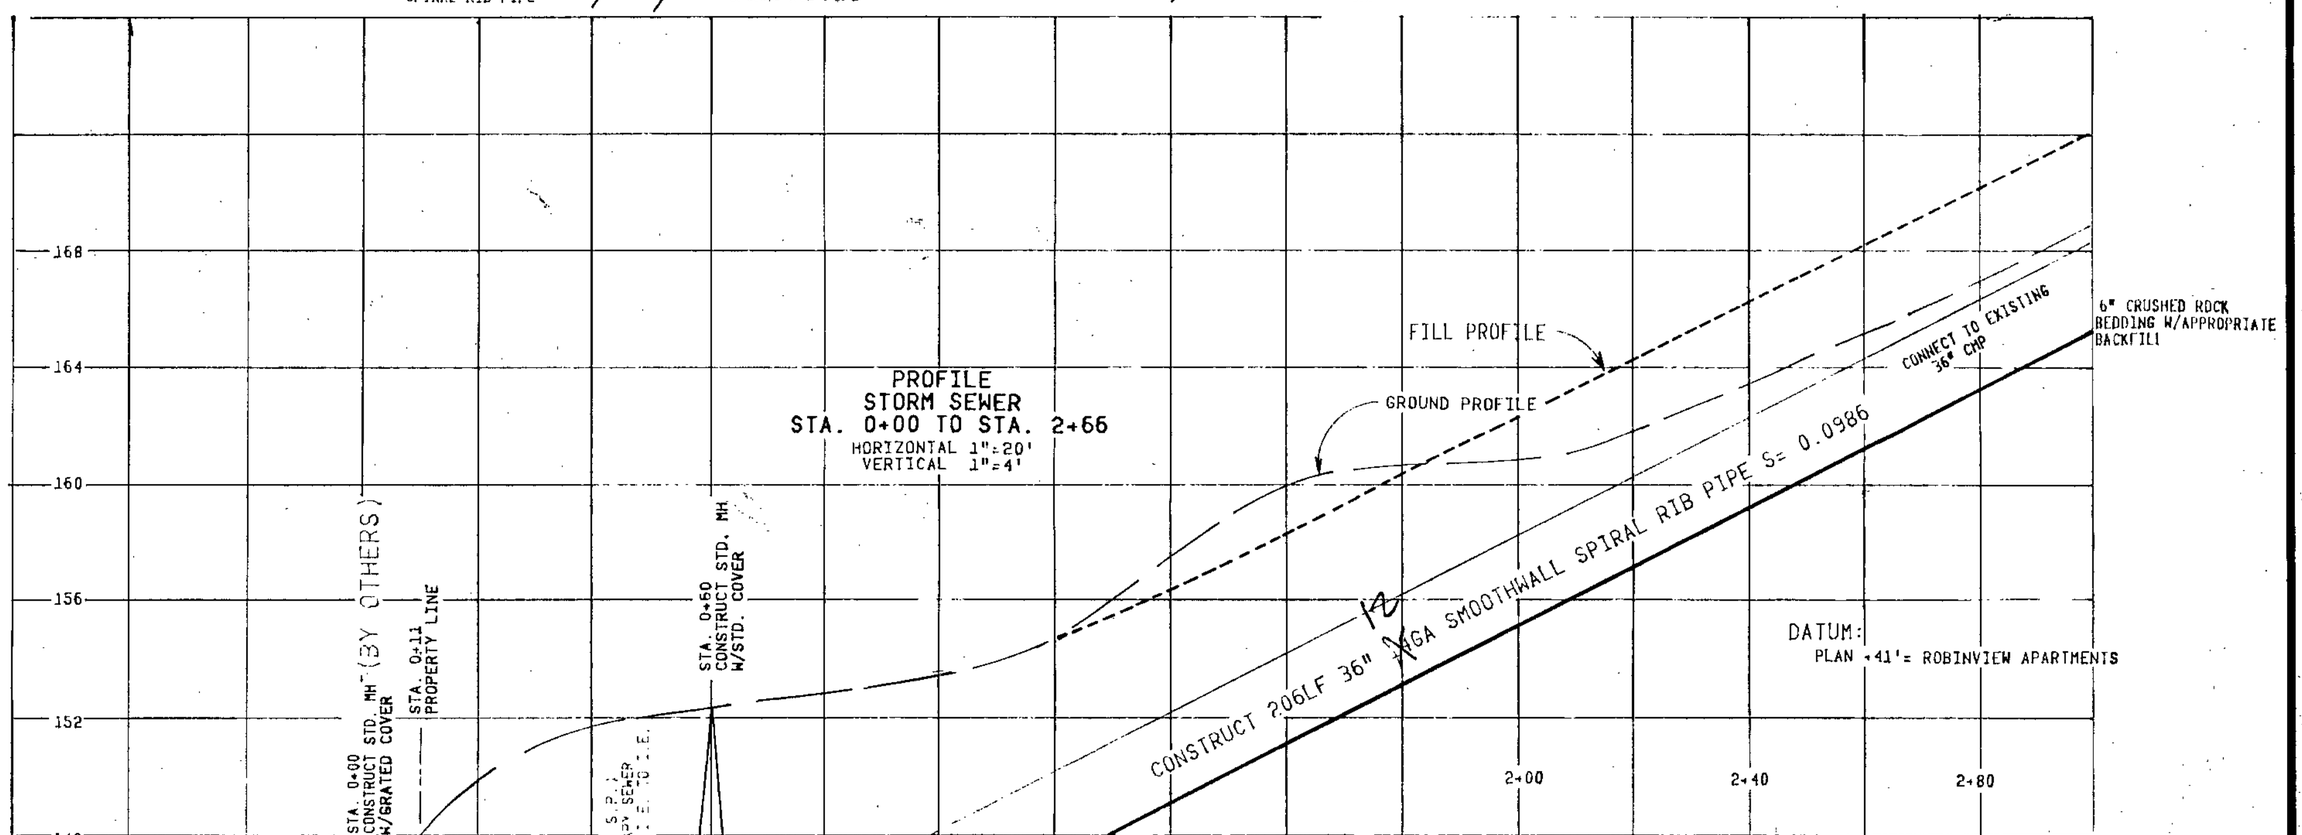

HIGHWAY 43 - STORM SEWER PROFILE

R.A. LAWRENCE & ASSOCIATES
ENGINEERS PLANNERS SURVEYORS
5001 WILLAMETTE FALLS DRIVE
WEST LINN, OREGON 97068 (503) 656-6001

DESIGN	BTA	DATE	OCTOBER 8,1987	FILE
DRAWN	BTA	CHECKED		321-03