REVISED NOVEMBER 4,1987

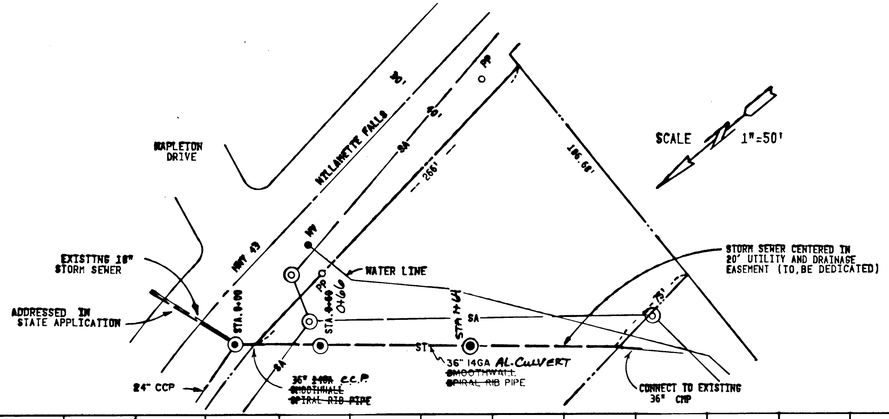

NOTE:
- GRANULAR BACKFILL REQUIRED, COMPACTED TO 95% RELATIVE DENSITY
- CONCRETE CULVERT PIPE MAY BE USED

FOR:
E.A. WEST
4344 CEDAR OAK DRIVE
WEST LINN, OREGON 97068

REGISTERED PROFESSIONAL ENGINEER 9175 OREGON AUG 21, 1987 RUSSELL A. LAWRENCE

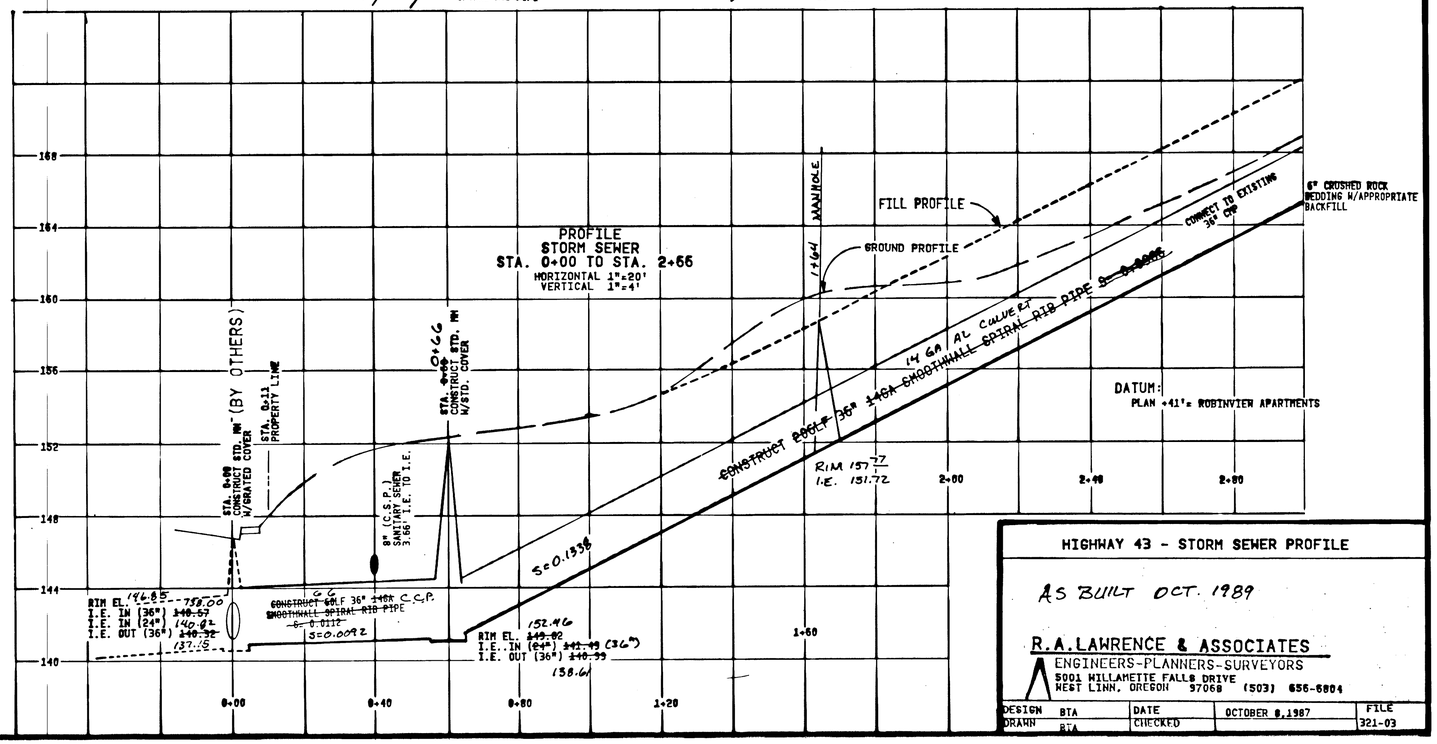

HIGHWAY 43 - STORM SEWER PROFILE

AS BUILT OCT. 1989

R.A. LAWRENCE & ASSOCIATES
ENGINEERS-PLANNERS-SURVEYORS
5001 WILLAMETTE FALLS DRIVE
WEST LINN, OREGON 97068 (503) 656-6804

DESIGN	BTA	DATE	OCTOBER 8,1987	FILE
DRAWN	BTA	CHECKED		321-03