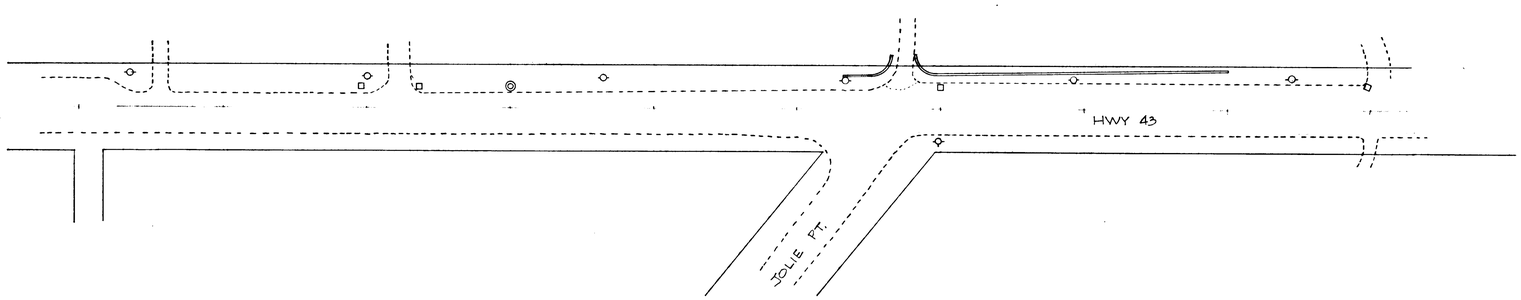

DATE	NO.	REVISION

DRAWN
FILE | DATE
SC LE

CITY OF WEST LINN

PUBLIC WORKS DEPARTMENT

HWY 43 & JOLIE PT
TURN LANE