(LATOURETTE PARK)

FURNISHED AND INSTALLED BY CITY
1-6"x6"x6" Tee
1-6" Valve

FURNISHED AND INSTALLED BY CITY
1-6"x6"x6" Tee
1-6" Valve
1-6" Plug

West 693.06

JOLIE POINT ROAD — Existing 6" Water Line

Found I.P.

Excluded from PLAT

RAINIER PLACE

DRIVE

MARQUETTE

LARSON AVE

Install: 1-6"x6"x4" Tee, 1-4" Valve

Install: 1-6"x6"x6" Tee, 1-6" Valve, 1-6" Plug

Install: 1-6"x6"x6" Tee, 1-6" Valve

Install: 1-22½° Bend, 1-11¼° Bend

Install: 1-22½° Bend, 1-11¼° Bend

Install: 1-6"x6"x6" Tee, 2-6" Valve

Install: 1-4"x4"x4" Tee, 2-4"x¾" Reducers, 2 Corp Stop

Install: 1-4"x4"x4" Tee, 2-4"x¾" Reducers, 2-Corp. Stop

Install: 1-6"x6"x6" Tee, 1-6" Valve, 1-Fire Hyd.

Install: 1-6"x6"x4" Tee, 1-4" Valve, 1-6" Valve

Install: 1-6"x6"x4" Tee, 1-4" Valve, 1-6" Tee, 1-FH

Install: 1-6"x6"x6" Tee, 1-6" Plug, 1-6" Valve

Install: 1-6"x30" Bend

6" C.I. Pipe (24.3')

6" C.I. Pipe (237')

6" C.I. Pipe (259')

6" C.I. Pipe (31.3')

4" C.I. Pipe (203')

4" C.I. Pipe (213')

TULANE STREET

COURT

RIVIERA

PLAN
Scale 1" = 50'

Notes
Construction to comply with West Linn Standards & Specs.
F.H.'s to be set As Read by City Eng. As Shown.
PROVIDE CONCRETE THRUST BLOCKS AT ALL TEES AND BENDS.

Water & Sewer Meter Box TO BE FURNISHED AND INSTALLED BY CITY.
¾" Ford Stop Hays # 5615 or Equal
¾" Copper Tubing
Corp Stop Hays # 5204 or Equal
Service connection from: 6" C.I. Pipe, 4" C.I. Pipe,

SECTION
Scale 1" = 10'

REVISION	DATE	DESCRIPTION	BY
	11/70	ADD F.H., VALVES, 4" C.I. P.P.B., PER CITY REQ.	

TURNAGAIN HOMES, INC. West Linn, Oregon

Job No. 63-21
DESIGNED BY
TRACED BY
CHECKED BY
DATE
APPROVED BY

PORTION OF JOLIE POINT ESTATES
WATER

SCALE 1" = 50' SHEET 1 OF 1

DRAWING NUMBER 63-21-1

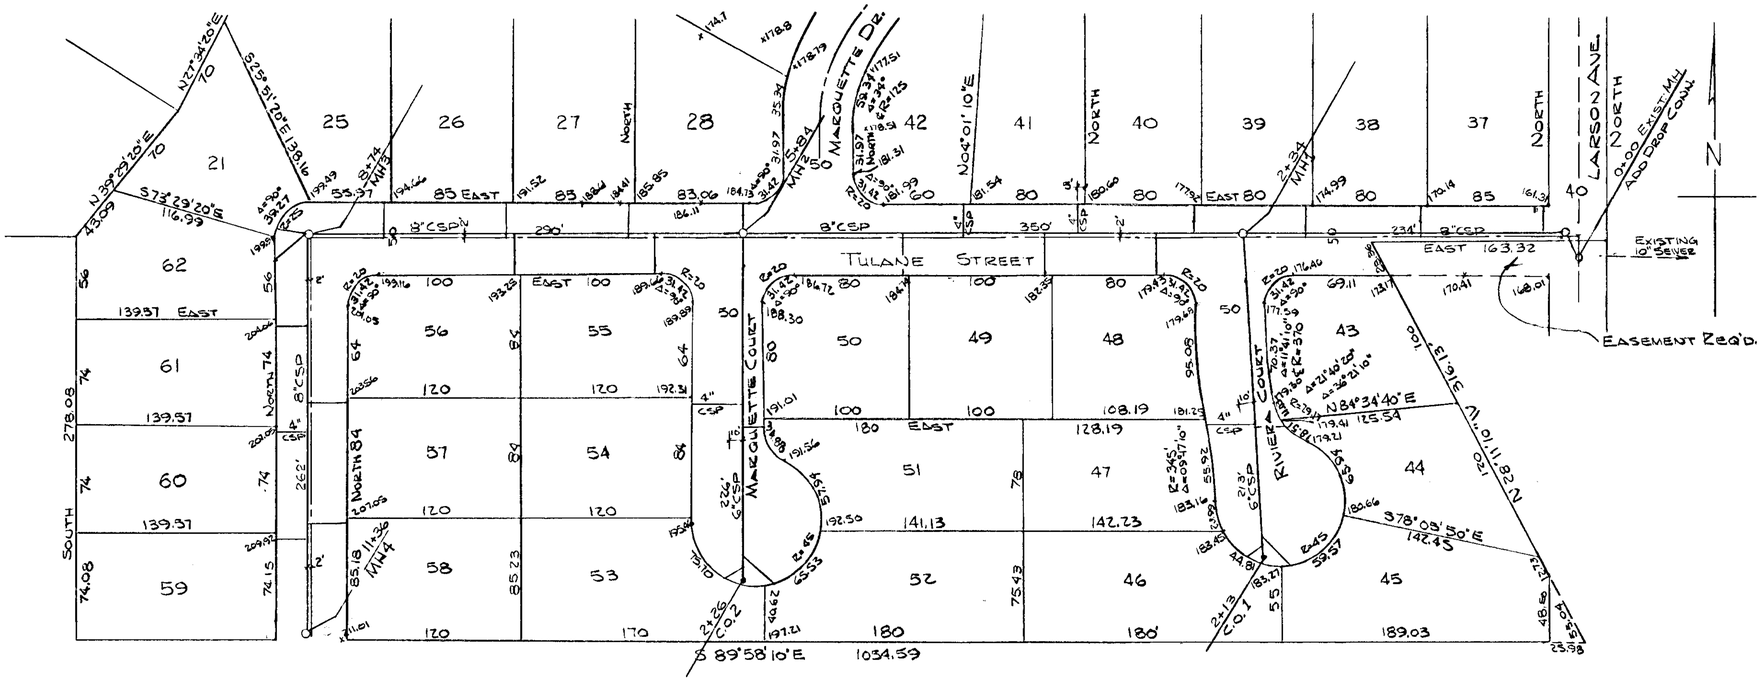

PLAN

SCALE: 1"=50'-0"

NOTE:

1. CONSTRUCTION TO COMPLY WITH WEST LINN STANDARDS & SPECIFICATIONS.
2. USE 'T' INSTEAD OF 'Y' FOR SIDE SEWER.
3. ALL SIDE SEWERS SHALL BE MARKED BY 2x4 STAKES - 12" ABOVE GROUND.
4. BACKFILL TO COMPLY WITH SW-03 EXCAVATION & BACKFILL, SEC. d, PARA. (3) & (4).
5. ALL SEWERS SHALL HAVE A MIN. DEPTH OF 5'-0".
6. SANITARY SERVICE TO LOT 29 SHALL BE BROUGHT DOWN WEST END OF LOT 31 AS A SERVICE OR DOWN MARQUETTE DR. TO JOLLIE PT. ROAD AS AN ALTERNATE.

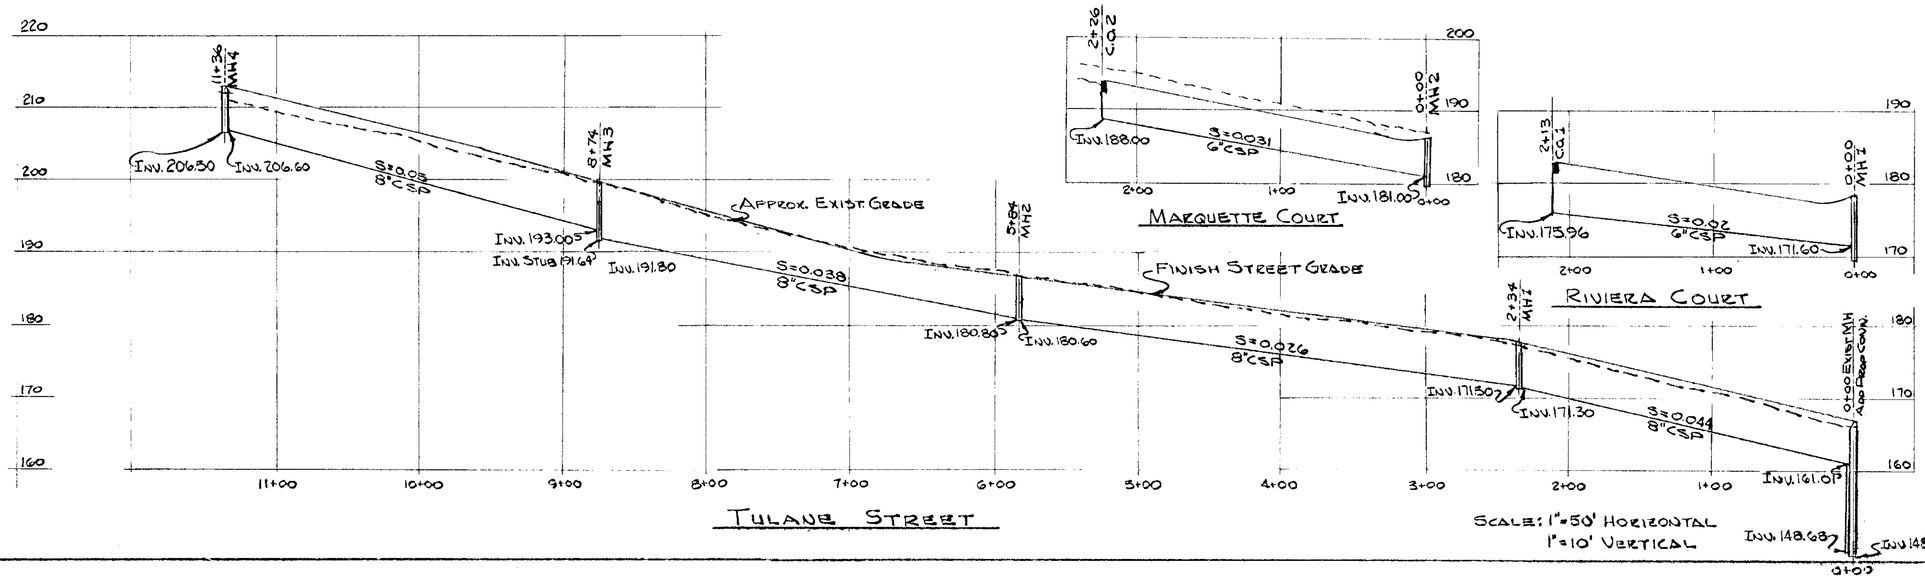

REVISION	DATE	DESCRIPTION	BY
	11/1/70	ADDED NOTE 5' MIN. DEPTH, REVISED PER CITY BY	

TURNAGAIN HOMES, INC. WEST LINN, OREGON

JOB NO.
DESIGNED BY:
TRACED BY:
CHECKED BY:
DATE APPROVED BY:

PORTION OF JOLLIE POINT ESTATES SEWERS

SCALE: AS SHOWN | SHEET 2 OF 4 | DRAWING NUMBER 53-21-2

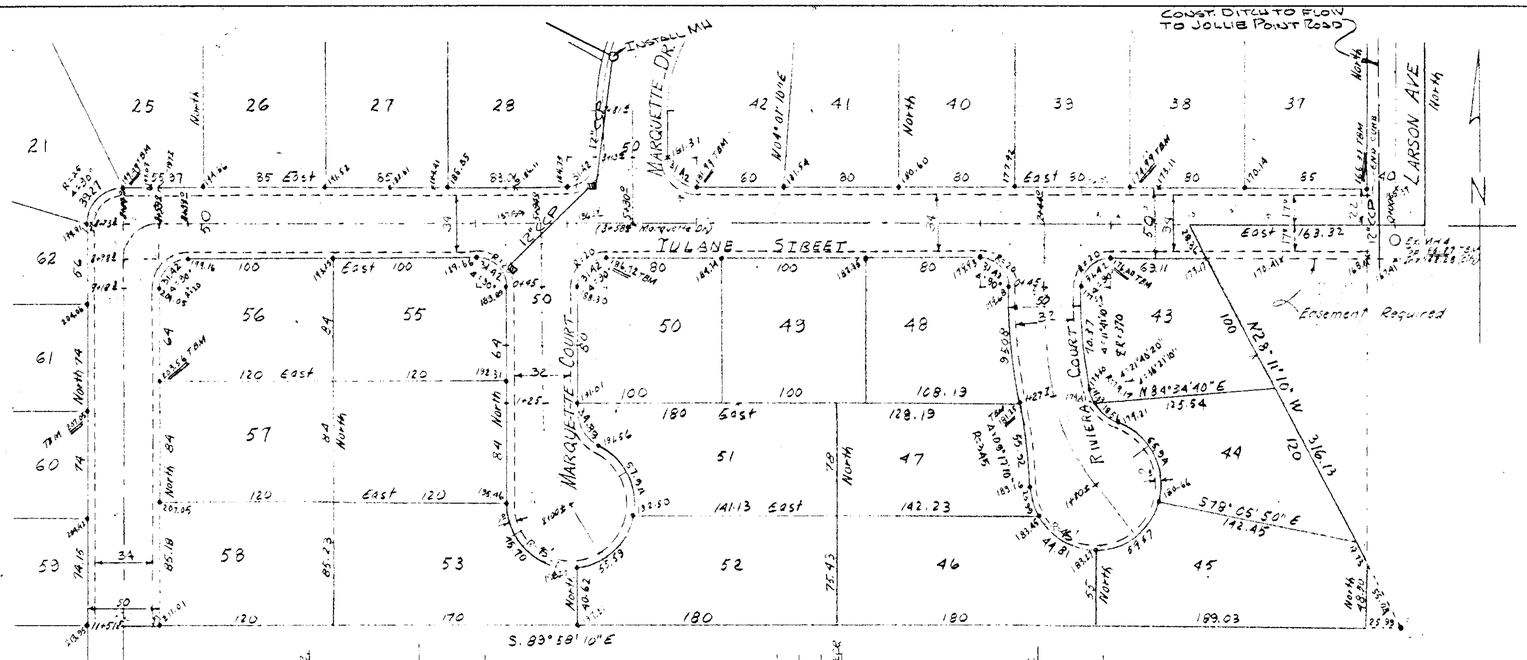

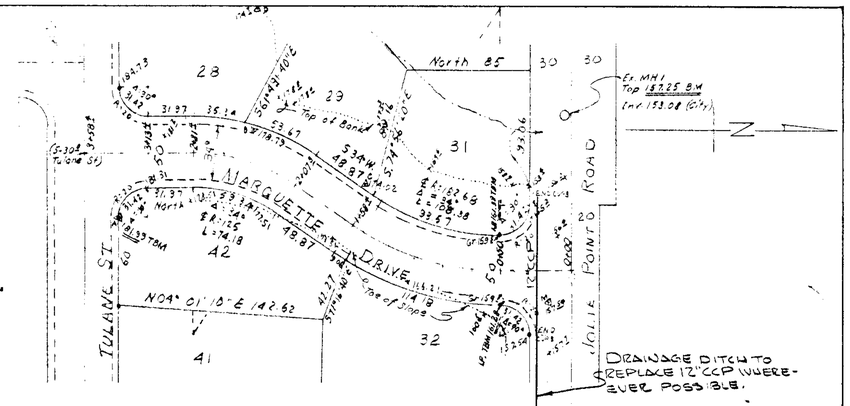

PLAN
Scale 1" = 50'

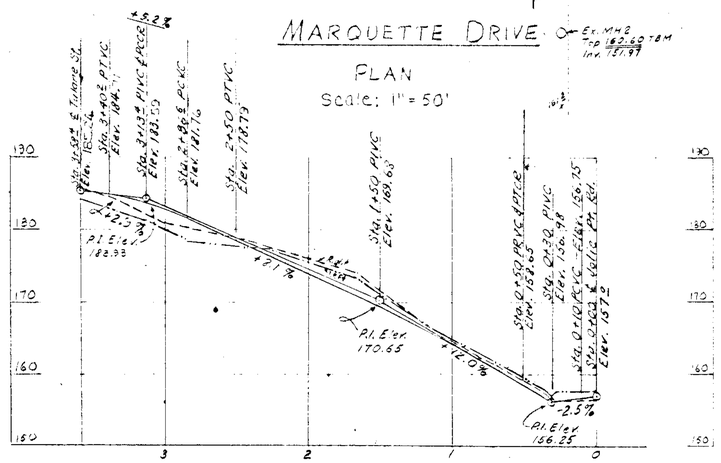

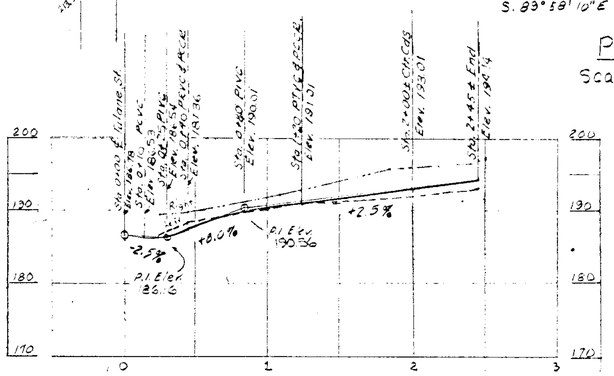

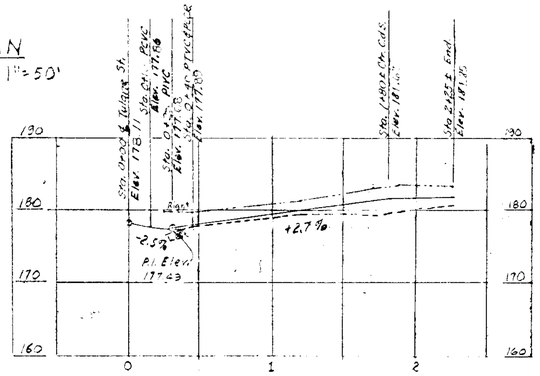

NOTE:
STORM SEWER SHALL BE DESIGNED TO CARRY 3 CFS. MIN.

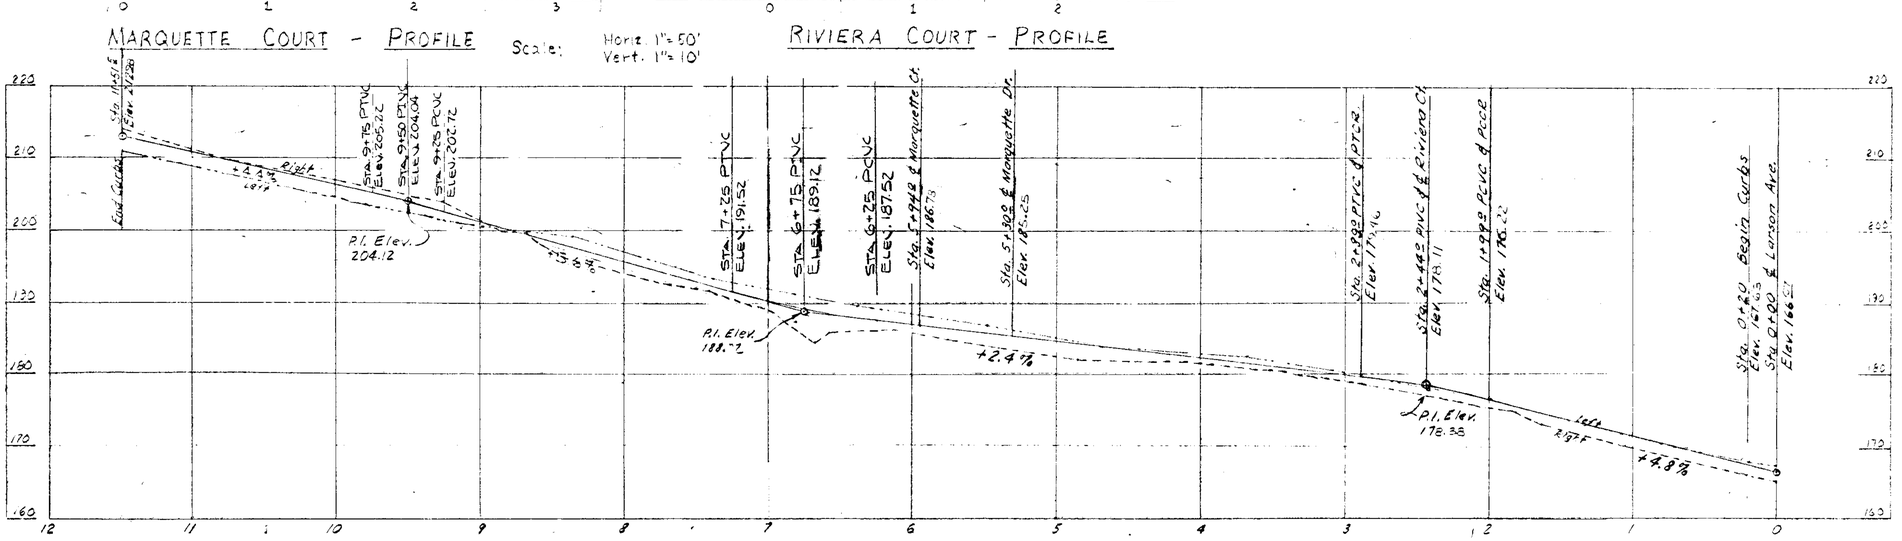

Note: Construction to comply with West Linn Standards and Specifications

REGISTERED PROFESSIONAL ENGINEER
OREGON
JULY 12, 1974
JOHN M. THOMPSON

REVISION	DATE	DESCRIPTION	BY
	11/1/80	ADD STORM DRAIN, NOTE, STREET W. LIMITS & PROFILE	

TURNAGAIN HOMES, INC. — West Linn, Oregon

JOB No. 63-21
DESIGNED BY:
TRACED BY:
CHECKED BY:
DATE:
APPROVED BY:

PORTION OF JOLIE POINT ESTATES STREETS

SCALE: AS SHOWN | SHEET 3 OF 4 | DRAWING NUMBER 63-21-3

BLAIR STATIONERY & PRINTING CO. PORTLAND, ORE.

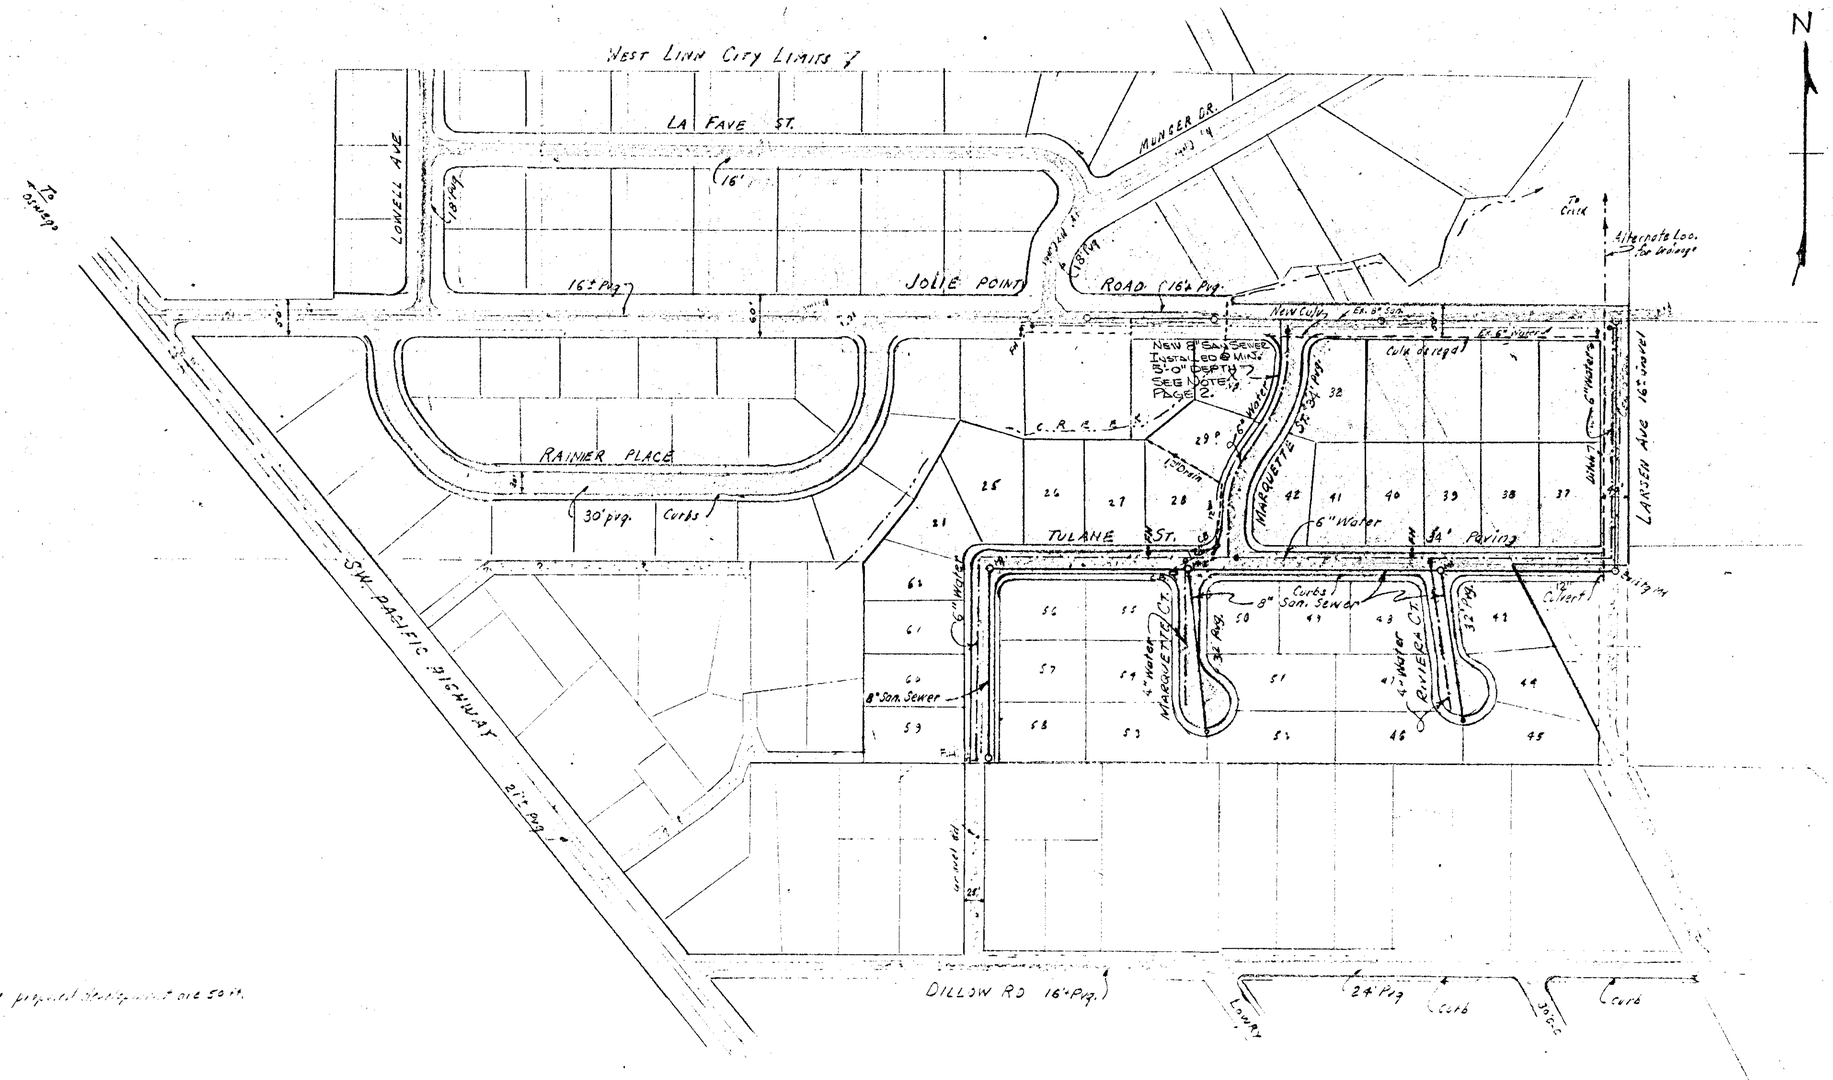

All street widths in the proposed development are 50'.

PLAN OF JOLIE POINT AREA
GENERAL LAYOUT

Scale 1"=100'

Note: W. [illegible] to be Abandoned

Symbols

	Existing	Proposed
Sanitary Sewer		
Storm Sewer	- - - - - -	- - - - - - -
Water Main	—·—·—	—·—·—

REGISTERED PROFESSIONAL ENGINEER 6211 OREGON JULY 12 1968 DUANE M. THOMPSON

REVISION	DATE	DESCRIPTION	BY
	11/1/70	REVISE STORM DRAIN AND 4" WATER LINE TO LOT #23	
	Nov 21	Street Widths changed to Council Order	H.T.
	Nov 21	Added Storm Drain, Water, Storm & Res.	H.T.

Thurston Hinds, Jr. — West Linn Oregon

JOB No. 18.2.21
DESIGNED BY:
TRACED BY:
CHECKED BY:
DATE:
APPROVED BY:

GENERAL PLAN
JOLIE POINT ESTATES

SCALE As Shown | SHEET 4 OF 4 | DRAWING NUMBER 63-21-3a