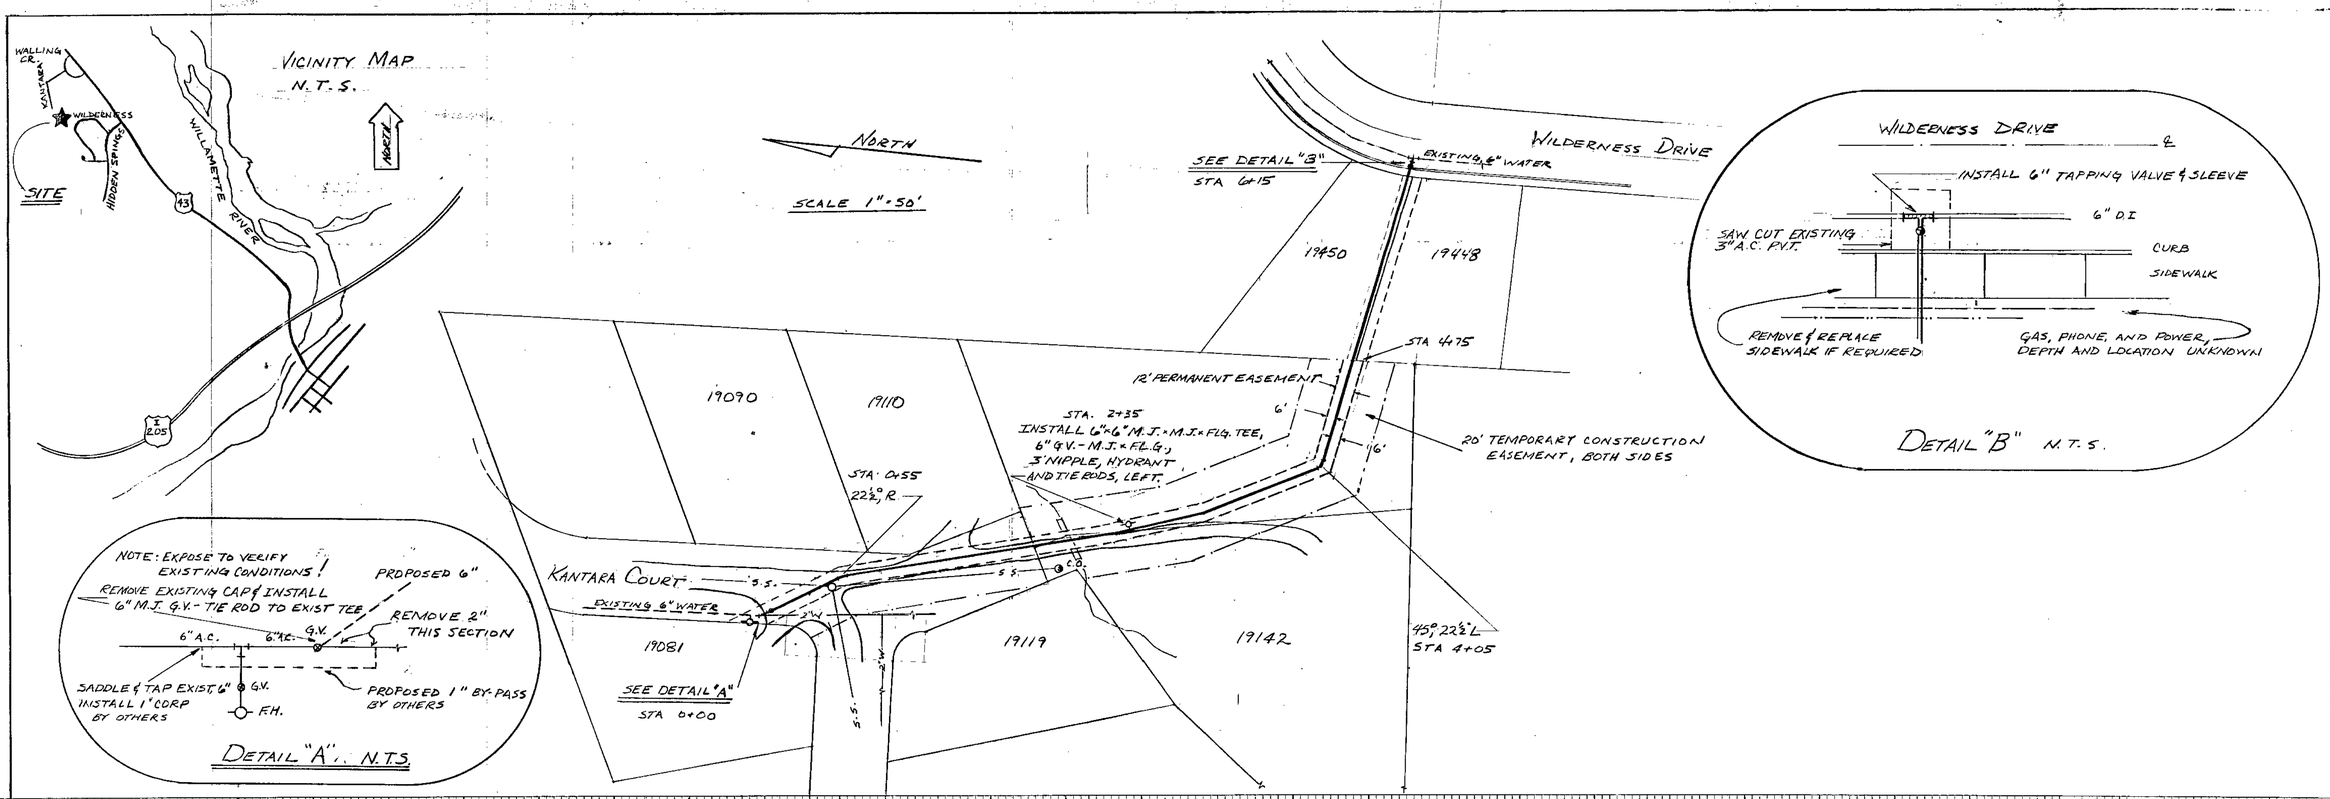

TRADE STANDARD MARK 100% RAG PAPER CROSS SECTION 10 X 10 PRINTED IN U.S.A.
KEUFFEL & ESSER CO. NEW YORK.
TRADE STANDARD MARK 100% RAG PAPER CROSS SECTION 10 X 10 PRINTED IN U.S.A.
KEUFFEL & ESSER CO. NEW YORK.