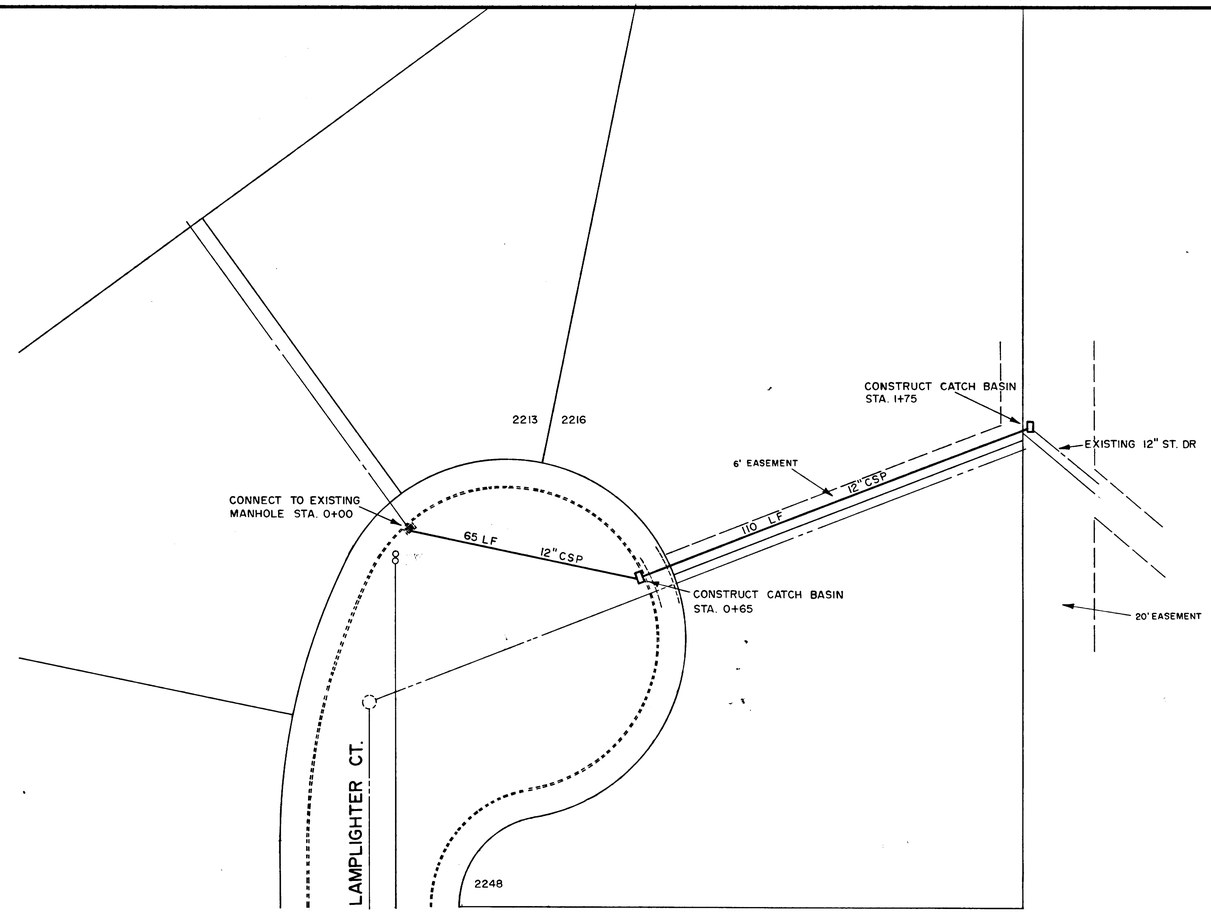

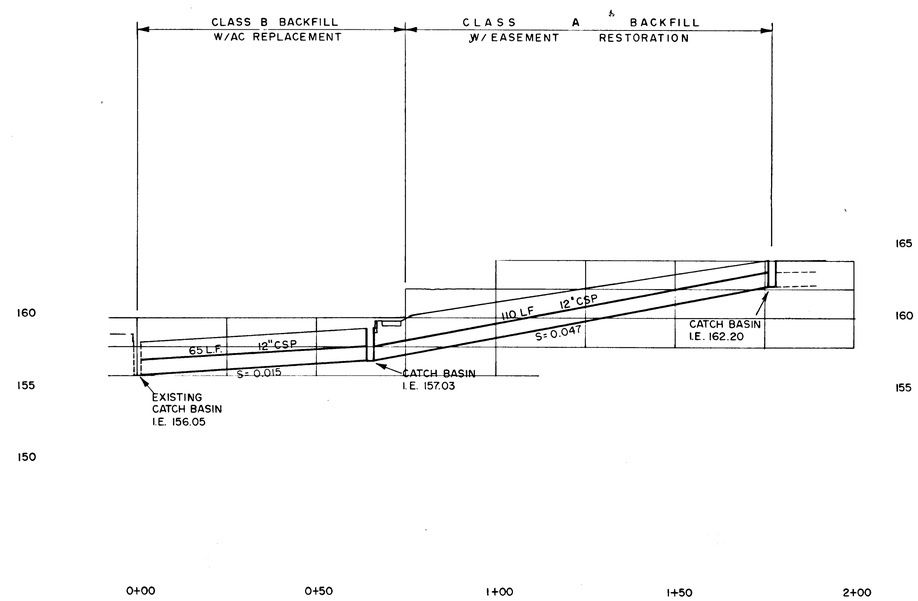

DATE	NO.	REVISION	DRAWN JWM		
			FILE	DATE 7-1-86	
			SC LE		

CITY OF WEST LINN

PUBLIC WORKS DEPARTMENT

LAMPLIGHTER COURT
STORM DRAIN IMP.

1