GENERAL NOTES

1. All materials and construction to be in conformance with City of West Linn Public Works Standards.
2. Elevations to City of West Linn Datum. Site T.B.M. R.R. spike in N.W. corner of 24" Oak on South side of Lazy River Rd. 150' East of Willamette Dr. opposite "Kinder Kare". Elevation 165.49.
3. Sanitary sewer service to be 4" PVC ASTM D3034 SDR35 with 3/4"-0 crushed rock bedding and backfill compacted to 95% of optimum density.
4. Water main to be D.I. Class 52 pipe with slip on joint, min. 3' cover to finished grade. Backfill with 3/4"-0 crushed rock compacted to 95% of optimum density.

CONSTRUCTION NOTES

1. Sta 2+39, 16' LT. Proposed 4" san. sewer tap 8" inv. 154.0. Verify sewer main material prior to construction. Tapping saddle to meet City standards. (FOWLER SADDLE TAP)
3. Sta. 2+13, 15' RT. Remove existing 2" blow off assembly. Verify exist. 8" water main material and connect new 8" D.I. Class 52 pipe.
4. 2+50, 15' RT. Install new 2" blow off assembly on tapped 8" plug. Restrain plug with concrete straddle block. See Detail.
5. Install 1" Type "K" copper water service. Locate meter box behind sidewalk clear of driveway, installation as per City of West Linn standards.
6. Sawcut exist. A.C. edge and tack coat.

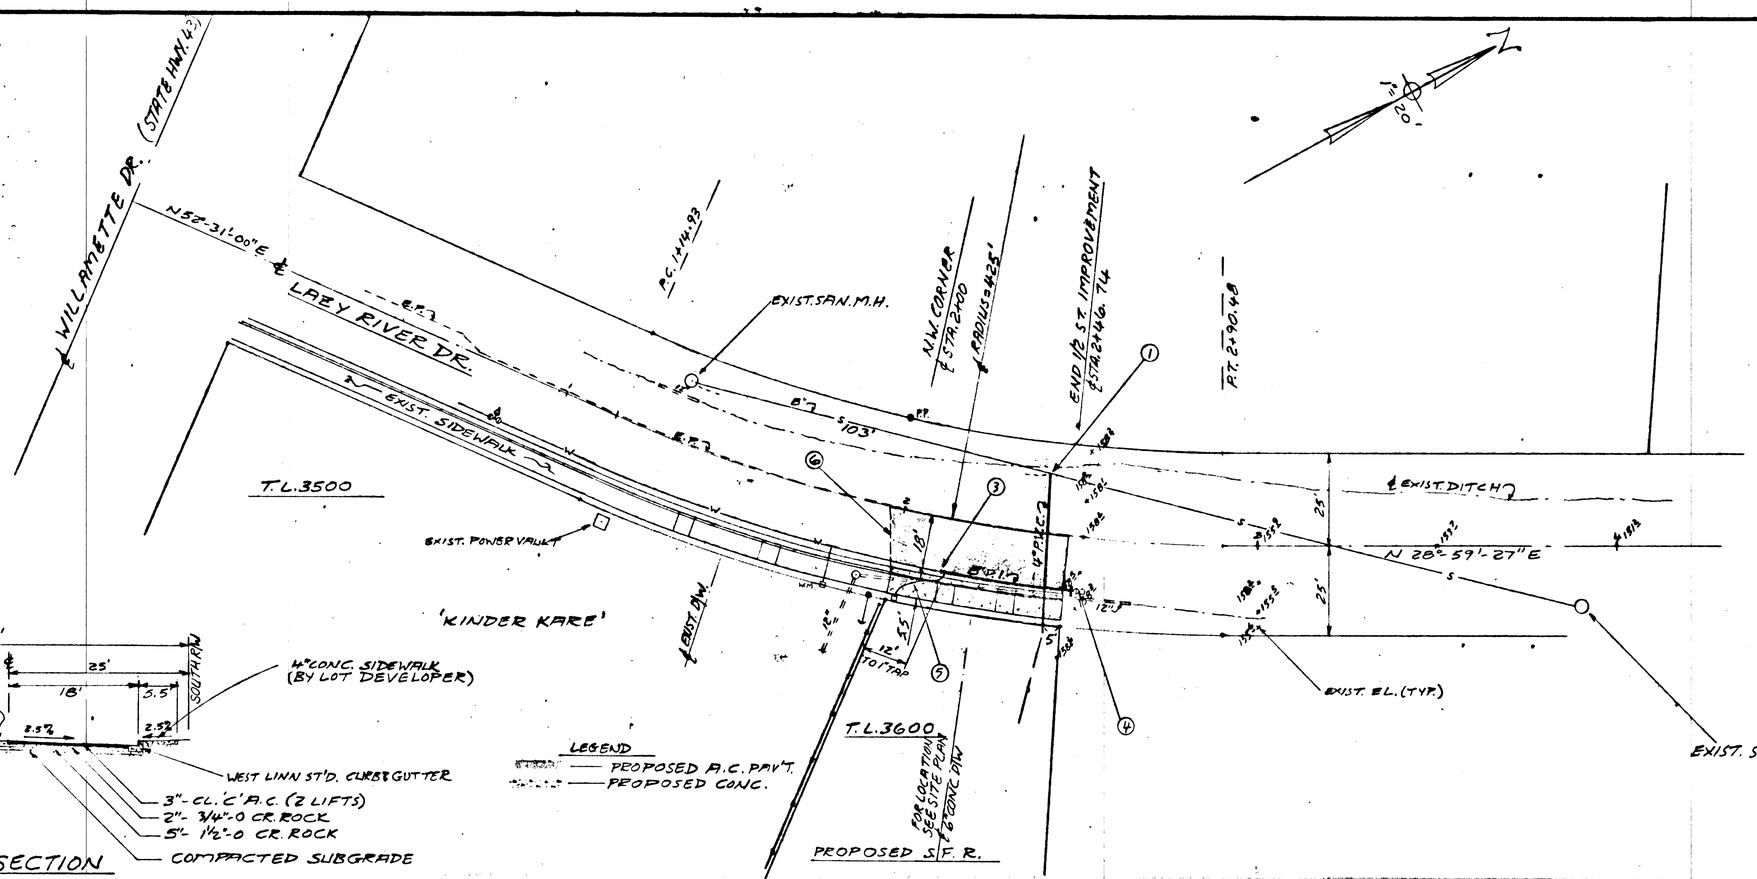

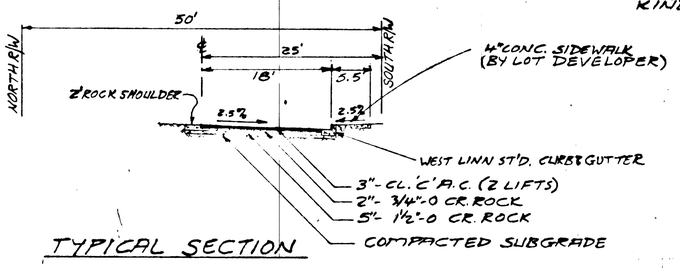

TYPICAL SECTION

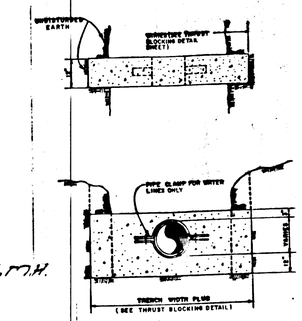

STRADDLE BLOCK DETAIL

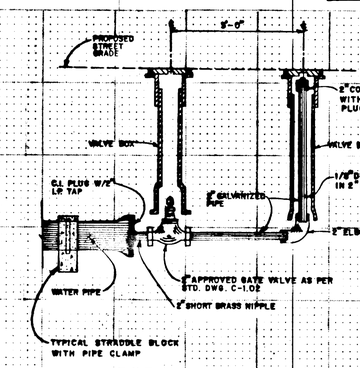

2" BLOWOFF DETAIL

NOTE:
AS-BUILT INFORMATION SUPPLIED BY CONTRACTOR, TIMBERLINE DEVELOPMENT 656-8253. T.M. 7-12-89

REVISIONS		
Date	Description	By
7-12-89	AS-BUILT INFO ADDED	J.M.

DRAWN: J.M. | CHECKED: R.G.T.
SCALE: 1"=20' | DATE: 2-22-89

ZAROSINSKI-TATONE ENGINEERS, INC.
3737 S.E. EIGHTH AVE. PORTLAND, ORE.

T.L. 3600 LOCATED IN S.E. 1/4 SEC. 14 T. 2S., R. 1E., W.M. G.W. WALLING D.L.C. CITY OF WEST LINN, CLACKAMAS CO. OREGON

REGISTERED PROFESSIONAL ENGINEER 9002 OREGON JANUARY 18, 1978 JAMES MADDOCK

LAZY RIVER DRIVE 1/2 STREET IMPROVEMENT

JOB # 3603

1/1