REVISIONS				
ZONE	REV	DESCRIPTION	DATE	APPROVED

SCALE IN FEET

0 2.5 5 7.5 10 12.5

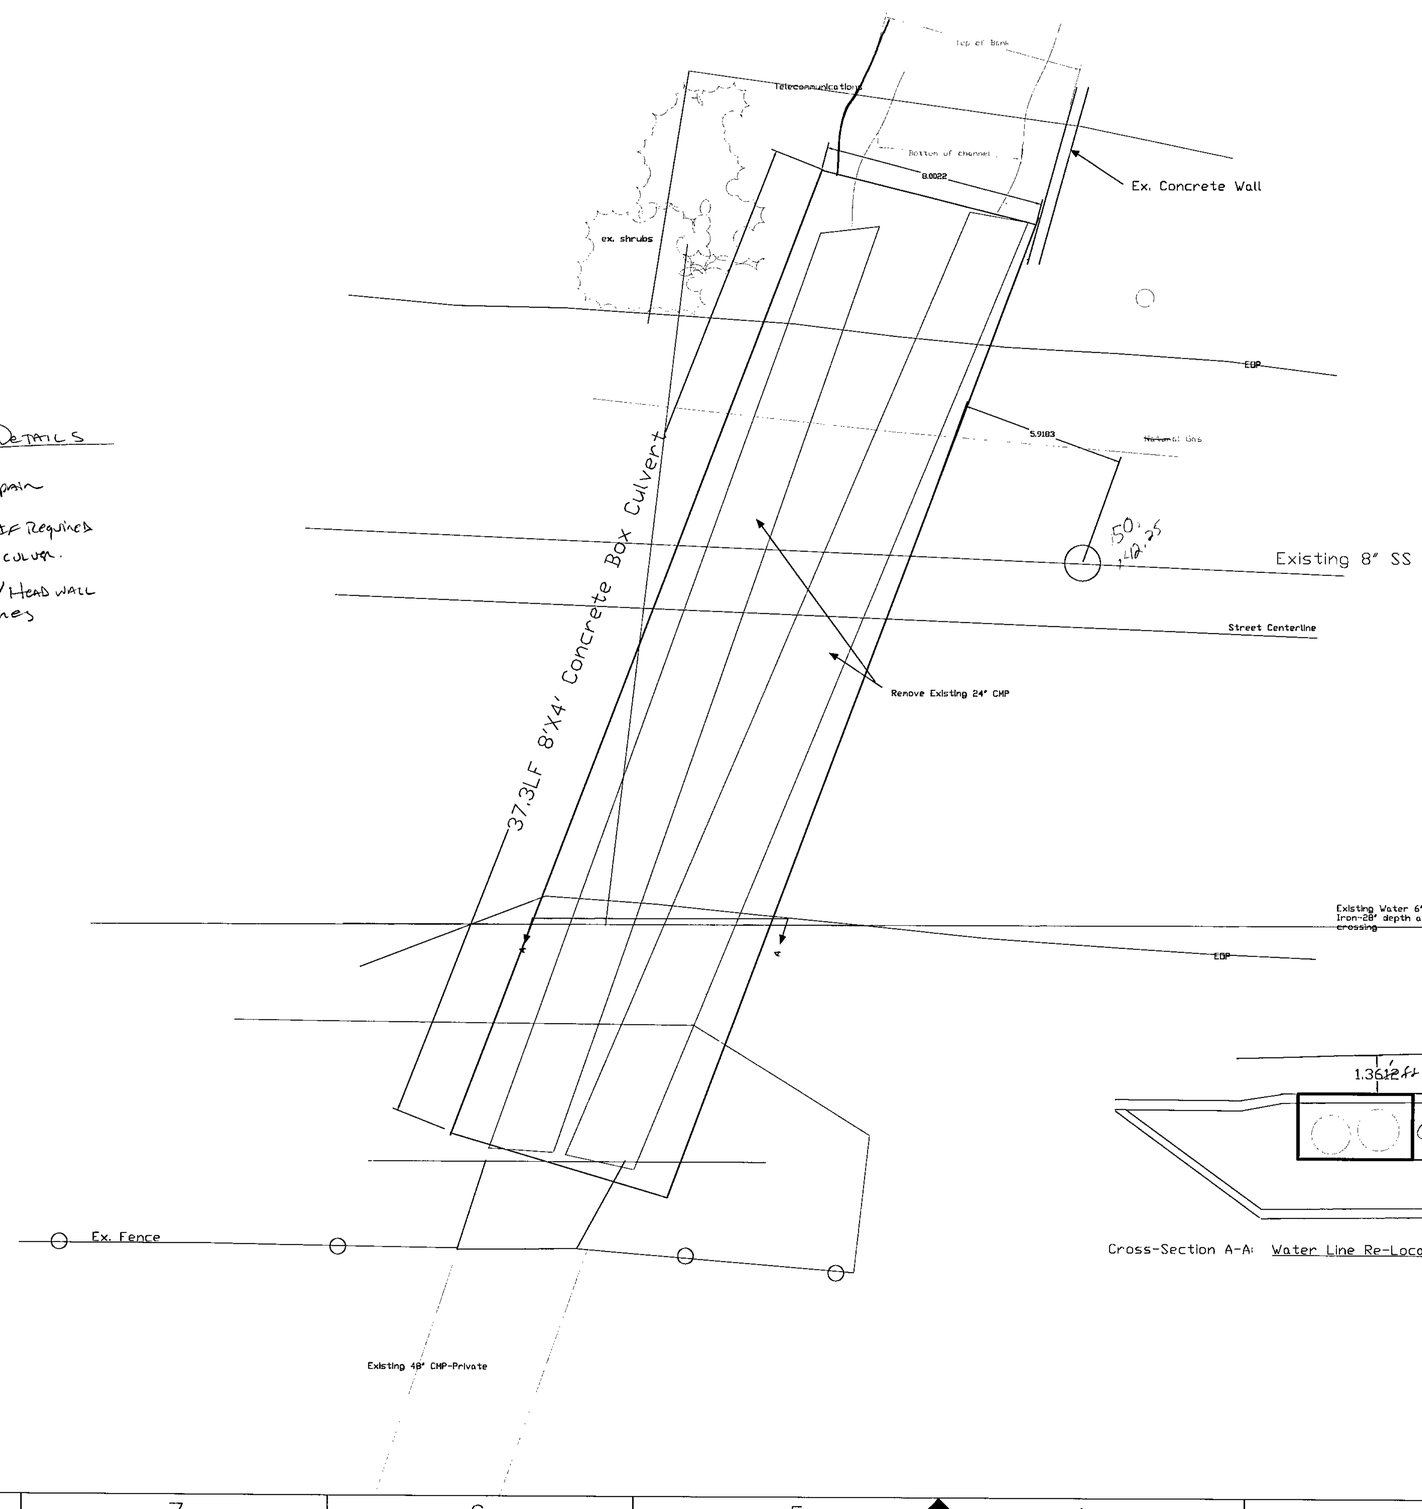

Required Details

- Street Repair
- Footing if Required for Box culvert.
- End wall / Head wall structures

Notes

1. Stream Flow By-pass: Coffer Dam shall be installed upstream of inlet. Direct Stream flows thru exist culvert as avail. thru. Etz —
2. Remove Existing CMP, including demo of concrete headwall, end wall structures,
3.

Lock In prop. corners —

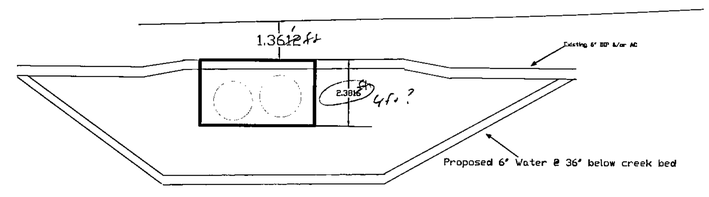

Cross-Section A-A: Water Line Re-Locate

PW0112-Mapleton Storm

SIZE	FSCM NO.	DWG NO.	REV
SCALE		SHEET	

REVISIONS				
ZONE	REV	DESCRIPTION	DATE	APPROVED

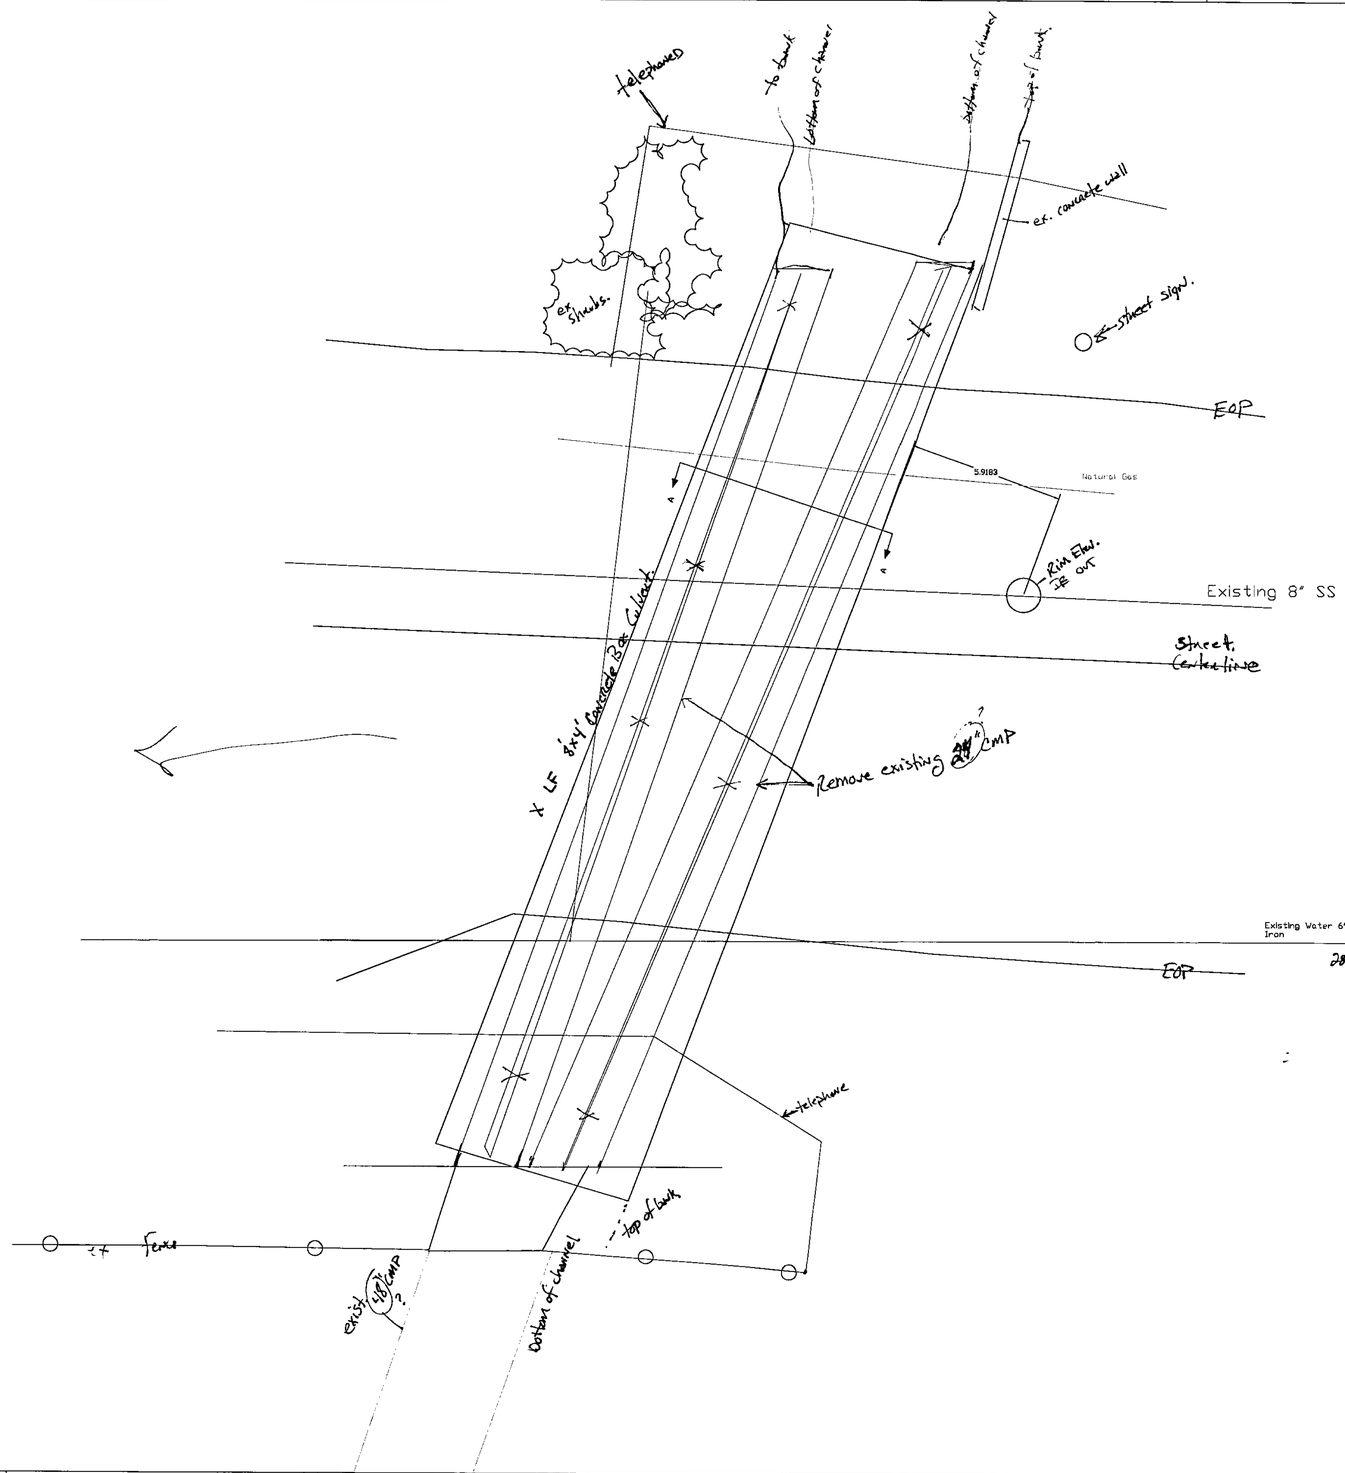

scale?
North Arrow.

Crosssection A-A

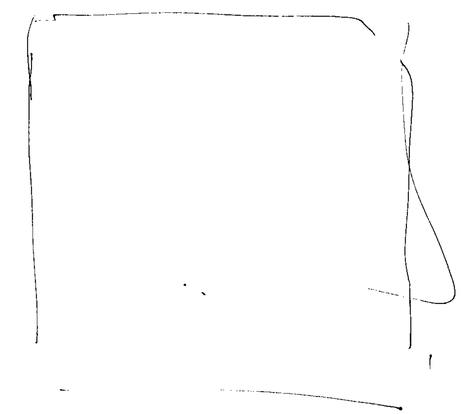

28" depth @ culvert crossing

GET SCALE

MAPLETON CULVERT REPLACEMENT

SIZE	FSCM NO.	DWG NO.	REV
		PW0112	
SCALE		SHEET 1/2	