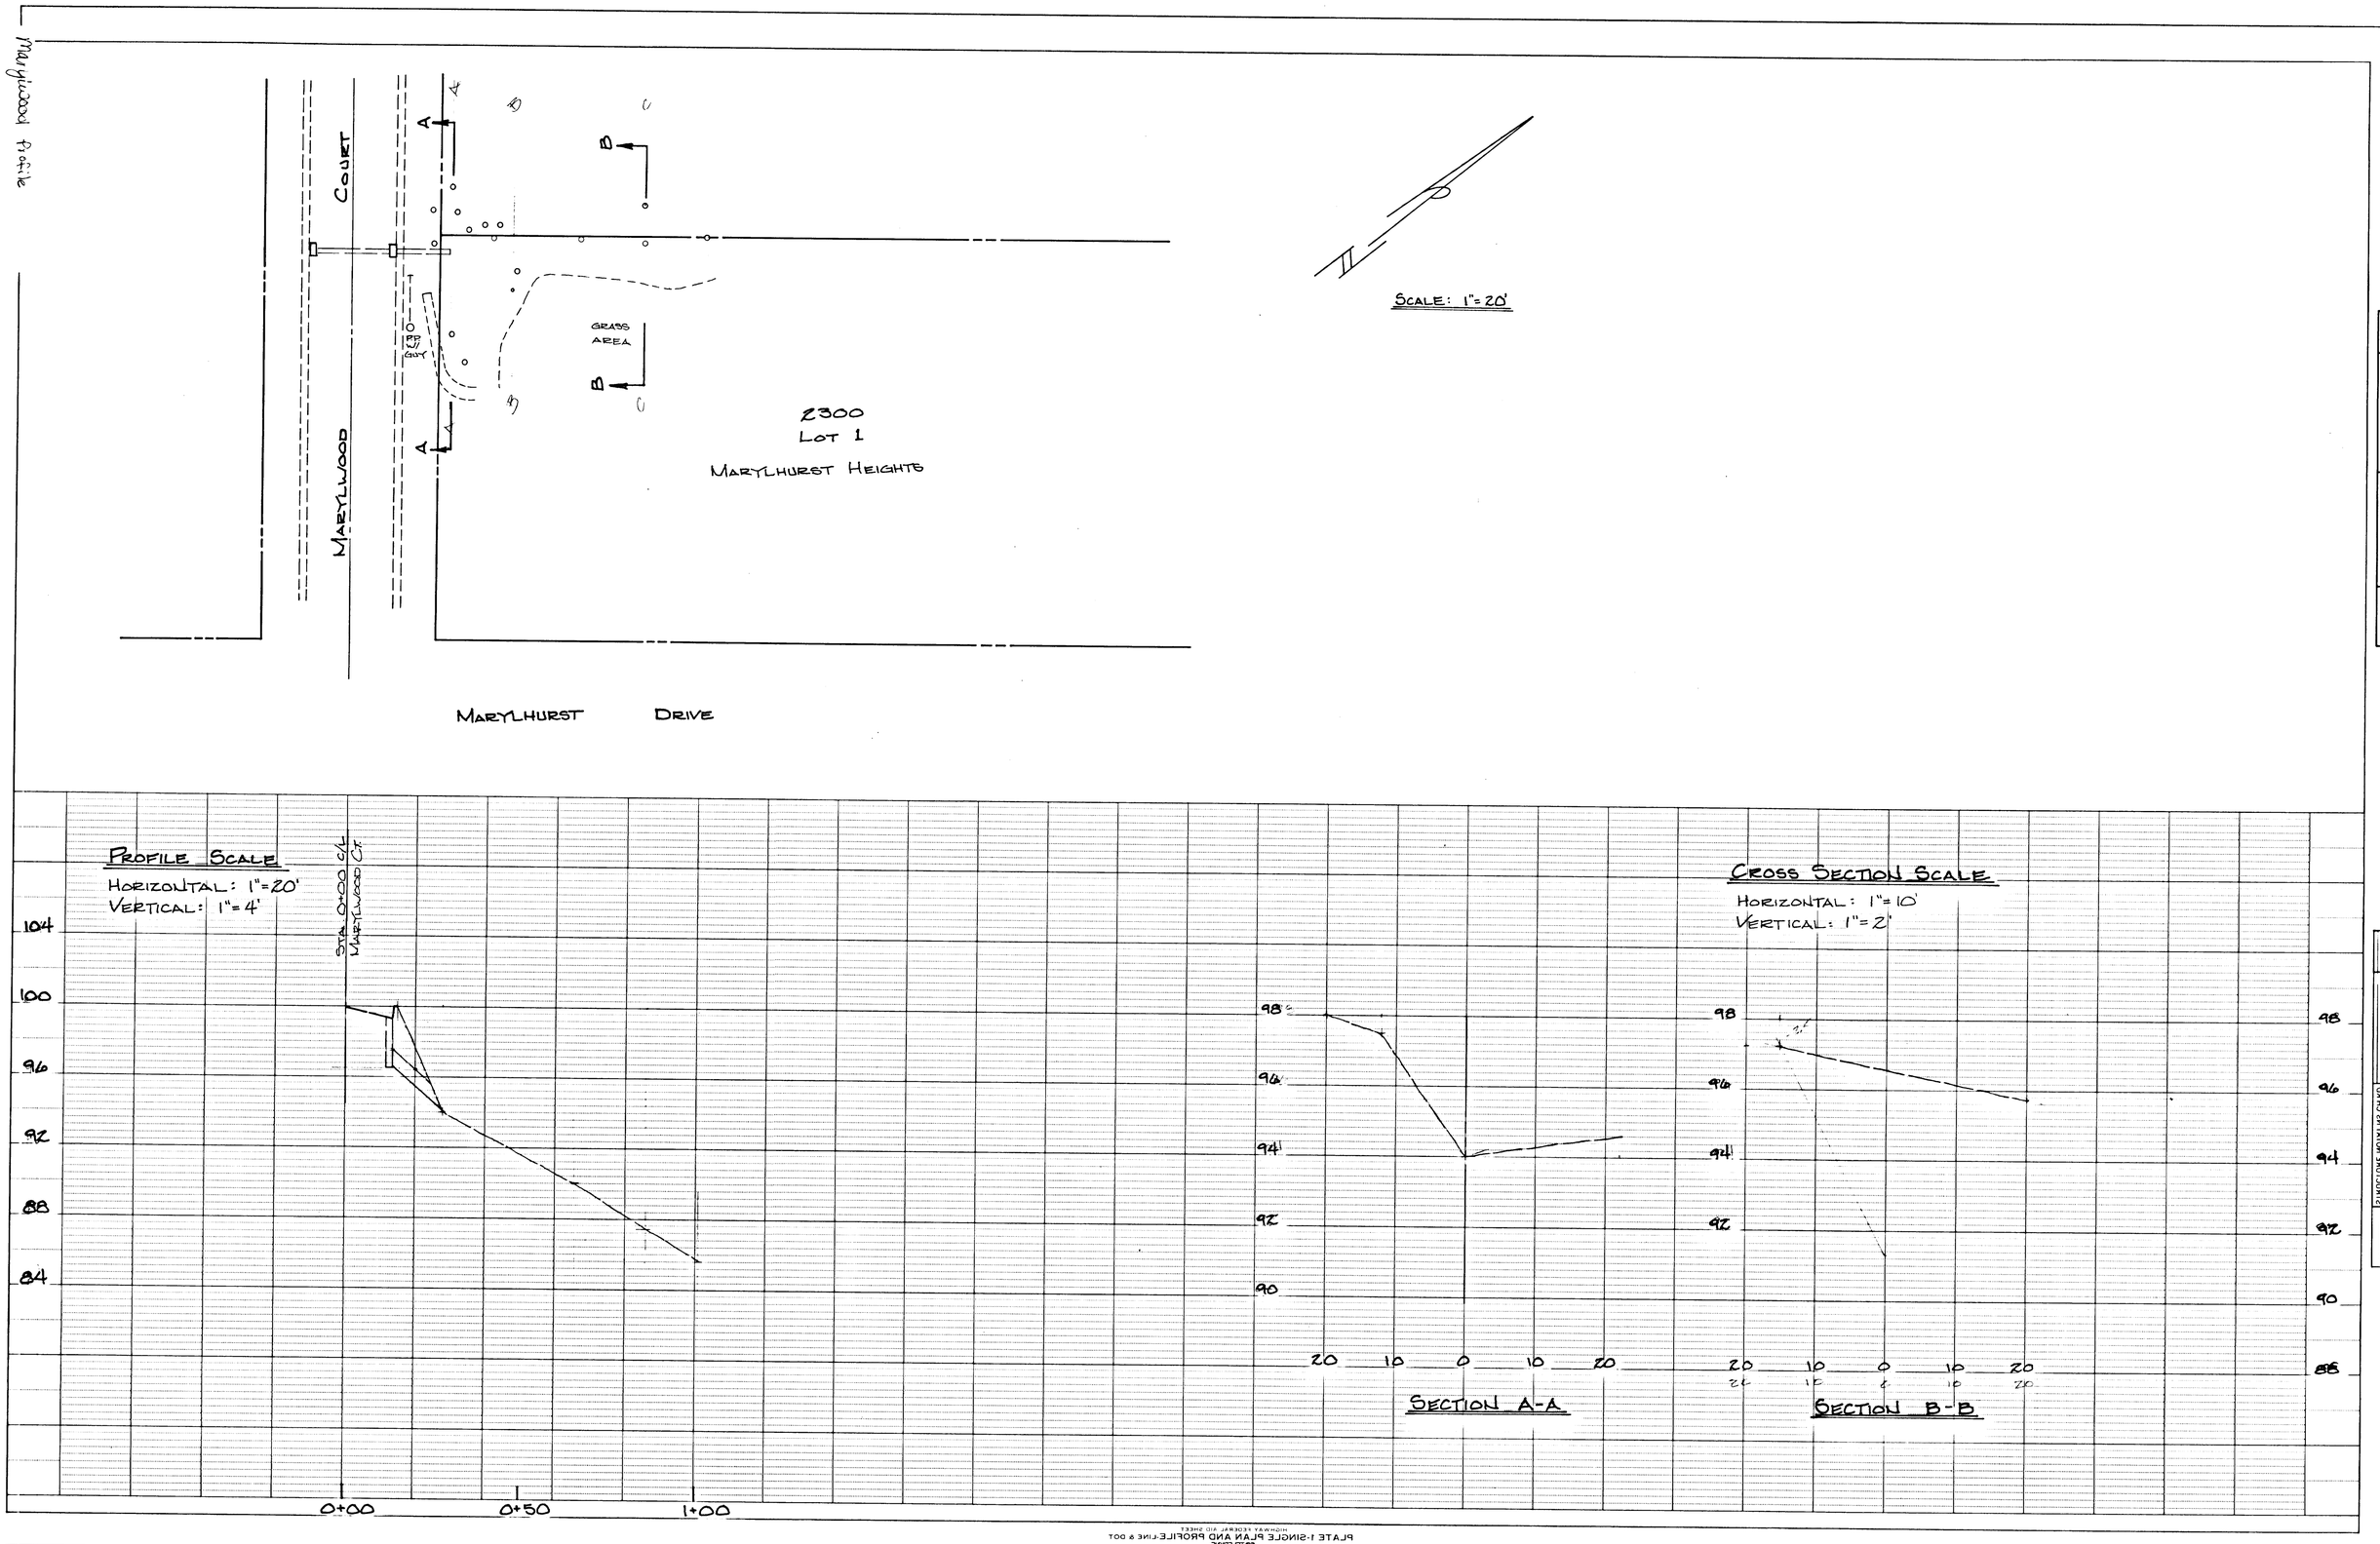Marylwood Profile