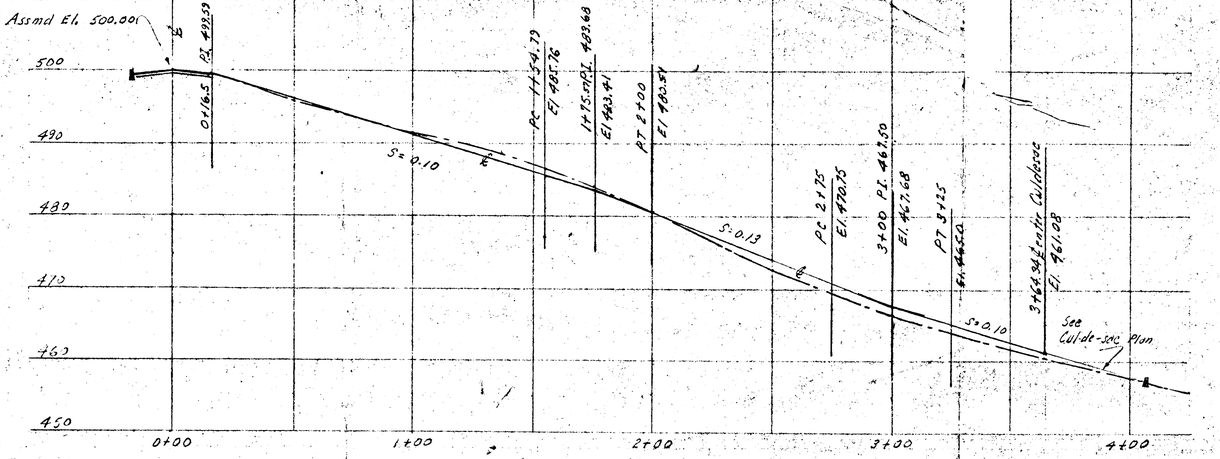

PROFILE ℄
1" = 30' Horiz.
1" = 10' Vert.

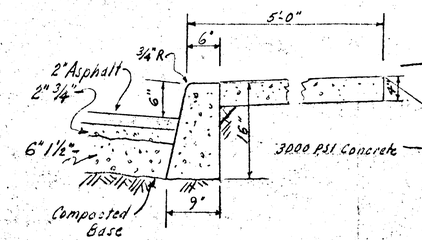

CURB, WALK & PAVING

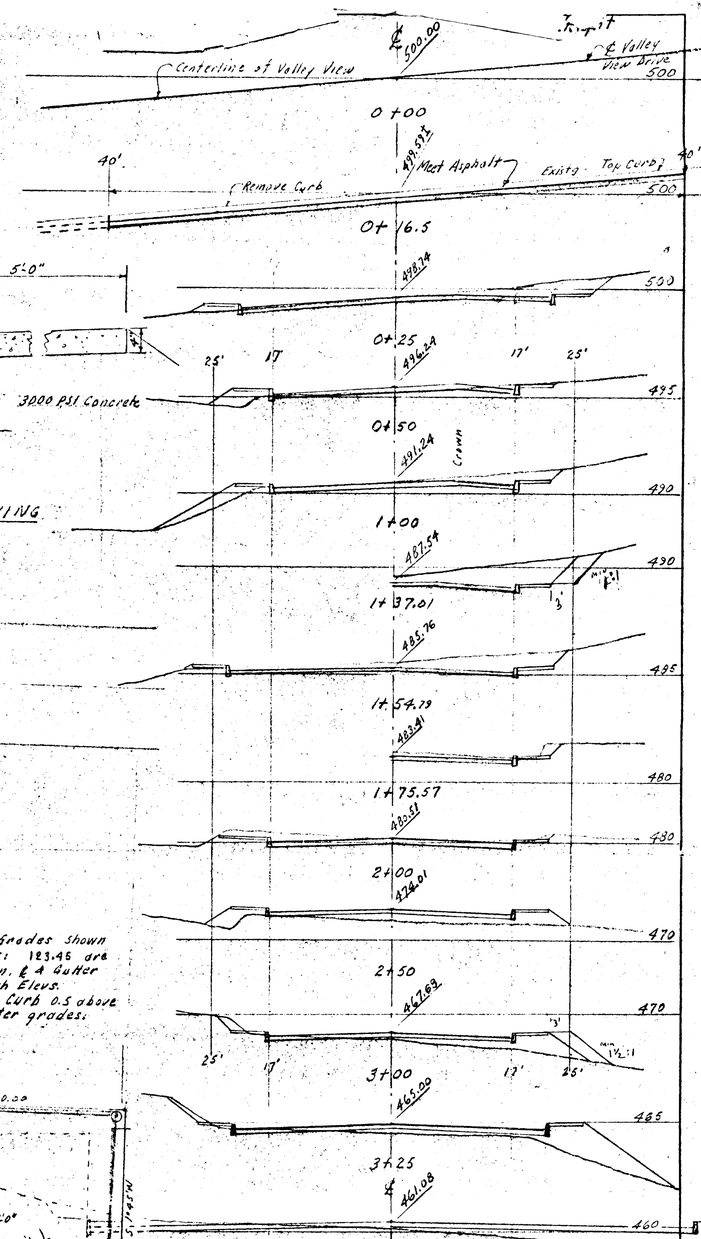

SECTIONS
1" = 10'

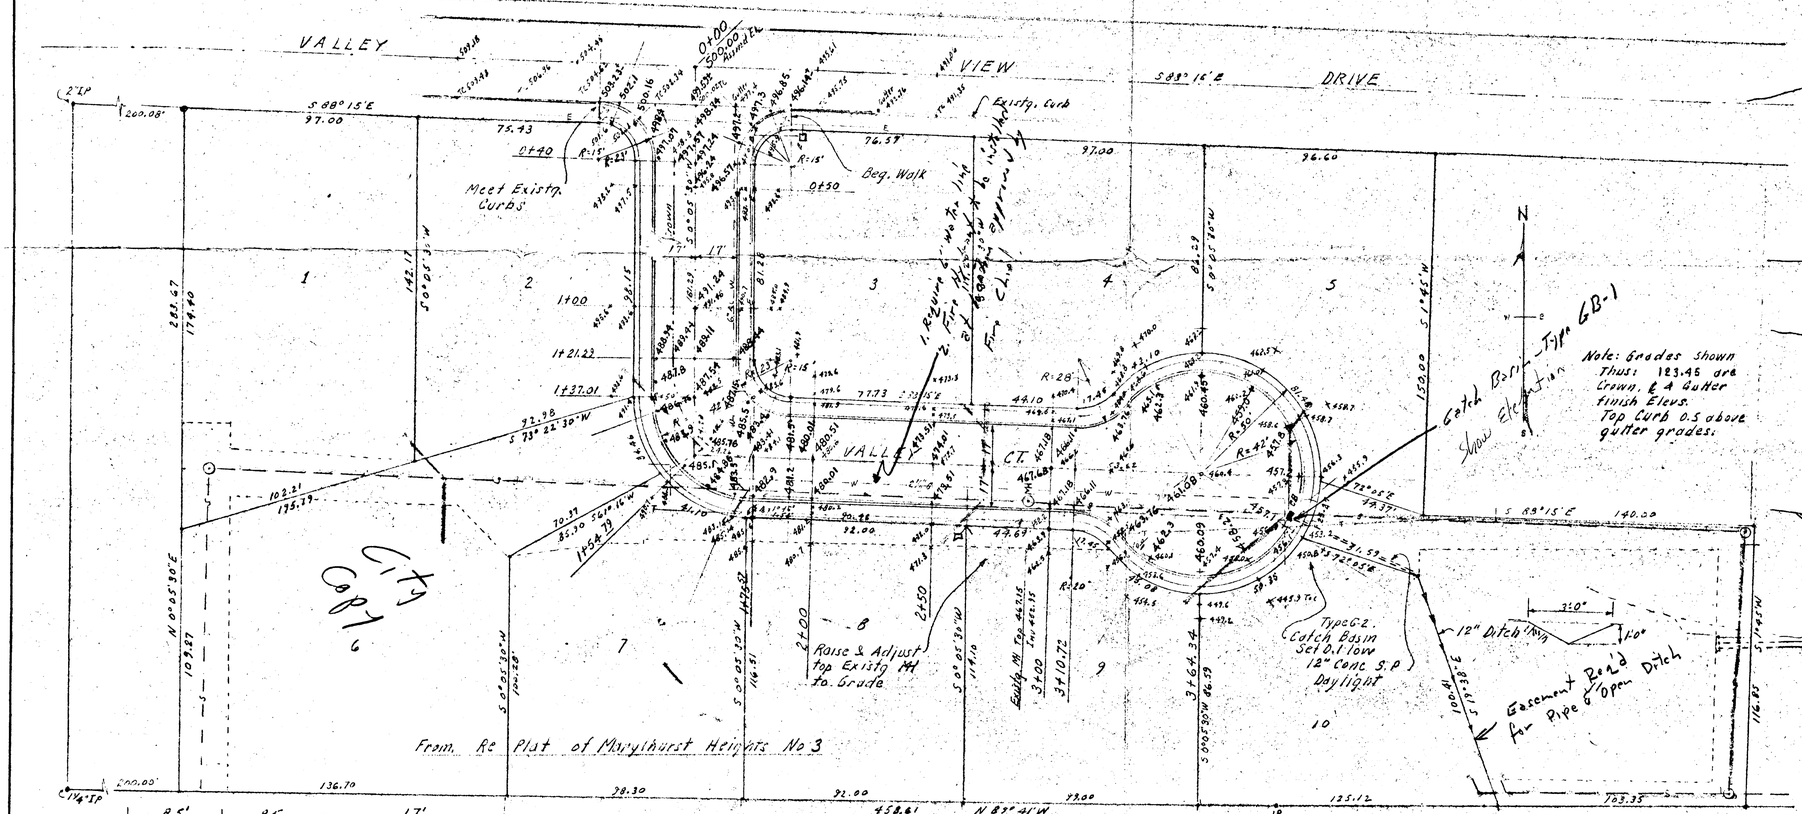

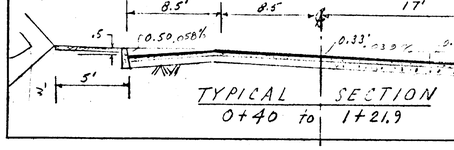

TYPICAL SECTION
0+40 to 1+21.9

PLAN
VALLEY COURT
1" = 30'
Located In NW. 1/4 Sect 23, T. 2S., R. 1E., W.M.

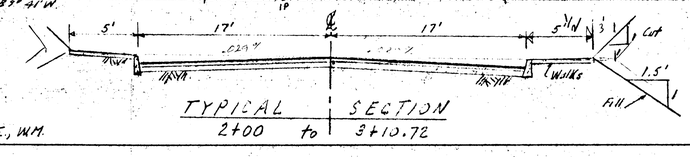

TYPICAL SECTION
2+00 to 3+10.72

REGISTERED PROFESSIONAL ENGINEER 3685 OREGON MAY 7, 1968 HOMER V. TUNKS

REVISION	DATE	DESCRIPTION	BY

LARRY WOODRUM — WEST LINN, ORE.

JOB No. 73-11
DESIGNED BY H.V.T.
TRACED BY —
CHECKED BY H.V.T.
DATE July 12, 1973
APPROVED BY W. J. Dorner

STREET IMPROVEMENT
VALLEY COURT
MARYLHURST HEIGHTS
WEST LINN OREGON

SCALE As Shown — SHEET 1 OF 1

W. J. DORNER
CONSULTING ENGINEER
PORTLAND OREGON

DRAWING NUMBER 73-11-1

Tentative approval granted subject to notations; compliance with city specs and also subject to detailed analysis.

C. R. Sanders
7-20-73

VALLEY CT

BAR STATIONERY & PRINTING CO., PORTLAND, ORE.

Second Scan

This As-Built was scanned twice due to illegibility issues of the original scan.

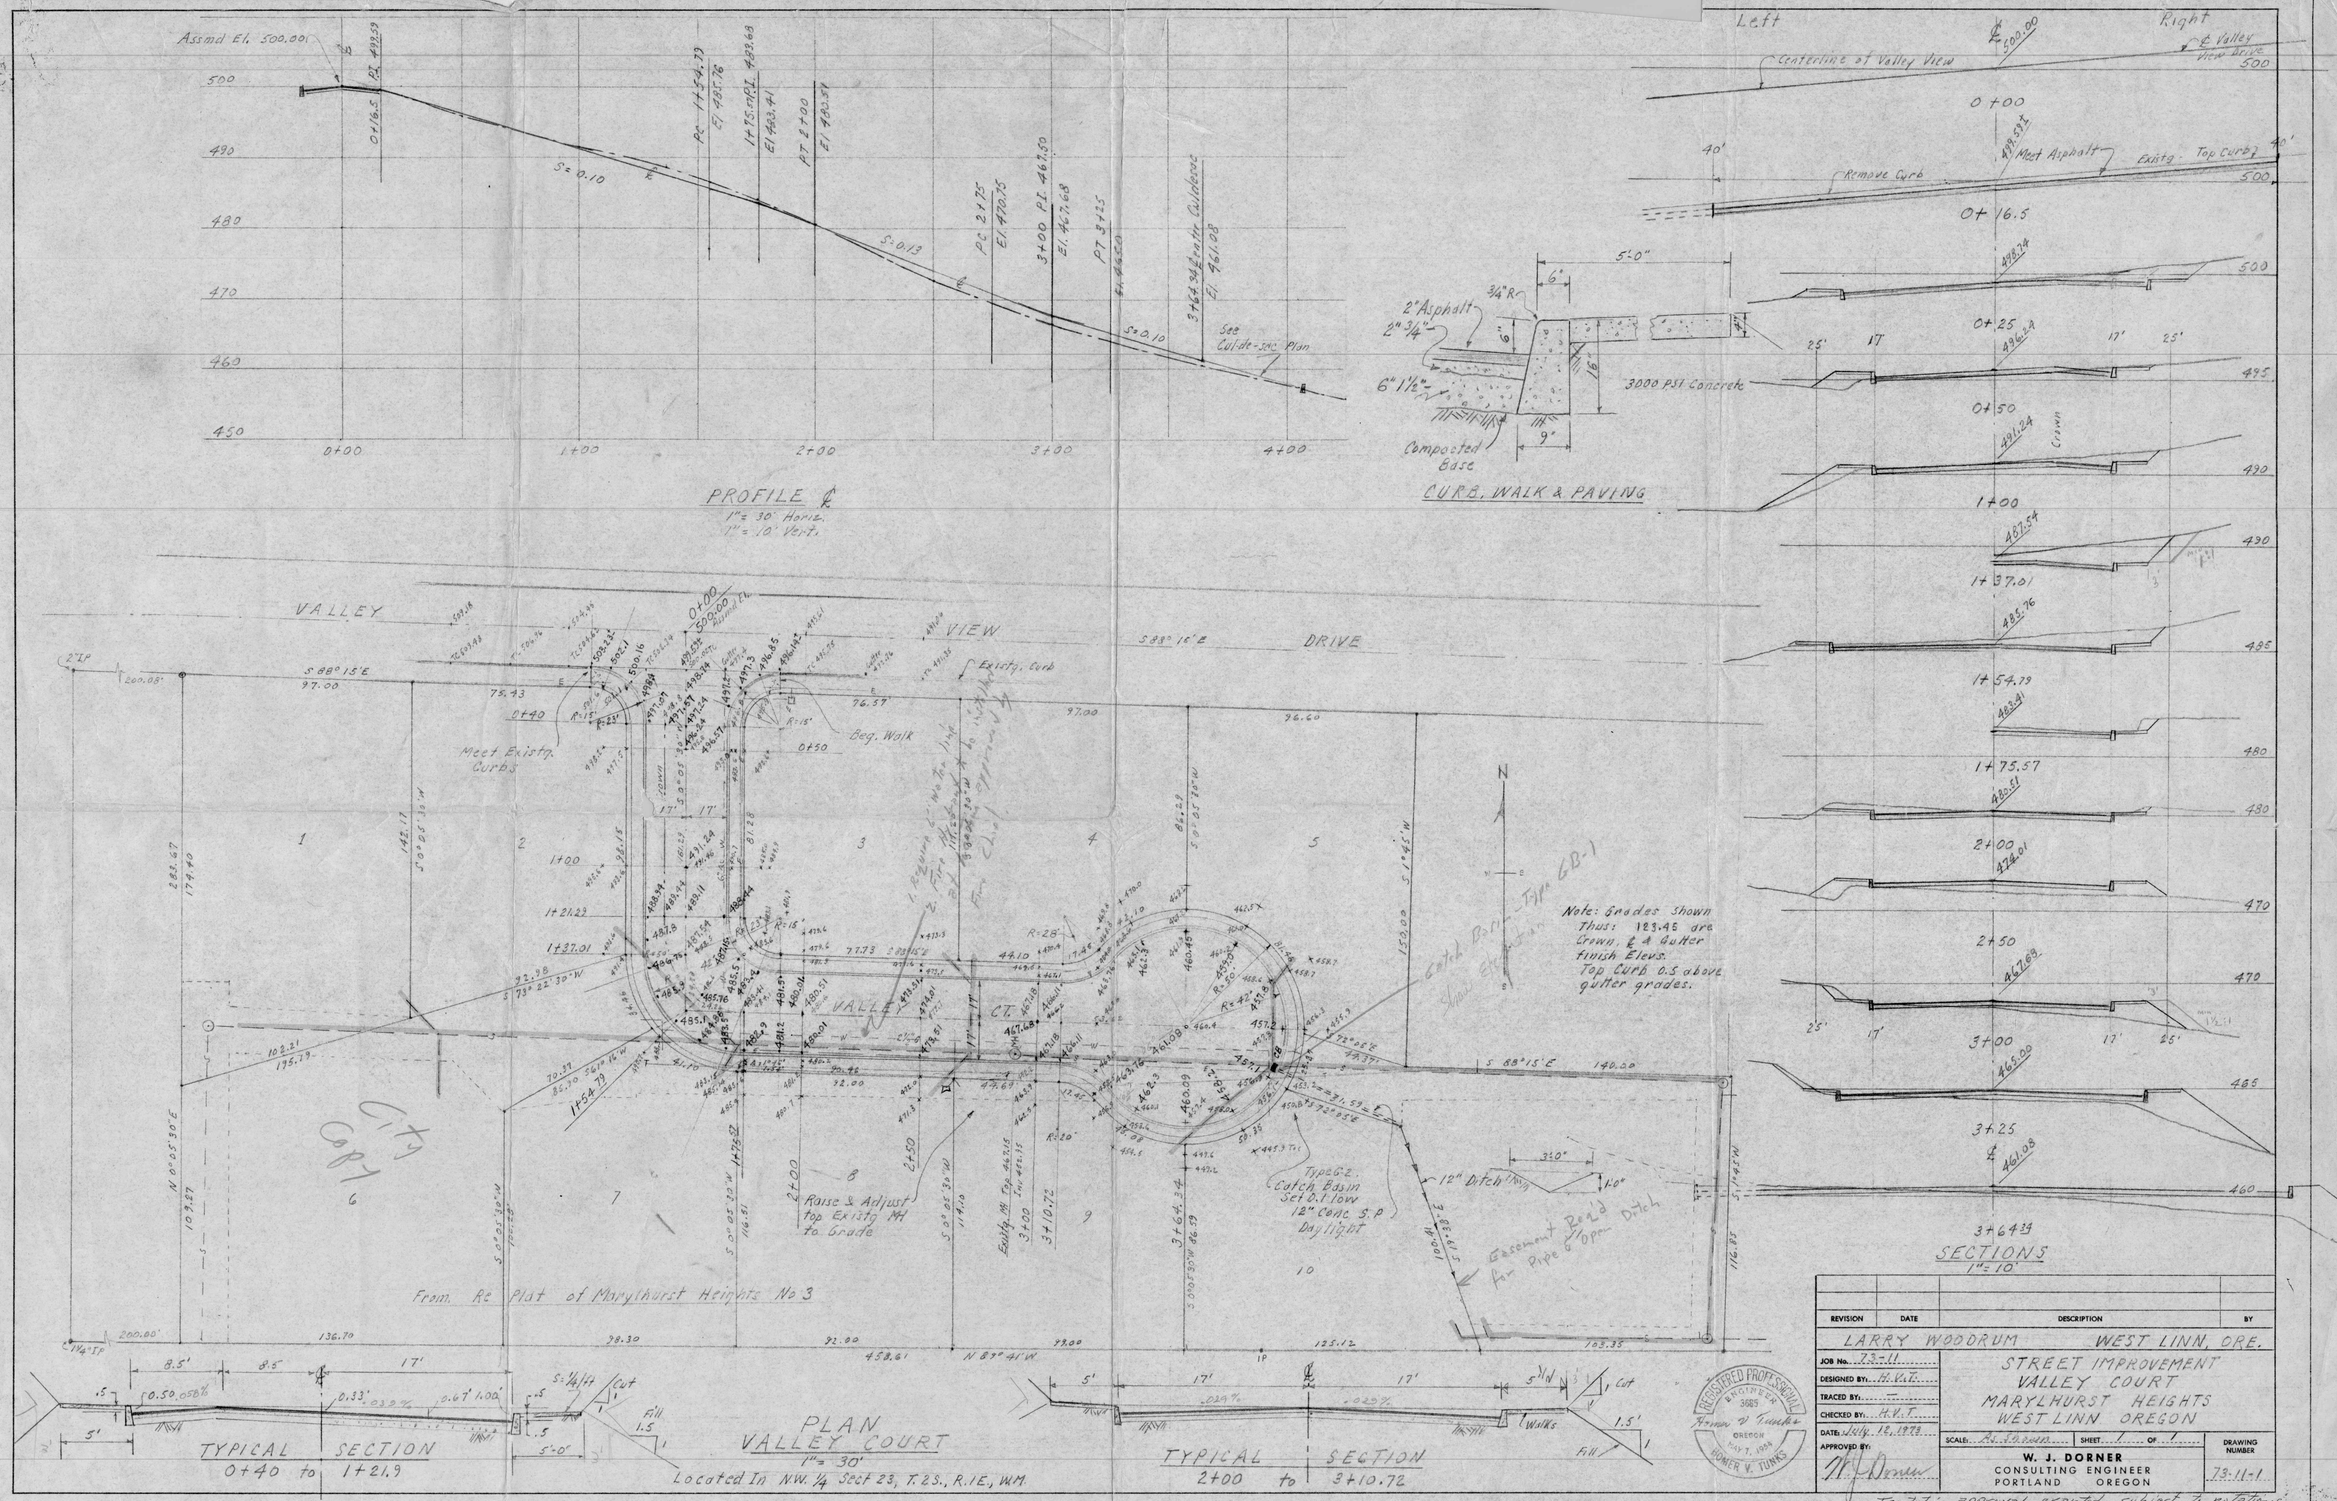

REVISION	DATE	DESCRIPTION	BY

LARRY WOODRUM — WEST LINN, ORE.

JOB No. 73-11
DESIGNED BY: H.V.T.
TRACED BY: —
CHECKED BY: H.V.T.
DATE: July 12, 1973
APPROVED BY: W. J. Dorner

STREET IMPROVEMENT
VALLEY COURT
MARYLHURST HEIGHTS
WEST LINN OREGON

SCALE: As Shown — SHEET 1 OF 1

W. J. DORNER
CONSULTING ENGINEER
PORTLAND OREGON

DRAWING NUMBER 73-11-1

Tentative approval granted subject to notations, compliance with city specs, and also subject to detailed analysis.

C. L. Sanders
7-20-73

VALLEY CT

MAN STATIONERY & PRINTING CO., PORTLAND, ORE.