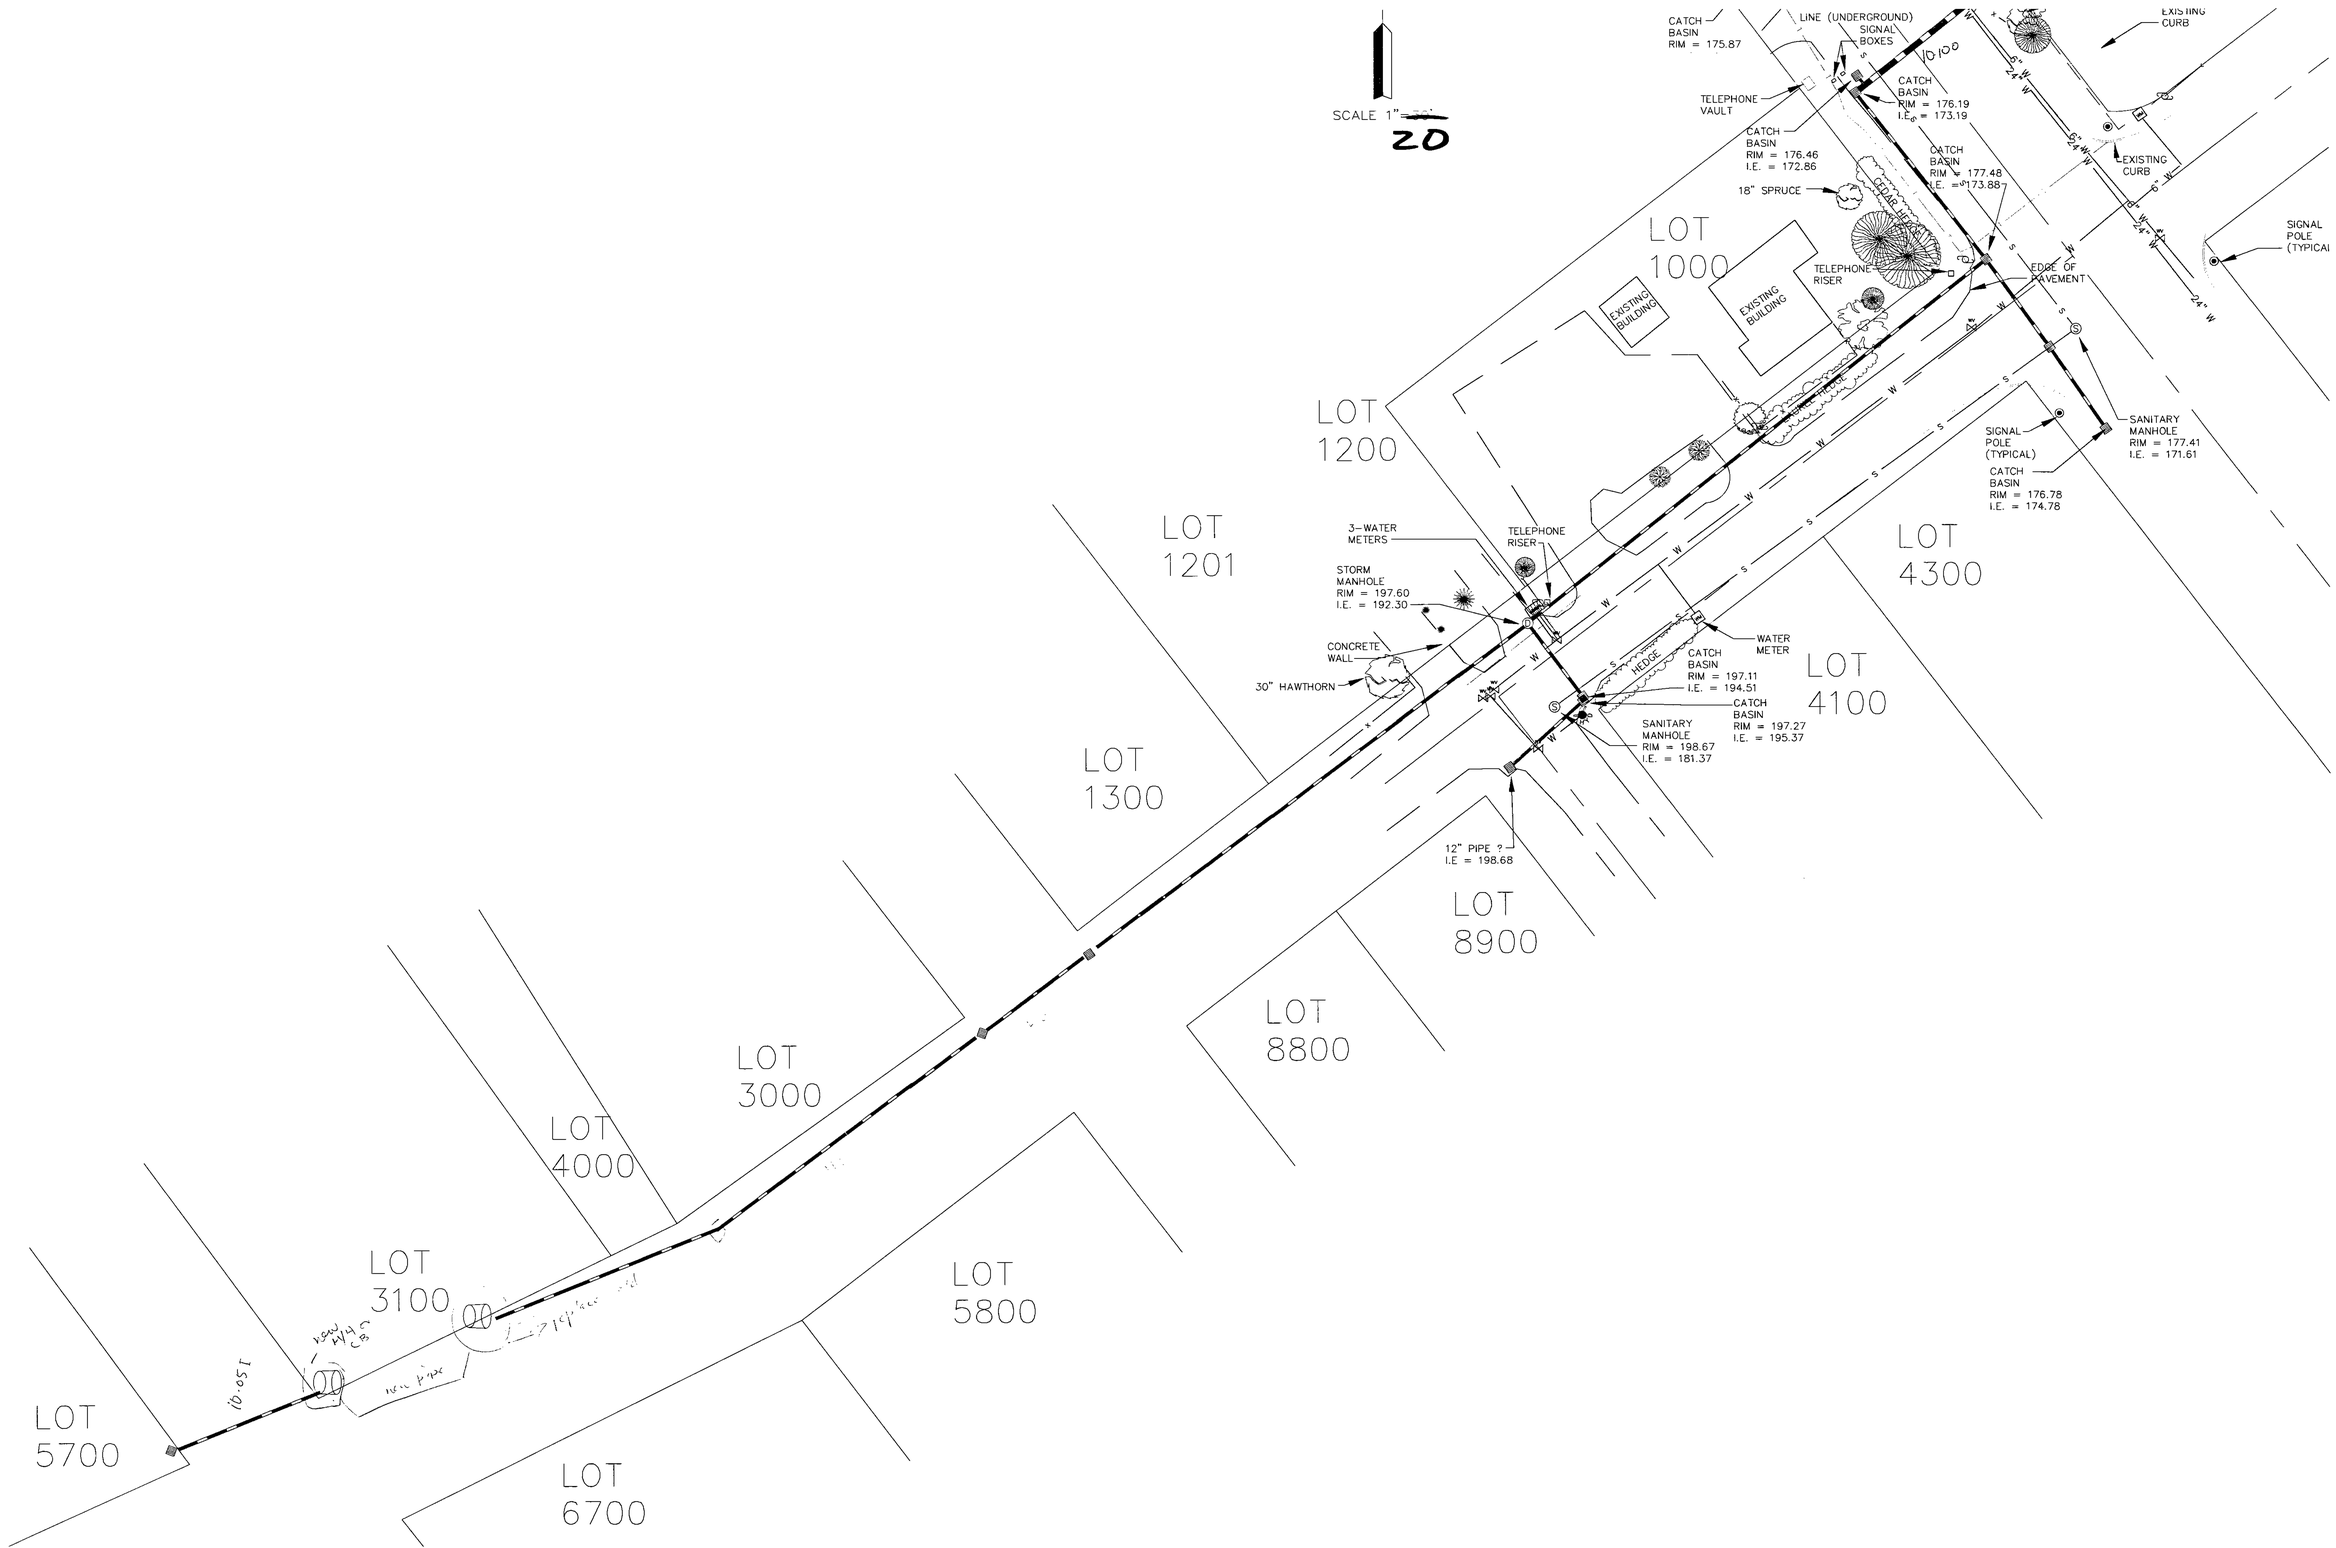
SCALE 1" = 20
CATCH BASIN RIM = 175.87
LINE (UNDERGROUND)
SIGNAL BOXES
EXISTING CURB
TELEPHONE VAULT
CATCH BASIN RIM = 176.19 I.E. = 173.19
CATCH BASIN RIM = 176.46 I.E. = 172.86
CATCH BASIN RIM = 177.48 I.E. = 173.88
EXISTING CURB
18" SPRUCE
CEDAR HEDGE
SIGNAL POLE (TYPICAL)
LOT 1000
TELEPHONE RISER
EDGE OF PAVEMENT
EXISTING BUILDING
EXISTING BUILDING
LOT 1200
SANITARY MANHOLE RIM = 177.41 I.E. = 171.61
SIGNAL POLE (TYPICAL)
CATCH BASIN RIM = 176.78 I.E. = 174.78
LOT 1201
3-WATER METERS
TELEPHONE RISER
STORM MANHOLE RIM = 197.60 I.E. = 192.30
LOT 4300
CONCRETE WALL
30" HAWTHORN
WATER METER
HEDGE
CATCH BASIN RIM = 197.11 I.E. = 194.51
CATCH BASIN RIM = 197.27 I.E. = 195.37
SANITARY MANHOLE RIM = 198.67 I.E. = 181.37
LOT 4100
LOT 1300
12" PIPE ? I.E = 198.68
LOT 8900
LOT 8800
LOT 3000
LOT 4000
LOT 3100
LOT 5800
LOT 5700
LOT 6700