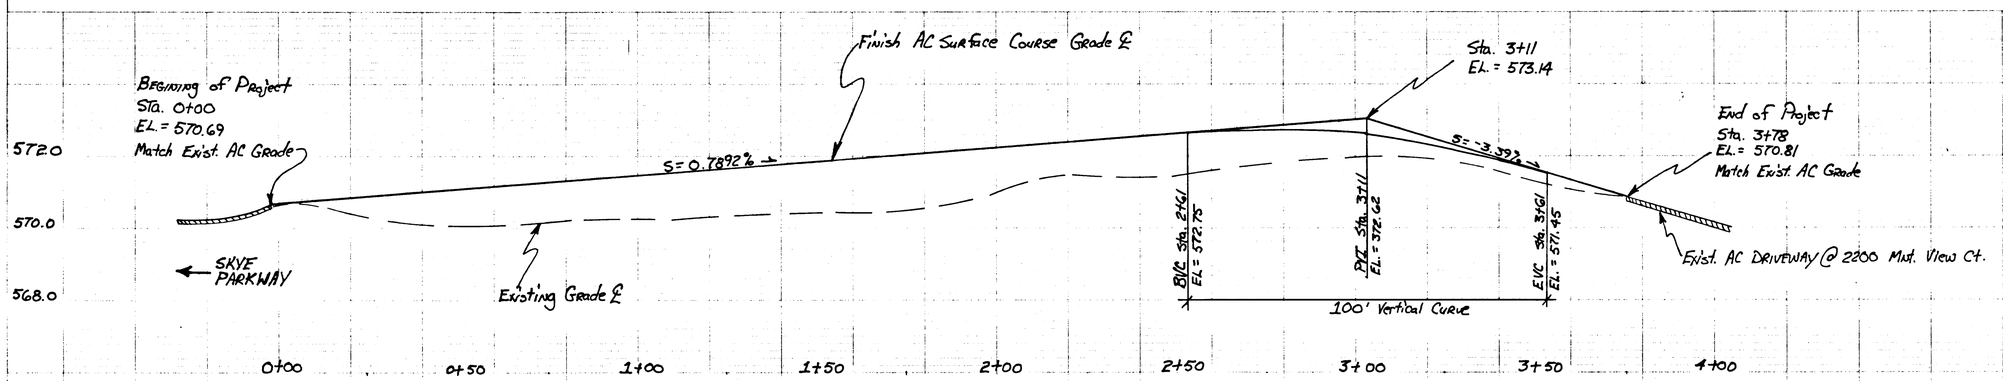

PROFILE

SCALE: Horizontal 1"=20', Vertical 1"=2'

Notes

1. Typical Cross Section:
   - 3"-Class "C" AC Surface Course
   - 7"-Base Course as follows:
     - 2"- 3/4-0" Crushed Rock Leveling Course
     - 5"- 1 1/2-0" Crushed Rock Base

AS BUILT 9/92

REGISTERED PROFESSIONAL ENGINEER
OREGON
JULY 23
KEITH D. SAHLINGER

DATE	REVISIONS	CITY OF WEST LINN				
		Mnt. VIEW COURT STREET IMPROVEMENT				
		DATE: July 30, 1991	DRAWN BY KG	APPROVED BY Keith D. Sahlinger	SHEET OF	PROJECT CI-91-
		SCALE: AS SHOWN	CHK'D BY KG	FIELD BOOK: IN FILE		DRAWING

Mt. View Ct. Street Impr.

-0-