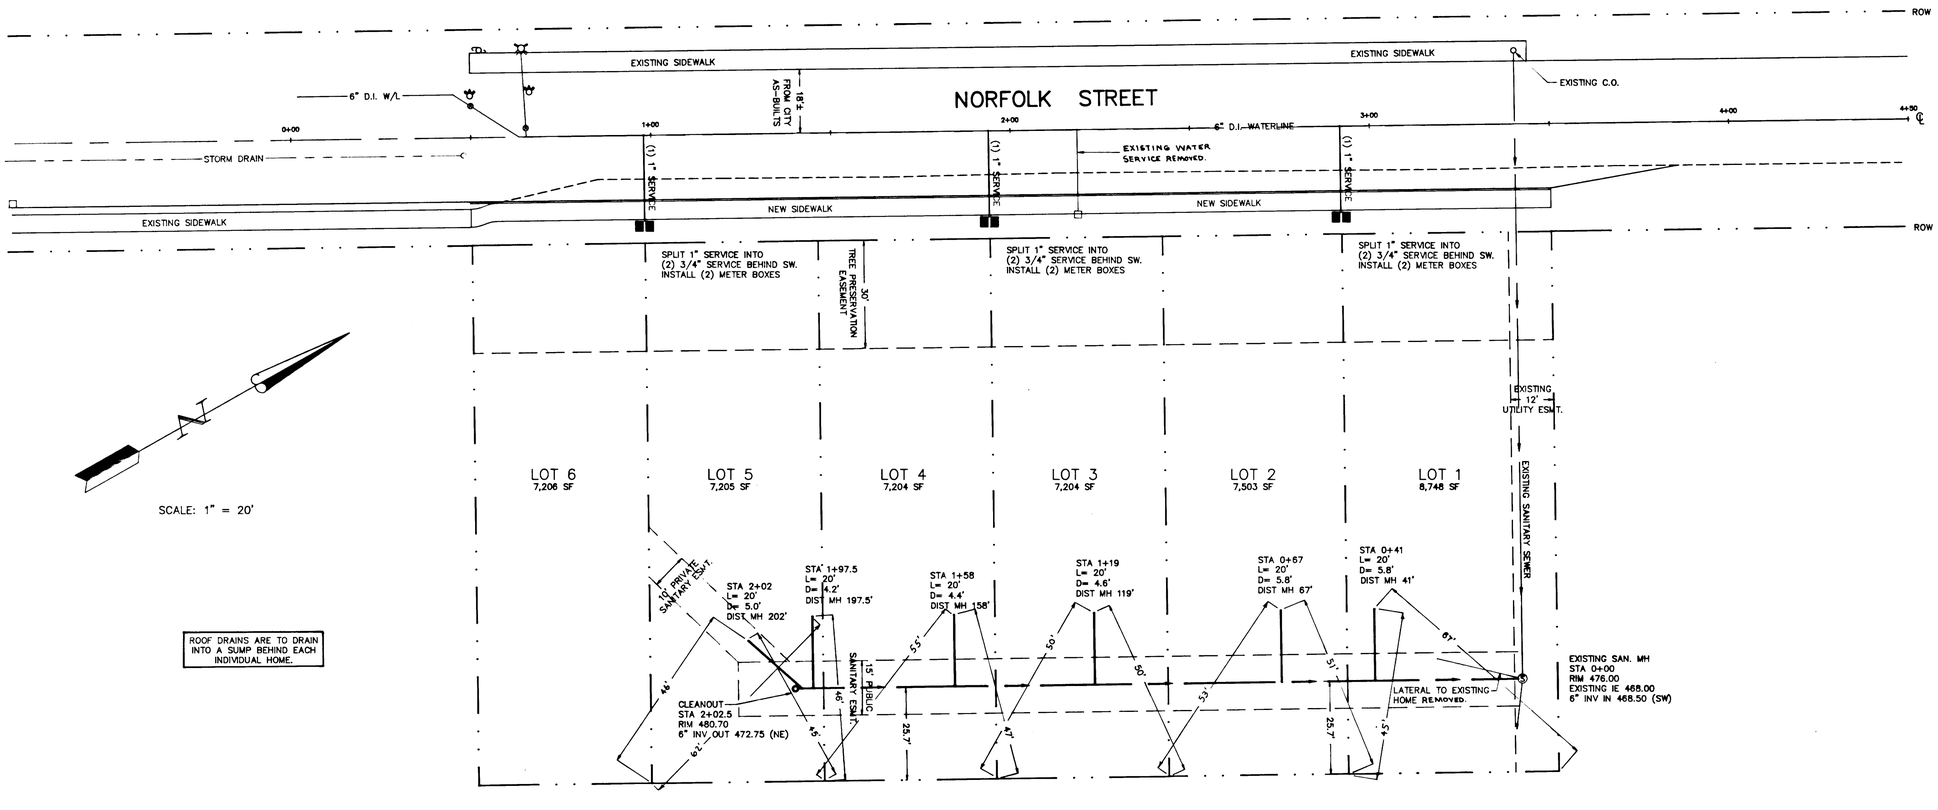

SANITARY SEWER PROFILE

SCALE: HORIZ. 1" = 20'
VERT. 1" = 2'

REGISTERED PROFESSIONAL ENGINEER 12,820 OREGON Feb. 14, 1985 THOMAS J. SISUL
1/4/93

AS BUILT

REVISIONS	BY
AS BUILT	JH 1/4/93
AS BUILT ADD TIES AS REQUESTED BY CITY	PS 1/6/93

NORFOLK PARK
ROBERT PLUMMER

Waterline and Sanitary Sewer Plans

SISUL ENGINEERING
375 PORTLAND AVENUE
GLADSTONE, OREGON 97027
(503) 657-0188

DATE OCT 1992
SCALE H: 1" = 20' V: 1" = 2'
DRAWN PS
JOB 92-44
SHEET 1 OF 4 SHEETS