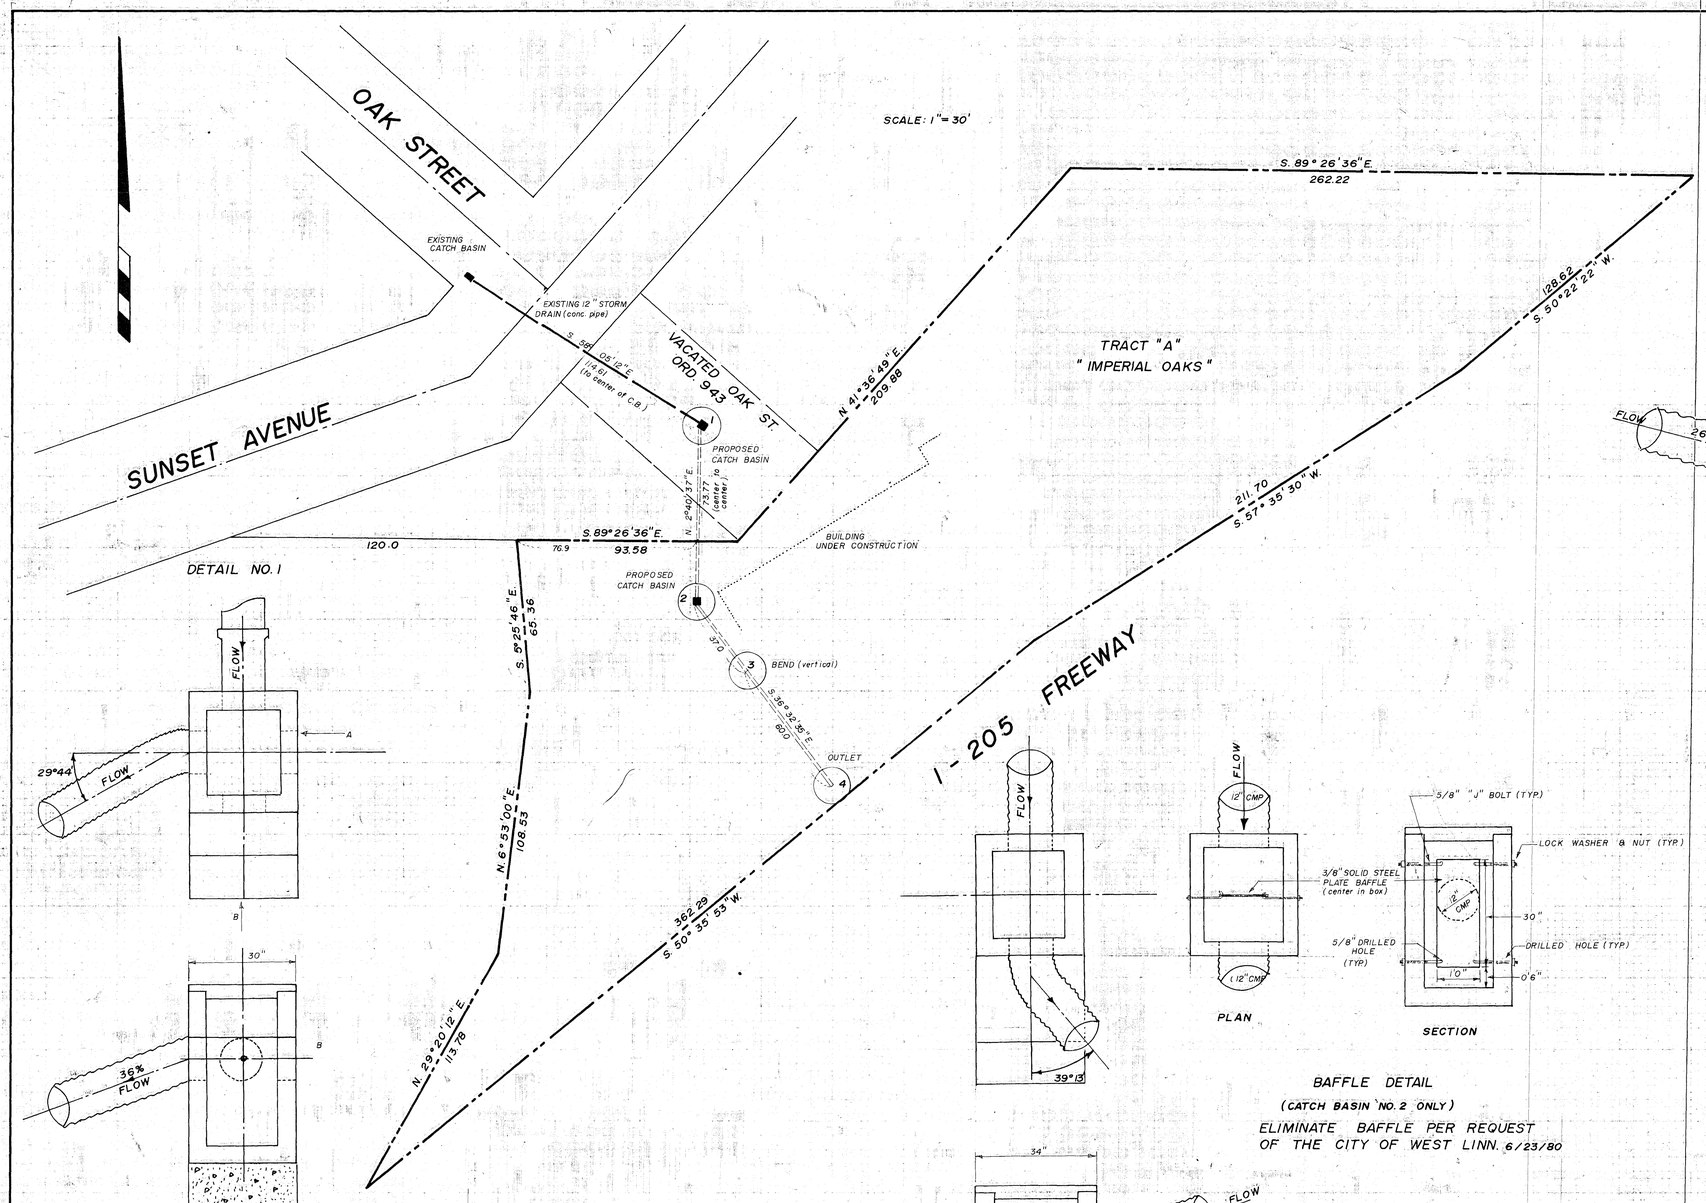

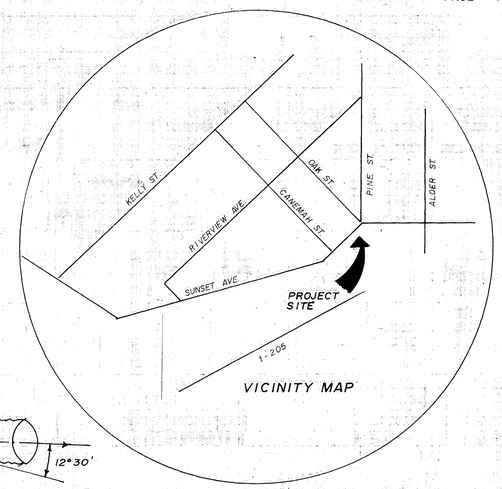

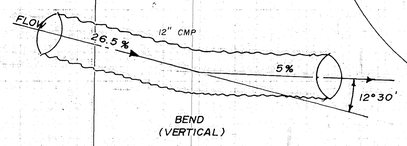

DETAIL NO. 3

DETAIL NO. 1

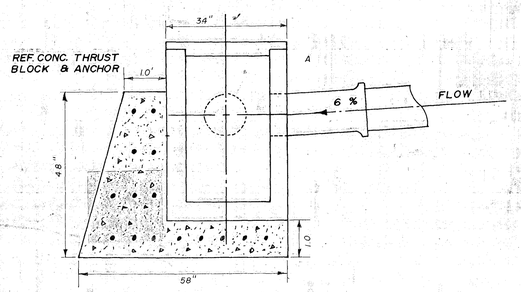

BAFFLE DETAIL

(CATCH BASIN NO. 2 ONLY)

ELIMINATE BAFFLE PER REQUEST OF THE CITY OF WEST LINN. 6/23/80

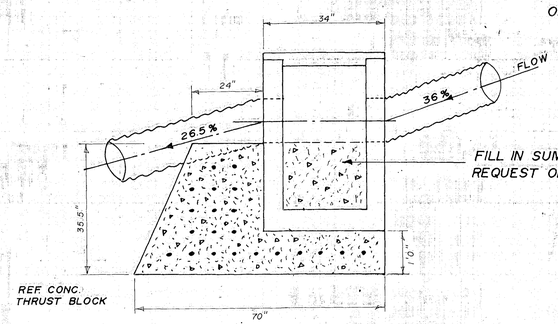

FILL IN SUMP WITH CONCRETE PER REQUEST OF THE CITY OF WEST LINN. 6/23/80

DETAIL NO. 2

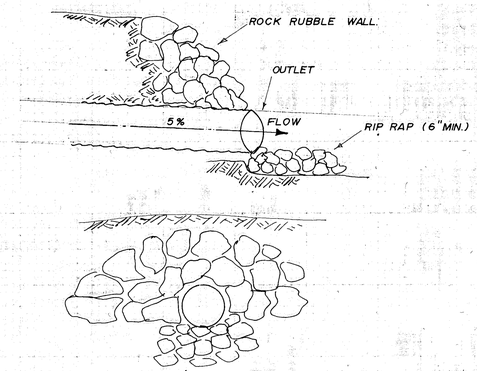

DETAIL NO. 4

NOTES:

1. CATCH BASINS ARE PRECAST WITH SOLID CONCRETE COVERS. SIZE: 30" X 34" X 48" FROM TOWN CONCRETE PIPE, INC.
2. ALL CRUSHED PIPE BETWEEN THE EXISTING CATCH BASIN ON SUNSET AVENUE AND THE PROPOSED CATCH BASIN NO. 1 IS TO BE REPLACED WITH NEW 12" TONGUE AND GROOVE MORTAR JOINT CONCRETE PIPE.
3. ALL PIPE FROM PROPOSED CATCH BASIN NO. 1 TO THE OUTLET IS TO BE 12" FULLY COATED CORRUGATED METAL PIPE (CMP) 18 GAGE.
4. PIPES AND CATCH BASINS ARE TO HAVE A 4" GRAVEL BASE.
5. DETAIL DRAWINGS NOT TO SCALE.
6. RE-BAR IN THURST BLOCKS ARE NO. 4's SPACED 6" O.C.
7. IF POSSIBLE SAVE LARGE OAK TREE BETWEEN C.B. 1 & C.B. 2.

W.B. WELLS and associates, inc.
SURVEYORS
4230 N.E. FREMONT STREET
PORTLAND, OREGON 97213
Phone: 284-5896

REGISTERED PROFESSIONAL ENGINEER 2652 OREGON MAY 9, 1975 RICHARD R. KELLEY

PROPOSED EXTENSION OF THE EXISTING

STORM DRAIN SEWER

CITY OF WEST LINN, COUNTY OF CLACKAMAS, STATE OF OREGON
SITUATED IN SECTION 36, T.2S., R.1E. W.M.

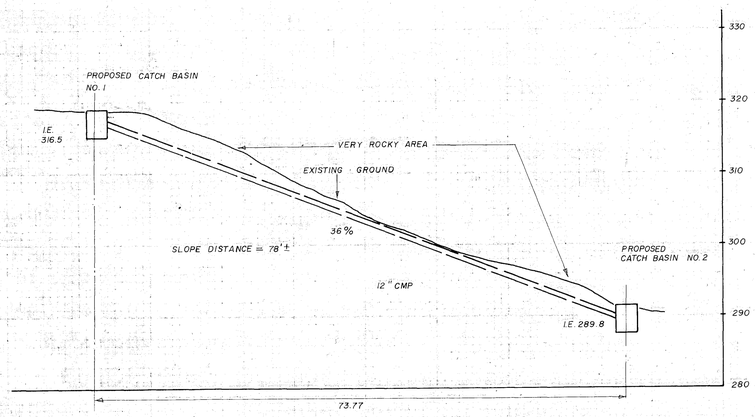

PROFILE

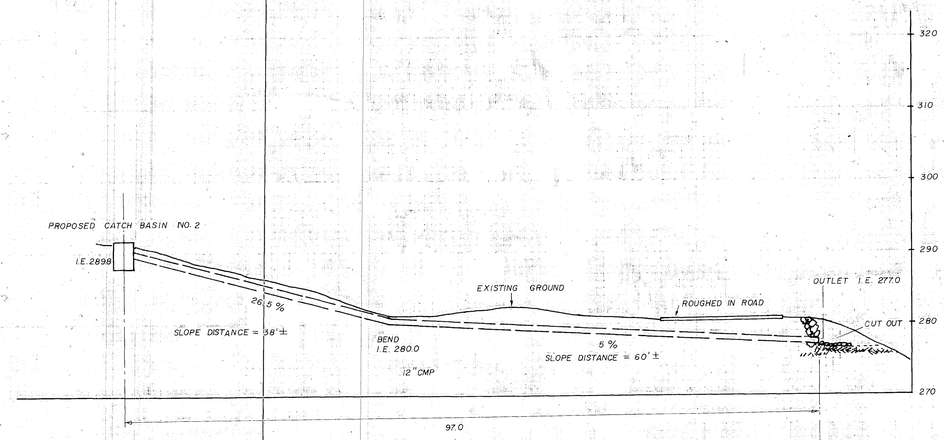

PROFILE

NOTE: 14 GAGE ALUMINUM MAY BE USED IN PLACE OF THE CMP.

W.B.WELLS
and ASSOCIATES, INC.
SURVEYORS
4230 N.E. FREMONT STREET
PORTLAND, OREGON 97213
Phone: 284-5896

REGISTERED PROFESSIONAL ENGINEER
2652
OREGON
MAY 9, 1978
RICHARD R. KELLEY

PROPOSED EXTENSION OF THE EXISTING

STORM DRAIN SEWER

CITY OF WEST LINN, COUNTY OF CLACKAMAS, STATE OF OREGON
SITUATED IN SECTION 36, T. 2S., R.1E., W.M.