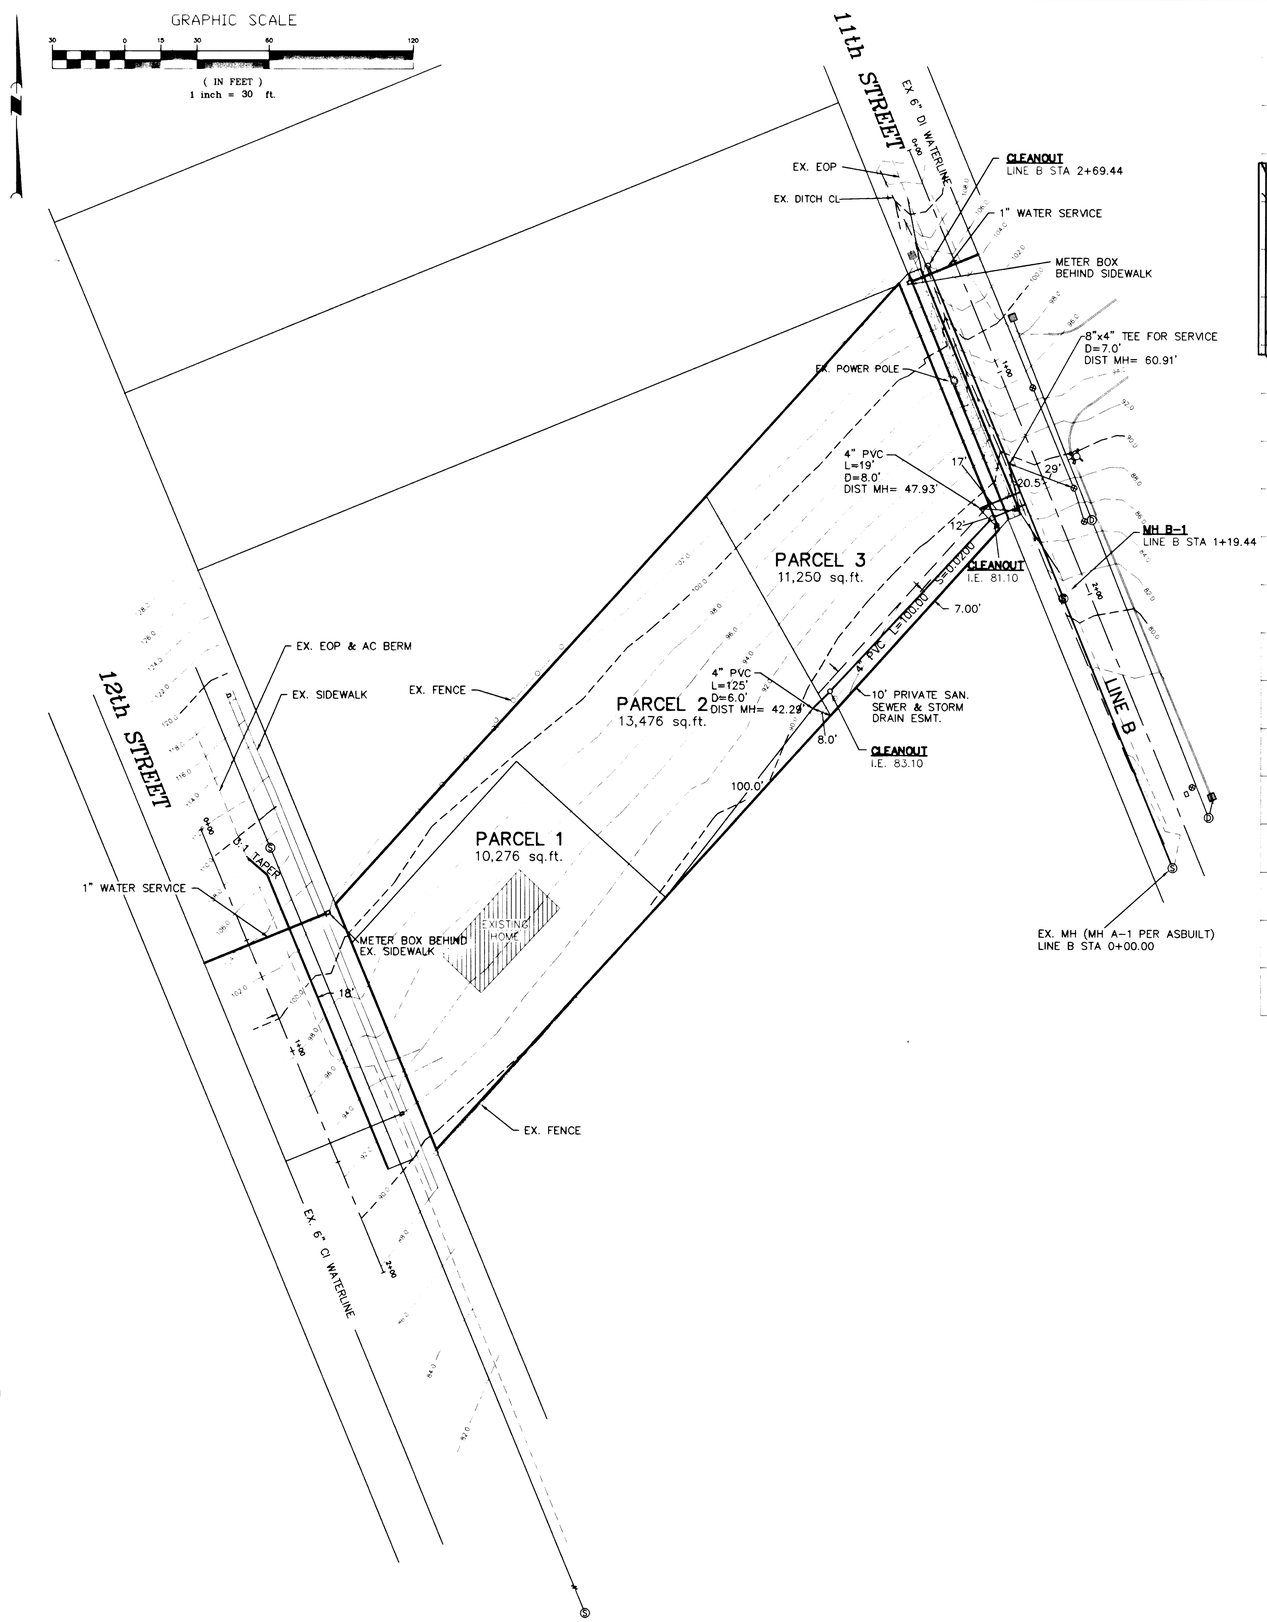

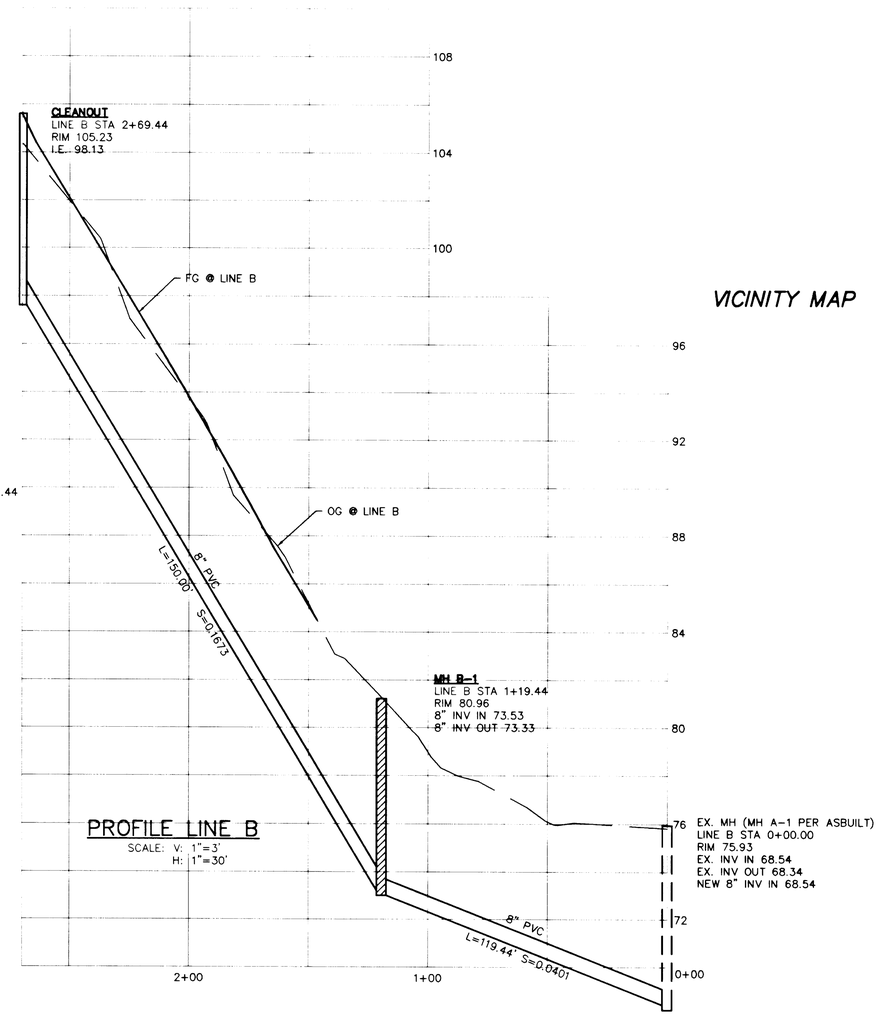

PROFILE LINE B
SCALE: V: 1"=3'
H: 1"=30'

VICINITY MAP

AS BUILT

REGISTERED PROFESSIONAL ENGINEER 12,820 OREGON FEB. 14, 1995 THOMAS J. SISUL 8-16-95

REVISIONS	BY
REVISED PER CITY REVIEW	JH 1/19/95
AS BUILT	JEE 5/15/95

PARTITION IMPROVEMENTS ON 11th & 12th STREETS

MARK HANDRIS

Waterline Plan & Sanitary Sewer Plan and Profile

SISUL ENGINEERING
3775 PORTLAND AVENUE
GLADSTONE, OREGON 97027
(503) 657-0188

DATE NOV 1994
SCALE NOTED
DRAWN JH
JOB 94-86
SHEET 1 OF 3 SHEETS

PARTITION IMPROVEMENTS

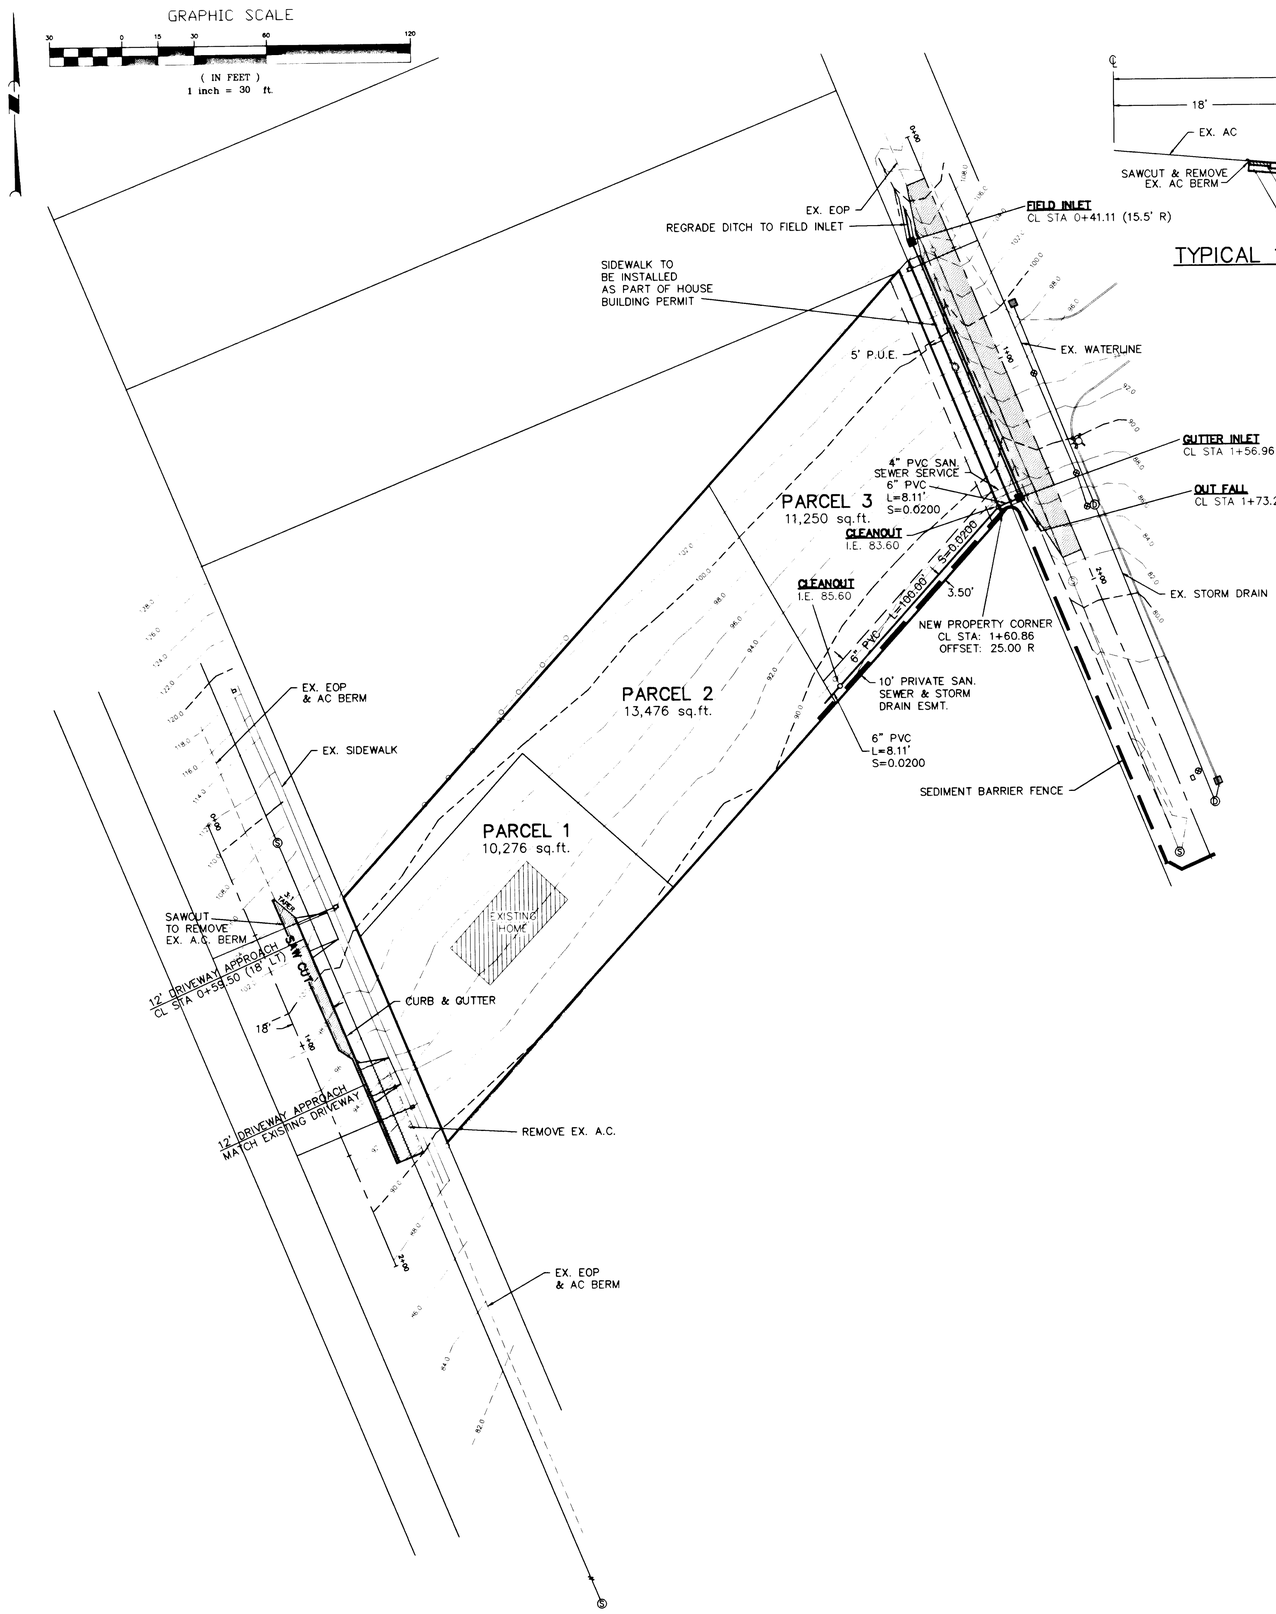

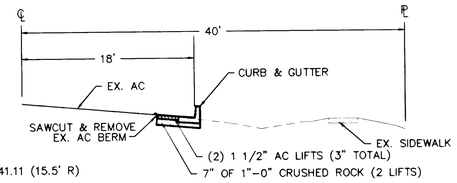

TYPICAL 12th STREET SECTION

NTS

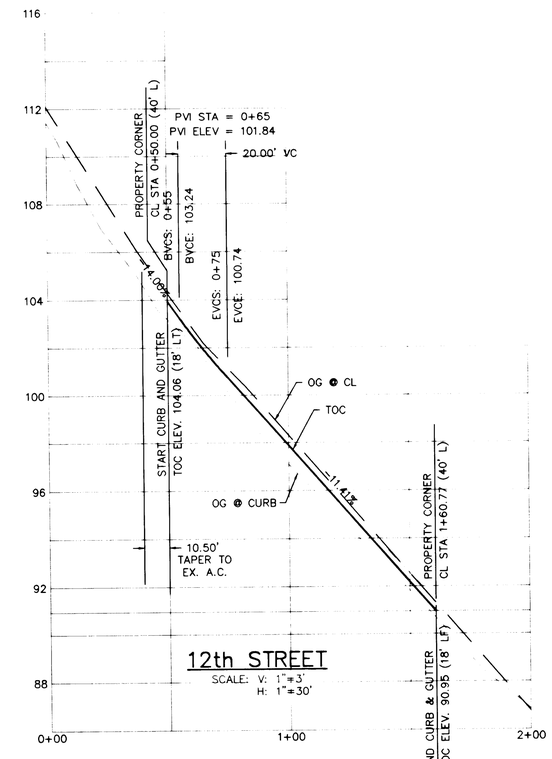

12th STREET

SCALE: V: 1"=3'
H: 1"=30'

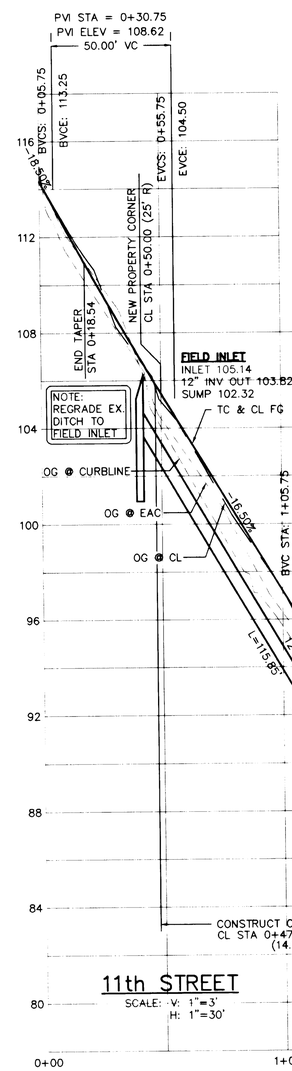

11th STREET

SCALE: V: 1"=3'
H: 1"=30'

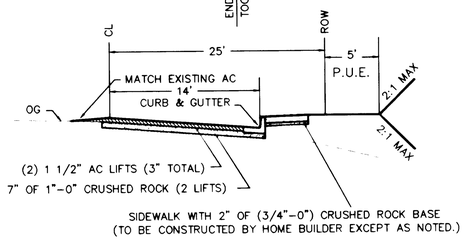

TYPICAL 11th STREET SECTION

NTS

AS BUILT

REGISTERED PROFESSIONAL ENGINEER 12,820 OREGON FEB. 14, 1980 THOMAS J. SISUL
8-16-95

REVISIONS	BY
REVISED PER CITY REVIEW	JH 1/19/95
REVISED 11th ST PROFILE	JH 3/13/95
AS BUILT	JEE 8/15/95

PARTITION IMPROVEMENTS ON 11th & 12th STREETS

MARK HANDRIS

Steet and Storm Drain Plan and Profile

SISUL ENGINEERING
375 PORTLAND AVENUE
GLADSTONE, OREGON 97027
(503) 657-0188

DATE	NOV 1994
SCALE	NOTED
DRAWN	JH
JOB	94-86
SHEET	2 OF 3 SHEETS