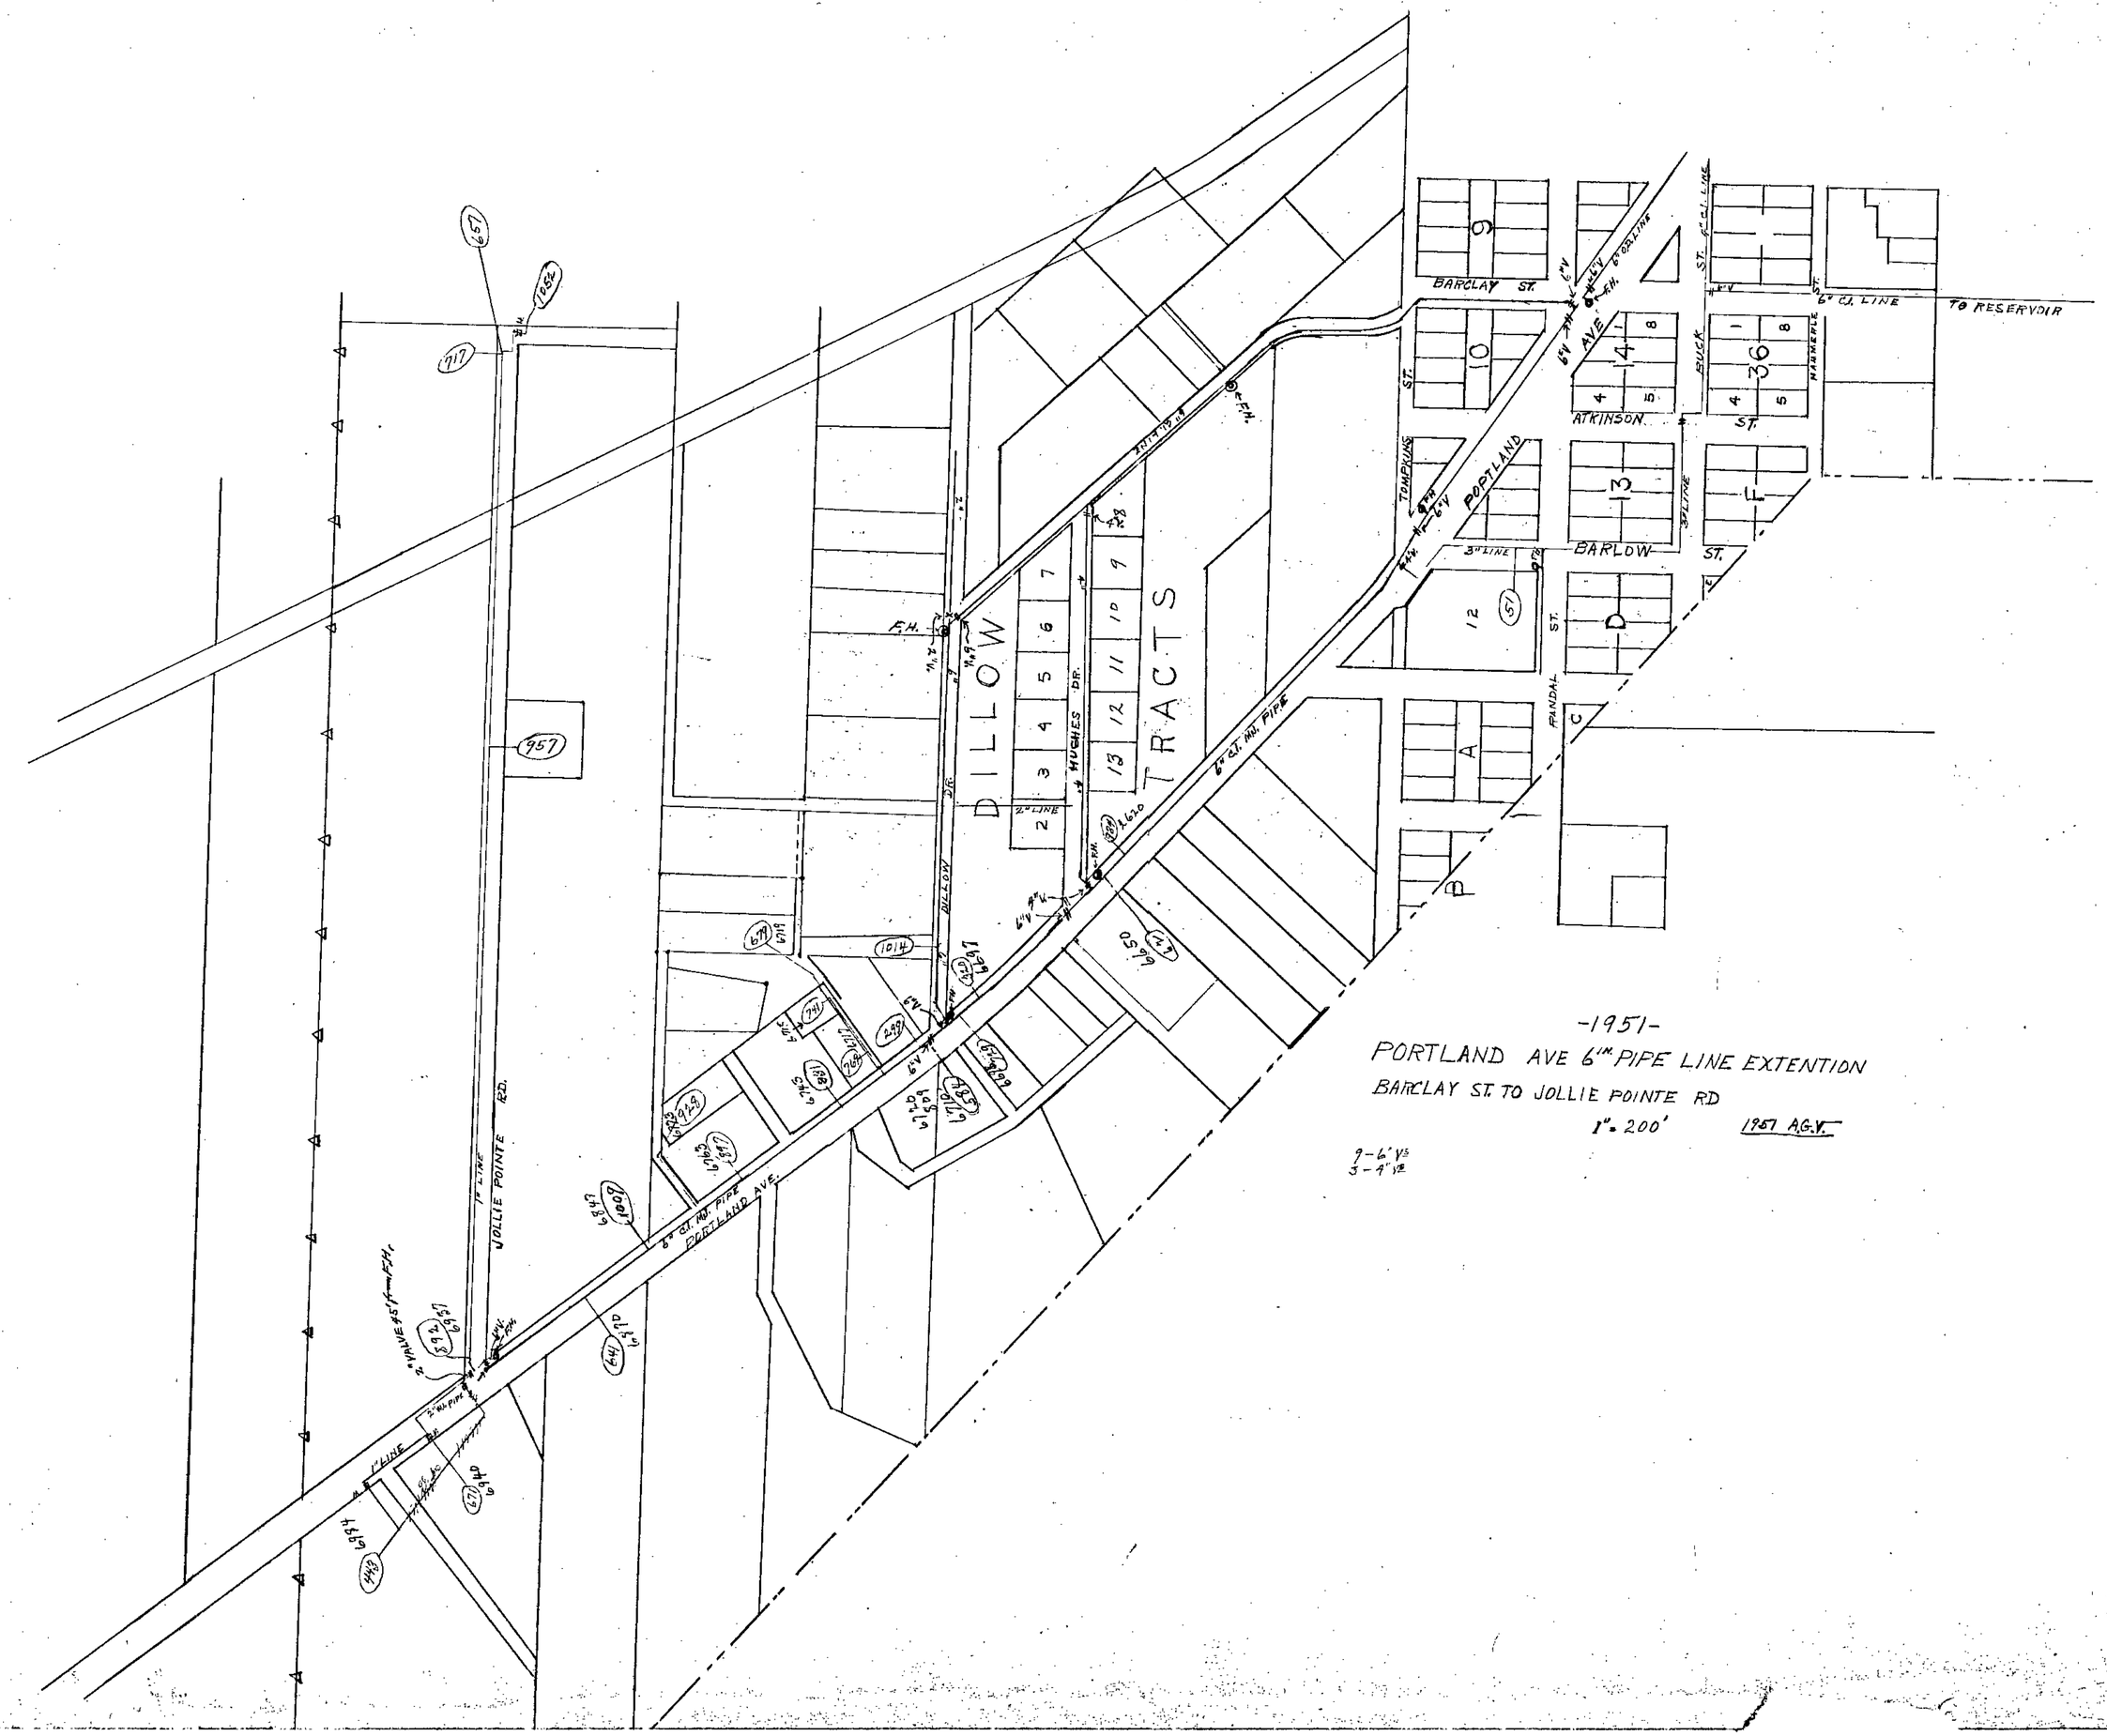

-1951-

PORTLAND AVE 6" PIPE LINE EXTENTION

BARCLAY ST. TO JOLLIE POINTE RD

1" = 200' 1951 A.G.V.

9-6" VS
3-4" VS