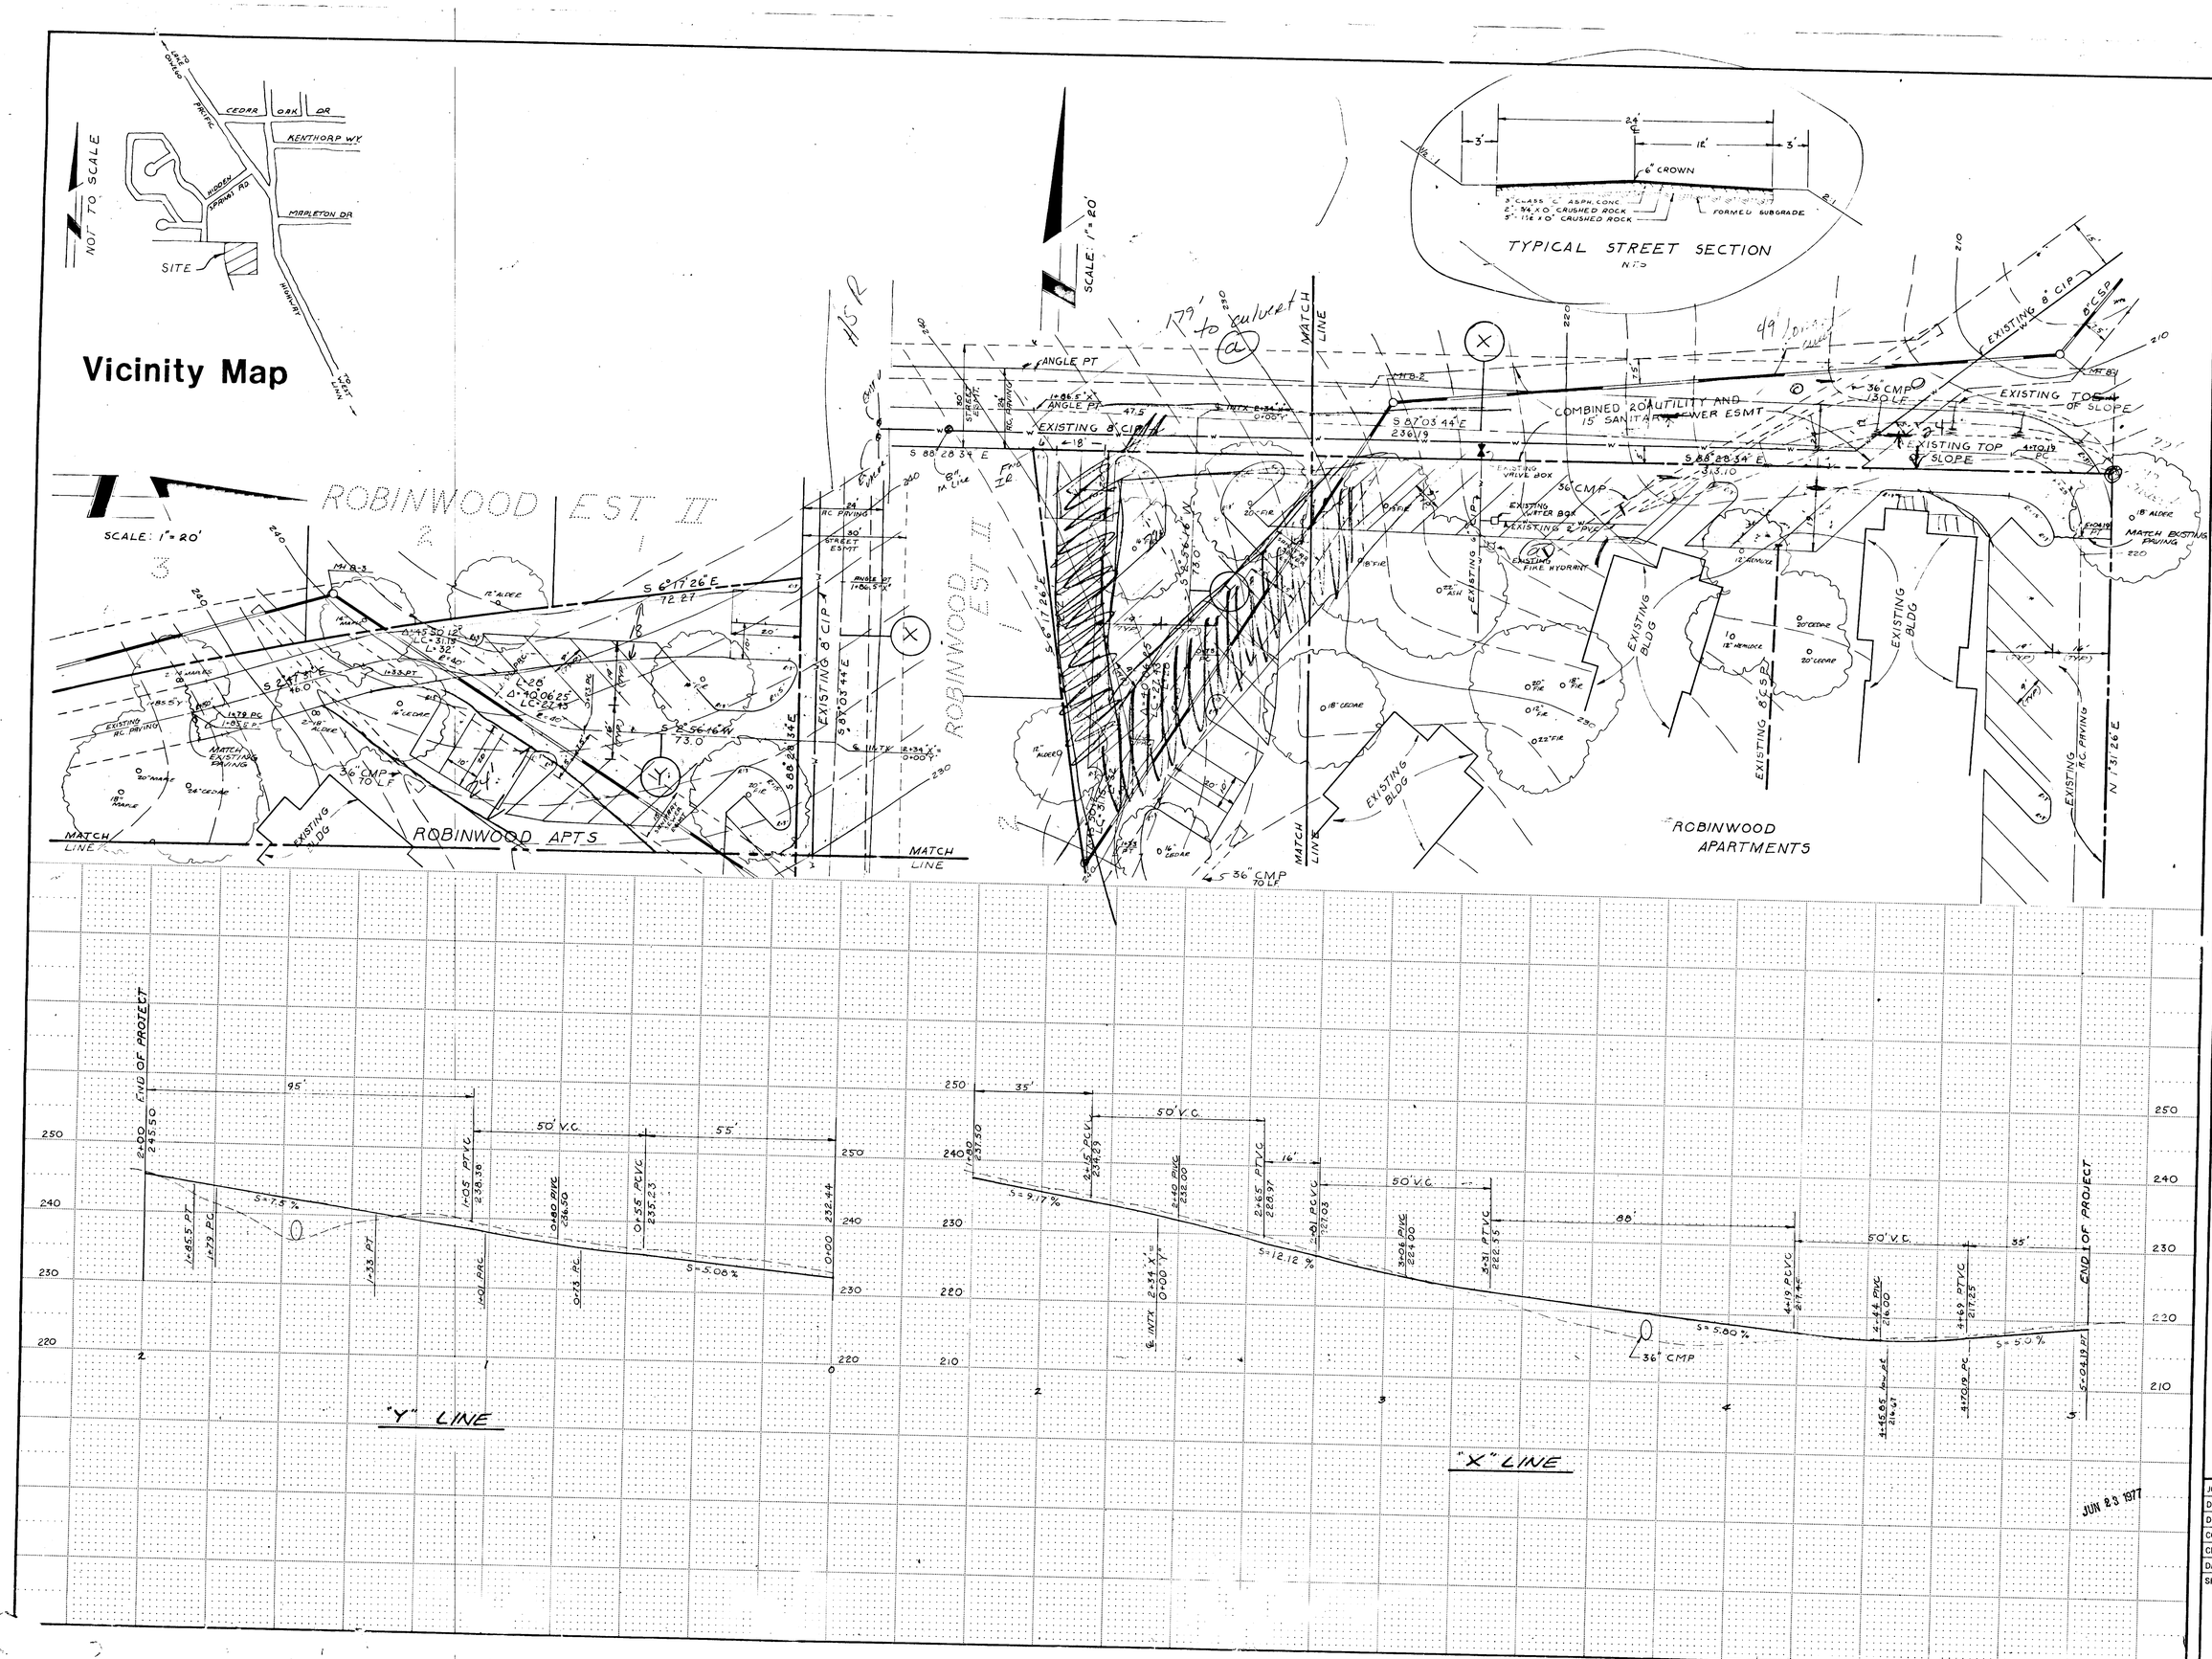

REVISIONS

NO.	DESCRIPTION/DATE

643-5475

tsea

Ginther/SEA, Inc.
3800 Cedar Hills Blvd.
Suite 276
Beaverton, OR. 97005

ROBINWOOD APARTMENTS

street, parking and storm drain

JOB NO.	3-106-76-1
DESIGNED	JAR
DRAWN	KM
COMP.	JAR
CHECKED	GLG
DATE	4-77
SHEET NO.	1

1 OF 1

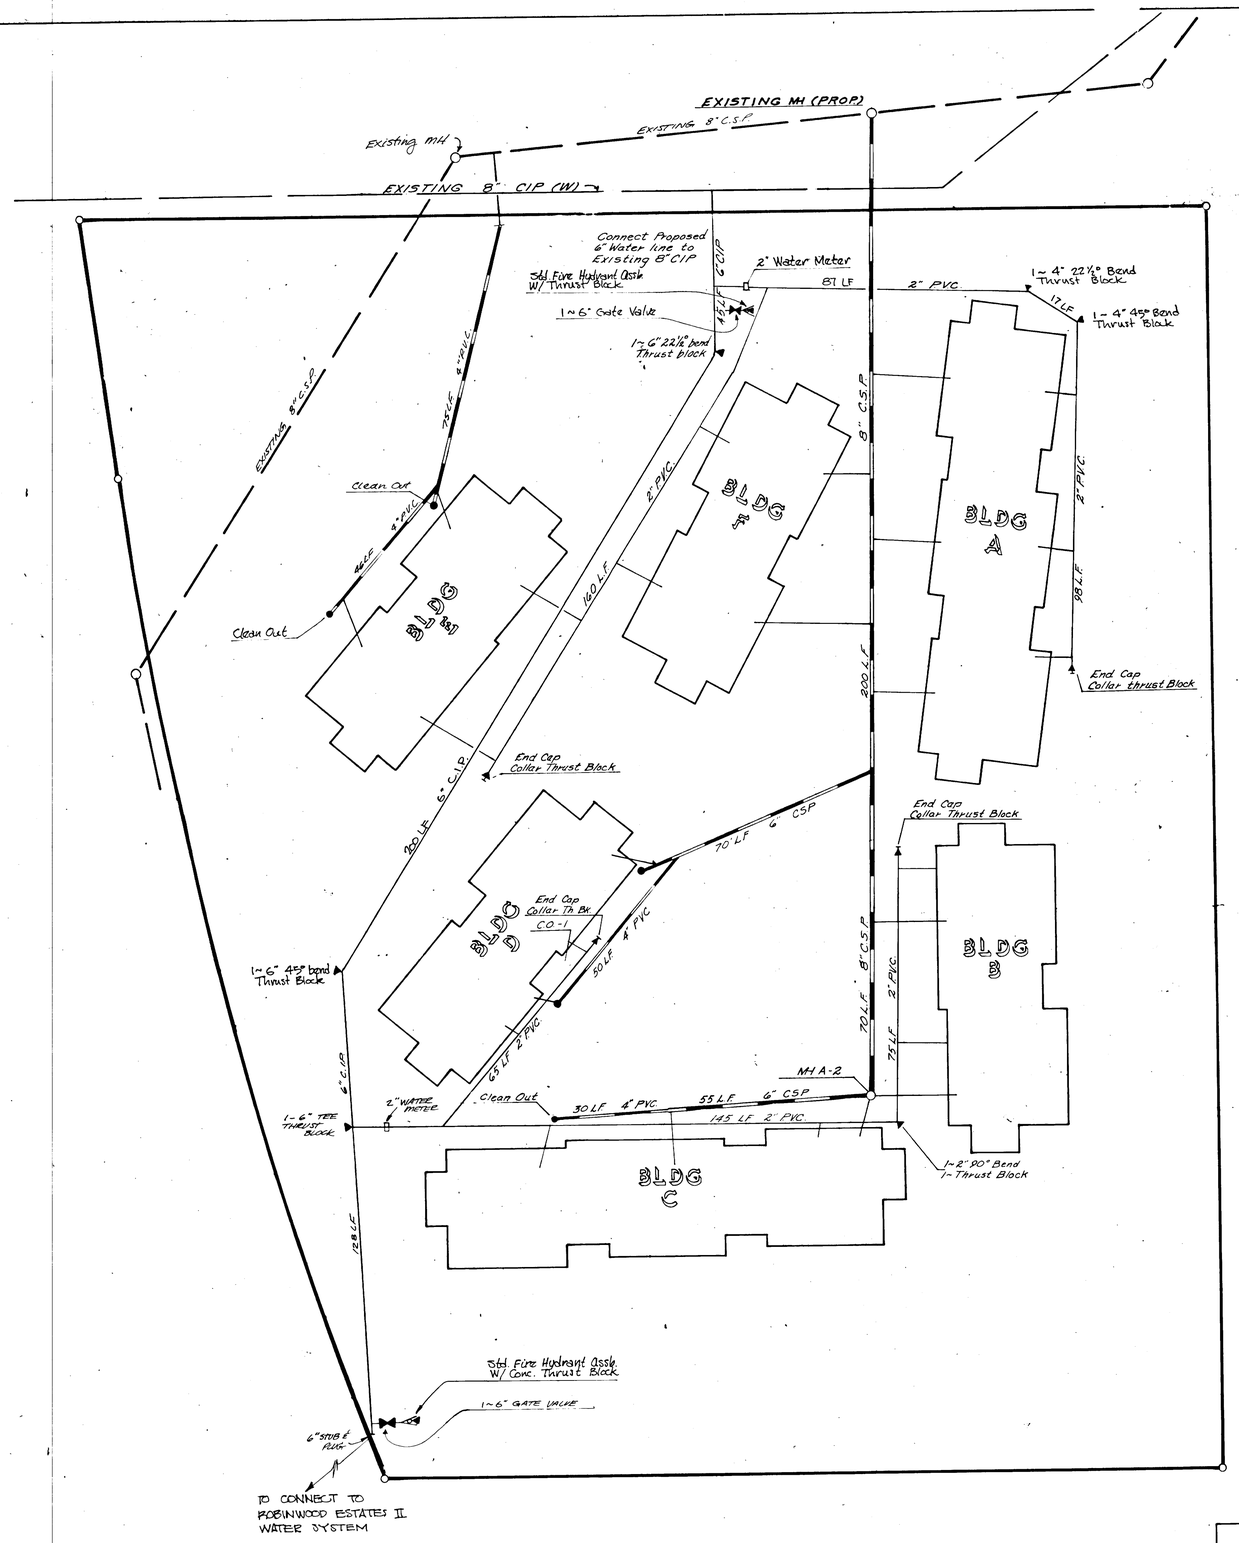

Record Drawing – From information supplied by client.
1-17-77 GINTHER/SEA

JUN 23 1977
JUN 32 1977

ROBINWOOD APARTMENTS
SANITARY SEWER AND WATER

SYLVAN HOMES, INC

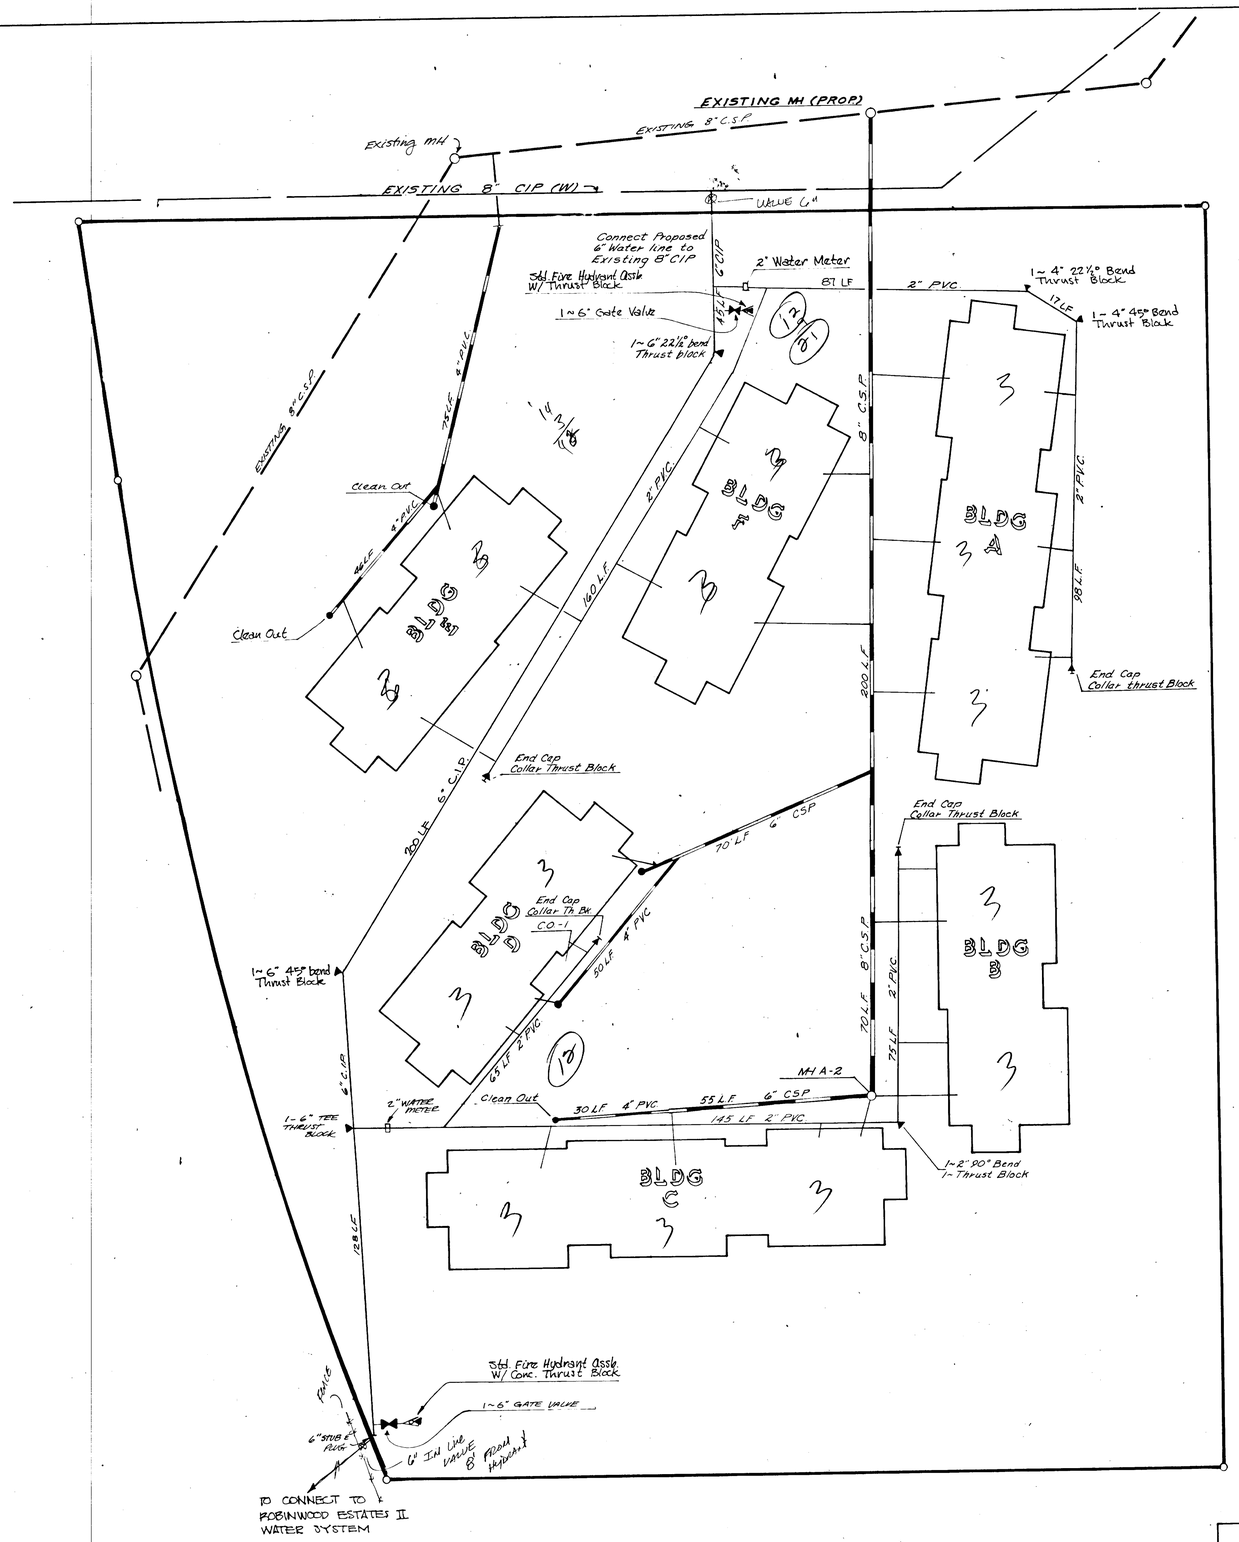

Record Drawing - From information supplied by client.
1-17-77 GINTHER / SEA

JUN 23 1977

ROBINWOOD APARTMENTS
SANITARY SEWER AND WATER

SYLVAN HOMES, INC.

ROBINWOOD APTS