1. ALL WORK SHALL CONFORM WITH THE STANDARDS AND SPECIFICATIONS OF THE CITY OF WEST LINN AND CLACKAMAS COUNTY.
2. CONCRETE INLETS SHALL BE CITY OF WEST LINN STANDARD CB-1.
3. WATER LINE CONNECTION AT DE BOK ROAD SHALL BE CO-ORDINATED WITH THE CITY OF WEST LINN WATER DEPT.
4. ALL SANITARY SEWER LATERALS SHALL BE CONNECTED WITH A 8"x6" WYE AND A 45° ELL (1/8th BEND).
5. WATER SERVICES TO BE INSTALLED WITH SADDLES, COPPER SETTER, TYPE K WITH CONNECTION FITTINGS.
6. WATER MAIN TO BE DUCTILE IRON CLASS 52.

PAVED TEMPORARY TURNAROUND W/ EXTENDED A.C. CURB

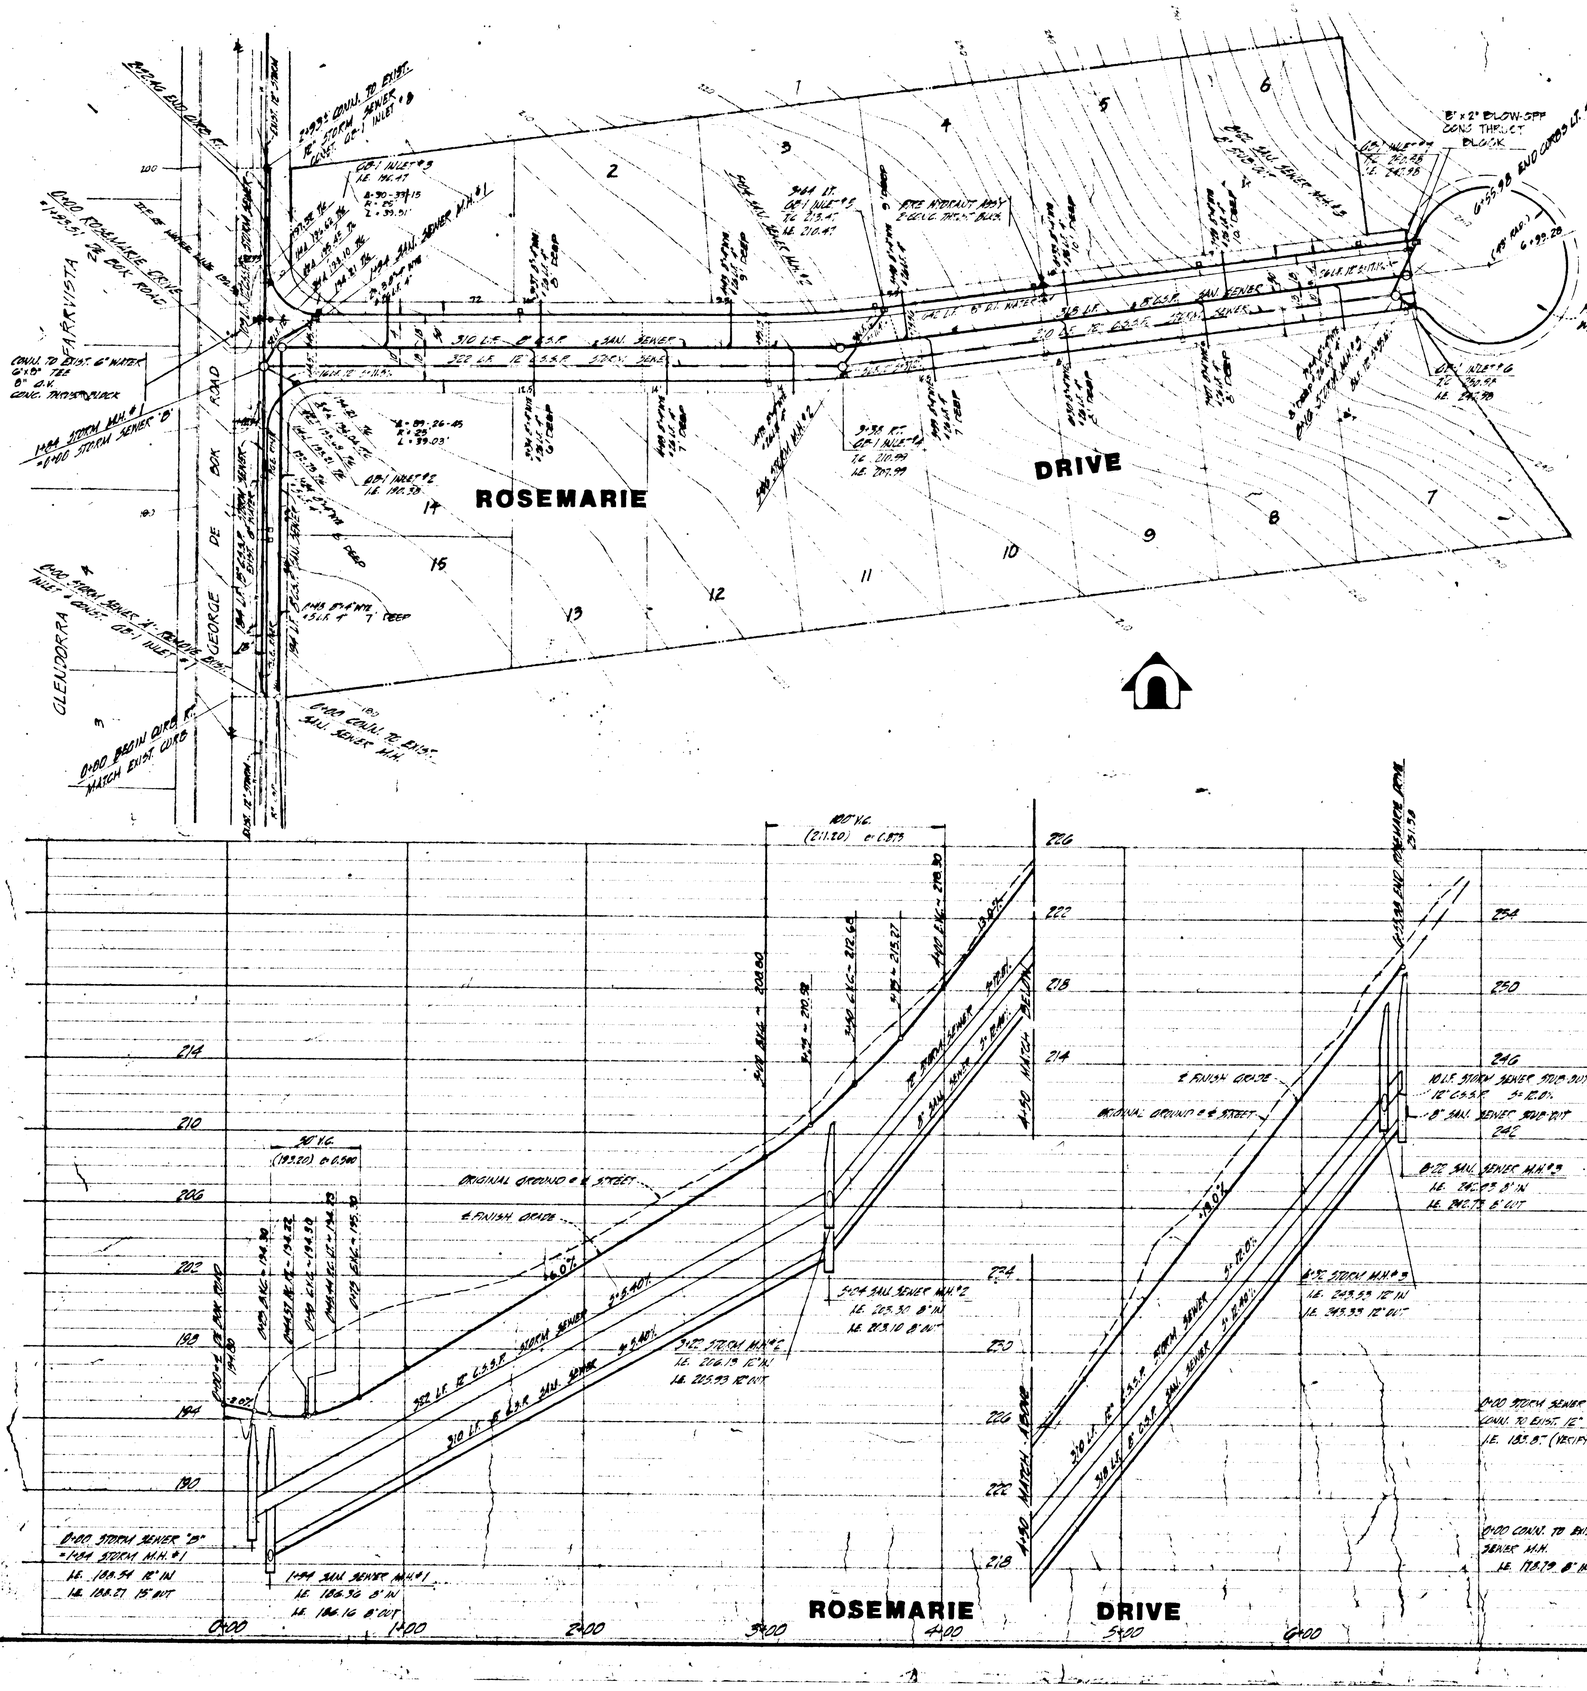
DE BOK ROAD
ROSEMARIE
DRIVE
GLENDORRA
GEORGE
8" x 2" BLOW-OFF CONS THRU CT BLOCK

Second Scan

This As-Built was scanned twice due to illegibility issues of the original scan.

1. ALL WORK SHALL CONFORM WITH THE STANDARDS AND SPECIFICATIONS OF THE CITY OF WEST LINN AND CLACKAMAS COUNTY.
2. CONCRETE INLETS SHALL BE CITY OF WEST LINN STANDARD CB-1.
3. WATER LINE CONNECTION AT DE BOK ROAD SHALL BE COORDINATED WITH THE CITY OF WEST LINN WATER DEPT.
4. ALL SANITARY SEWER LATERALS SHALL BE CONNECTED WITH A 8"x6" WYE AND A 45° ELL (1/8th BEND).
5. WATER SERVICES TO BE INSTALLED WITH SADDLES, SOFT COPPER, TYPE K WITH COMPRESSION FITTINGS.
6. WATER MAIN TO BE 8" DUCTILE IRON SCHEDULE 52.

DAVID EVANS AND ASSOCIATES, INC.
1100 SW 6th AVENUE PORTLAND, OREGON 97201 503/223-6663

street, storm sewer
sanitary sewer & water
plan and profiles

ROSEMARIE PARK
West Linn, Oregon
ALLYN HOMES CO.
Hillsboro, Oregon

REGISTERED PROFESSIONAL ENGINEER OREGON DAVID FRANK JULY 11 1978

SHEET 1 OF SHEETS
DATE June 1977
SCALE 1"=40' HOR. 1"=4' VERT.
DESIGN DME
DRAWN ET, DME
CHECKED DFR
FILE ALLYN PRT

AS BUILT 11-6-78 DET
REV 8-3-78 STREET GRADES
REV 9-1-78 PER CITY OF WEST LINN

ROSEMARIE PARK

DE BOK ROAD
AS BUILT NOV. 6, 1978

