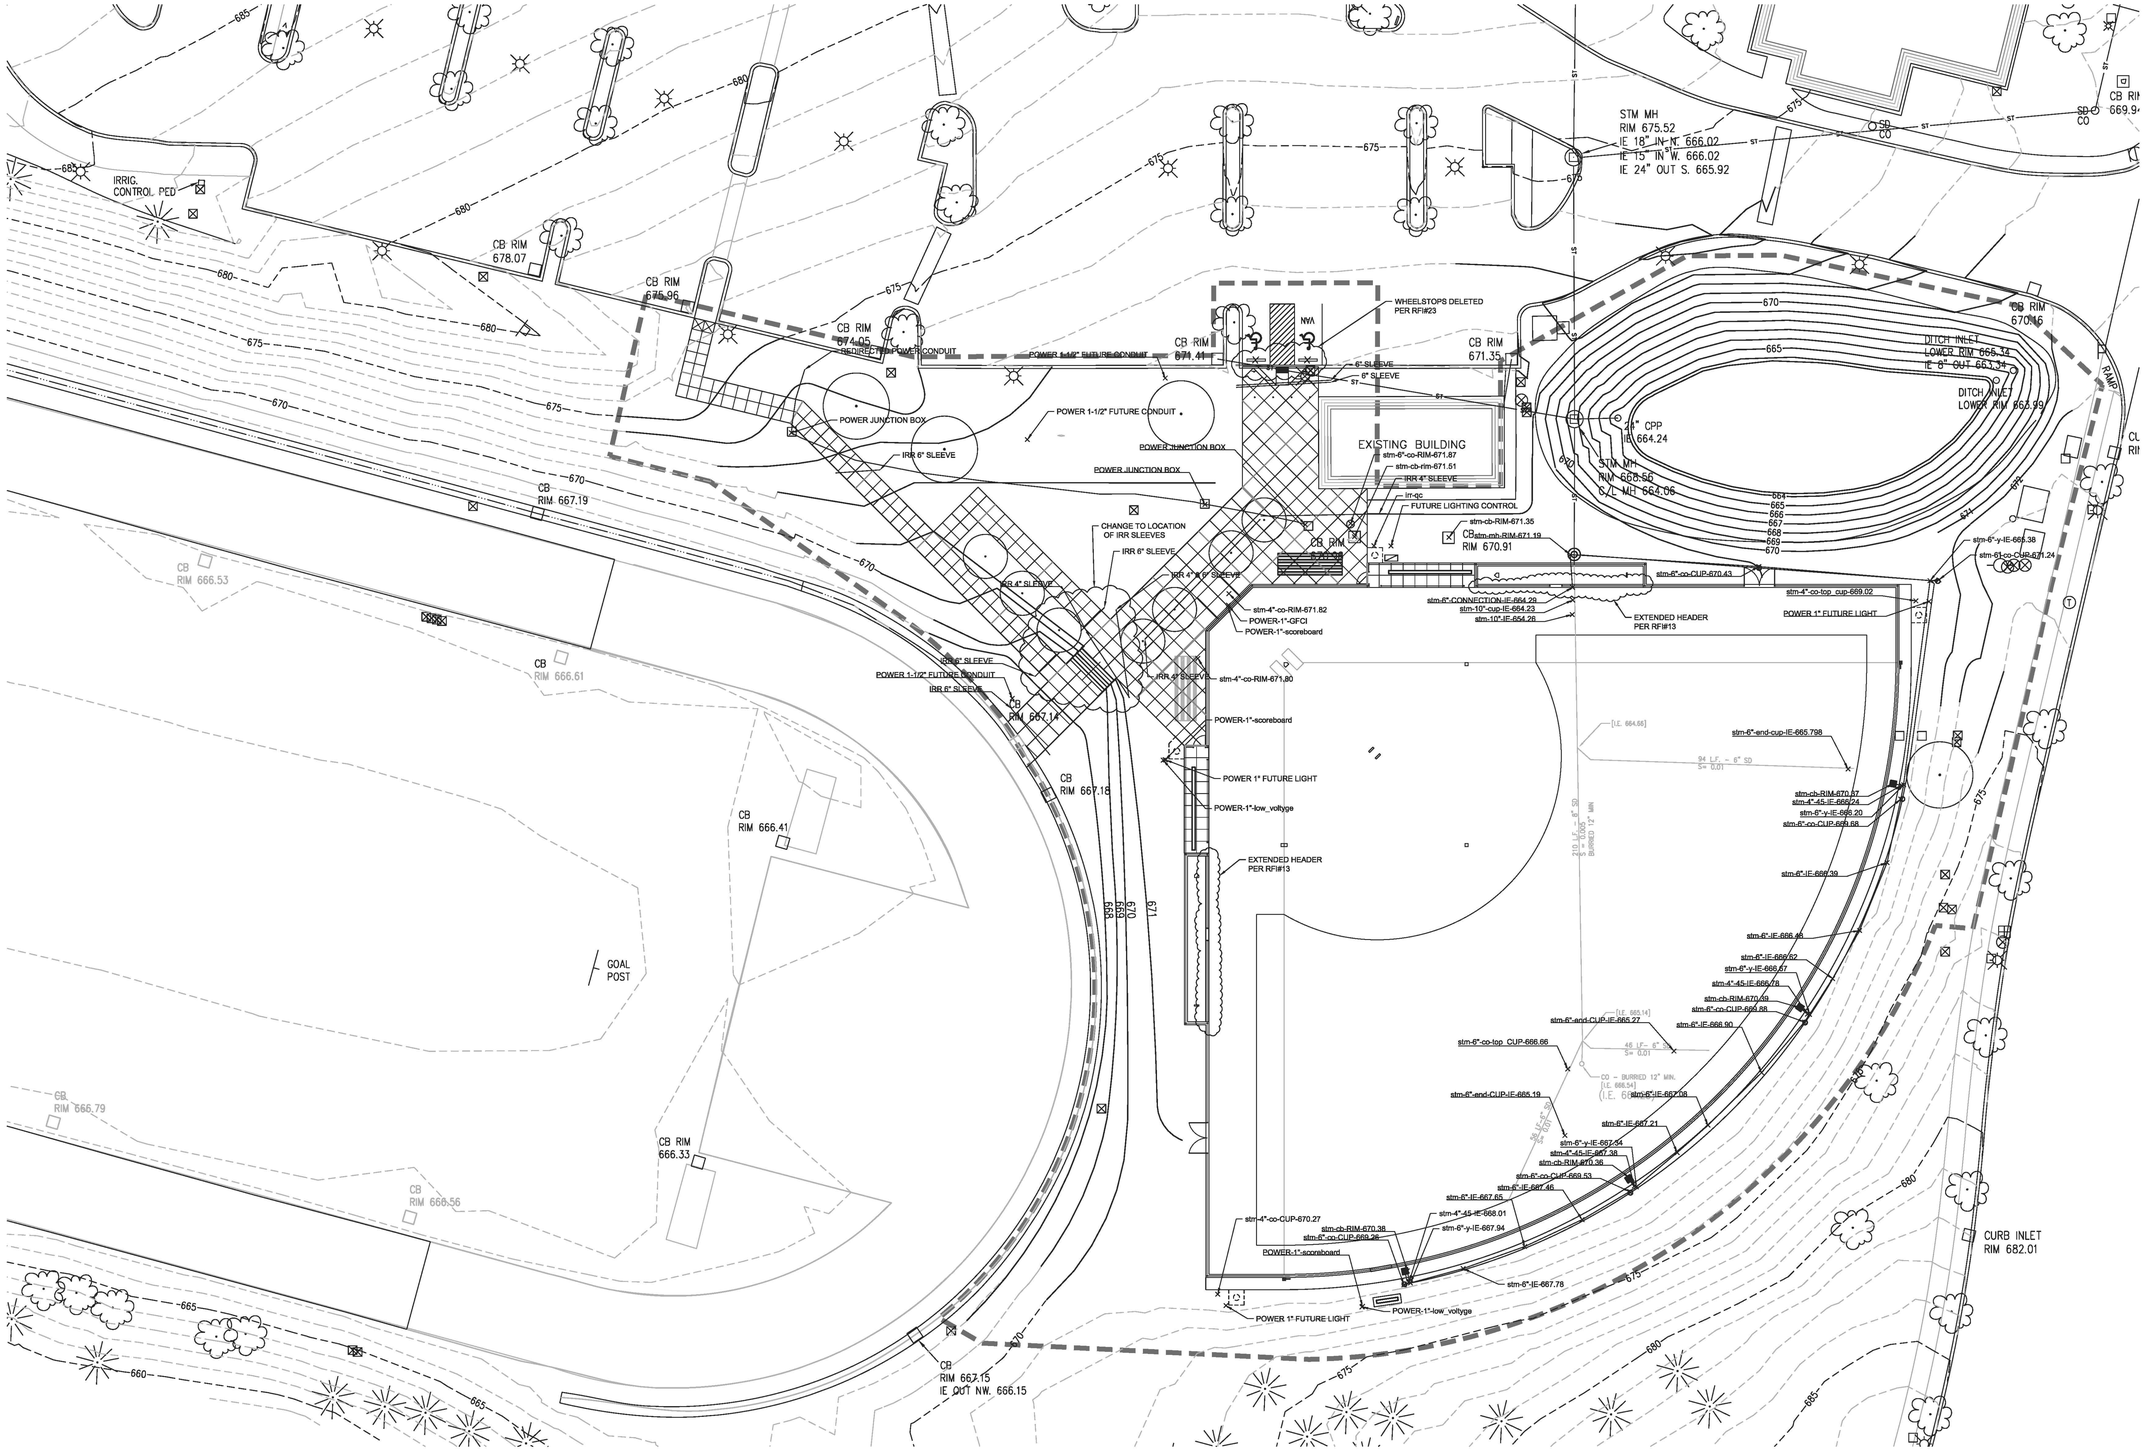

☑ NO EXCEPTIONS NOTED
☐ REVISE AND RESUBMIT
☐ REVIEWED AND PROCEED AS NOTED
☐ NOT REVIEWED
☐ DISAPPROVED

Reviewed only for general conformance with the design concept of the Project and general compliance with the information given in the Contract Documents. This review does not affect the Contractor's responsibility to perform all Contract requirements with no changes in Contract price or time. Any actions shown are subject to the requirements of the Contract Documents. Contractor is responsible to confirm and correlate dimensions at the site, for information that pertains solely to the fabrication processes, for the means, methods, techniques, procedures, sequences and quantities necessary to complete the Contract and for coordination of the work of all trades and the satisfactory performance of their work. Any review is undertaken solely to satisfy Landscape Architect's obligations, if any, to the Owner and/or Client and shall not give rise to any claim by the Contractor or other parties against Landscape Architect, Owner, or Client.

BY Gary Datka DATE April 9, 2010

Walker Macy Landscape Architects - Portland, Oregon
503.228.3122 www.walkermacy.com

0 10 20 40
SCALE: 1"=20'-0"

NORTH

dowa
ARCHITECTURE + INTERIORS + PLANNING

DULL OLSON WEEKES
architects inc.
907 SW STARK STREET | PORTLAND, OREGON 97205
t: 503 226 6950 f: 503 273 9192 www.dowa.com

WILSONVILLE HS & ROSEMONT RIDGE MS SOFTBALL FIELDS IMPROVEMENTS

West Linn-Wilsonville School District
2755 SW Borland Road
Tualatin, OR 97062
t: (503) 673 7995, f: (503) 638 9143

key plan

phase	AS-BUILT
date	APRIL 06, 2010
revisions	
project #	09015 & 09017
district project #	09016.009

AS-BUILT PLAN

RR-0.0

f:\work\09172\docs\cs\punchlist and closeout\as-built\grading and drainage\rr-asbuilt-submit 10 04 06.dwg 4/15/2010 2:24 PM