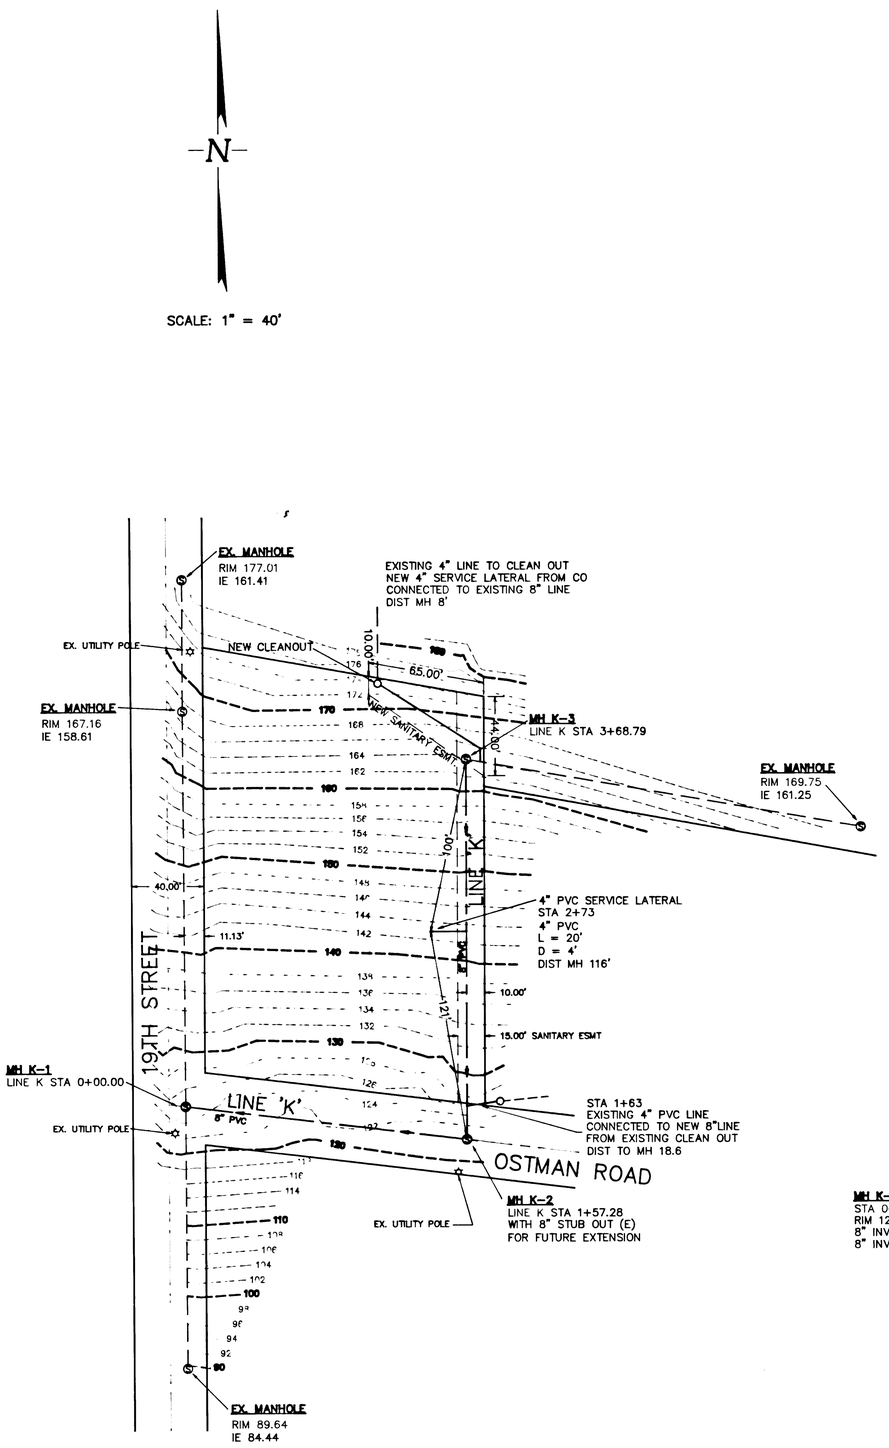

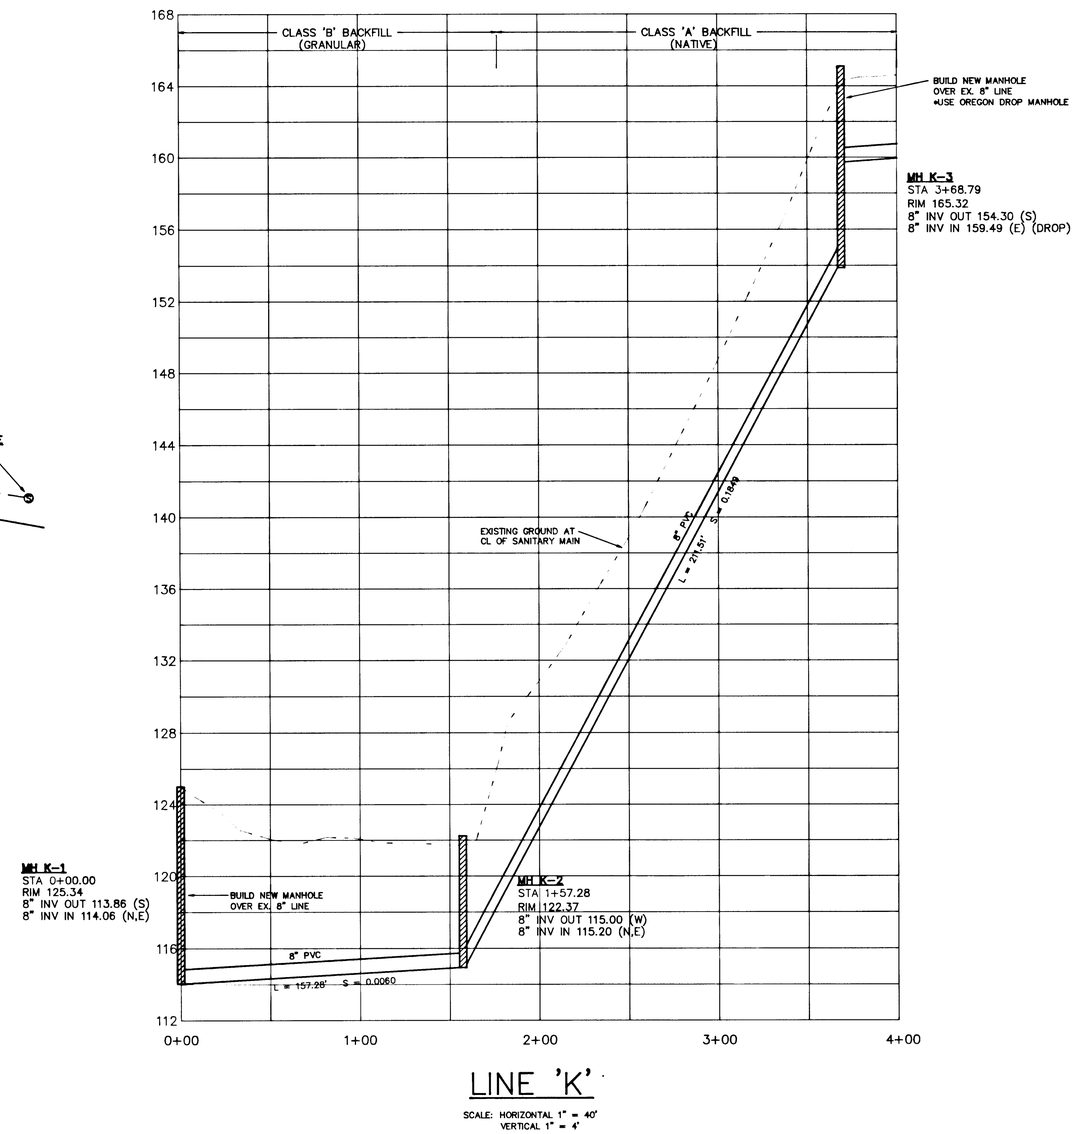

LINE 'K'

SCALE: HORIZONTAL 1" = 40'
VERTICAL 1" = 4'

REGISTERED PROFESSIONAL ENGINEER
12,820
OREGON
Feb. 14, 1985
THOMAS J. SISUL
4/29/94

AS BUILT

REVISIONS	BY
AS BUILT	JSE 4/29/94

SANITARY SEWER RELOCATION

STEWART TITLE / MARIANNE MACINA

Sanitary Sewer Plan

SISUL ENGINEERING
375 PORTLAND AVENUE
GLADSTONE, OREGON 97027
(503) 657-0188

DATE	NOV. 1993
SCALE	1" = 40'
DRAWN	WCS
JOB	93-85
SHEET	1
OF 1	SHEETS