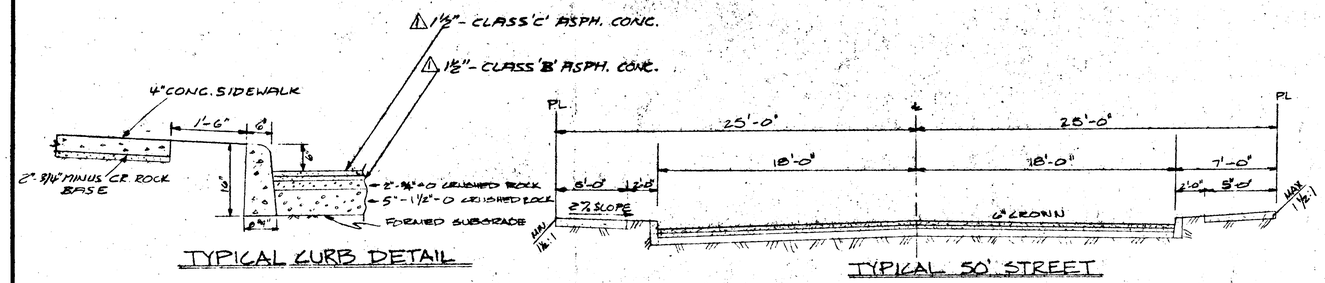

TYPICAL CURB DETAIL

TYPICAL 50' STREET

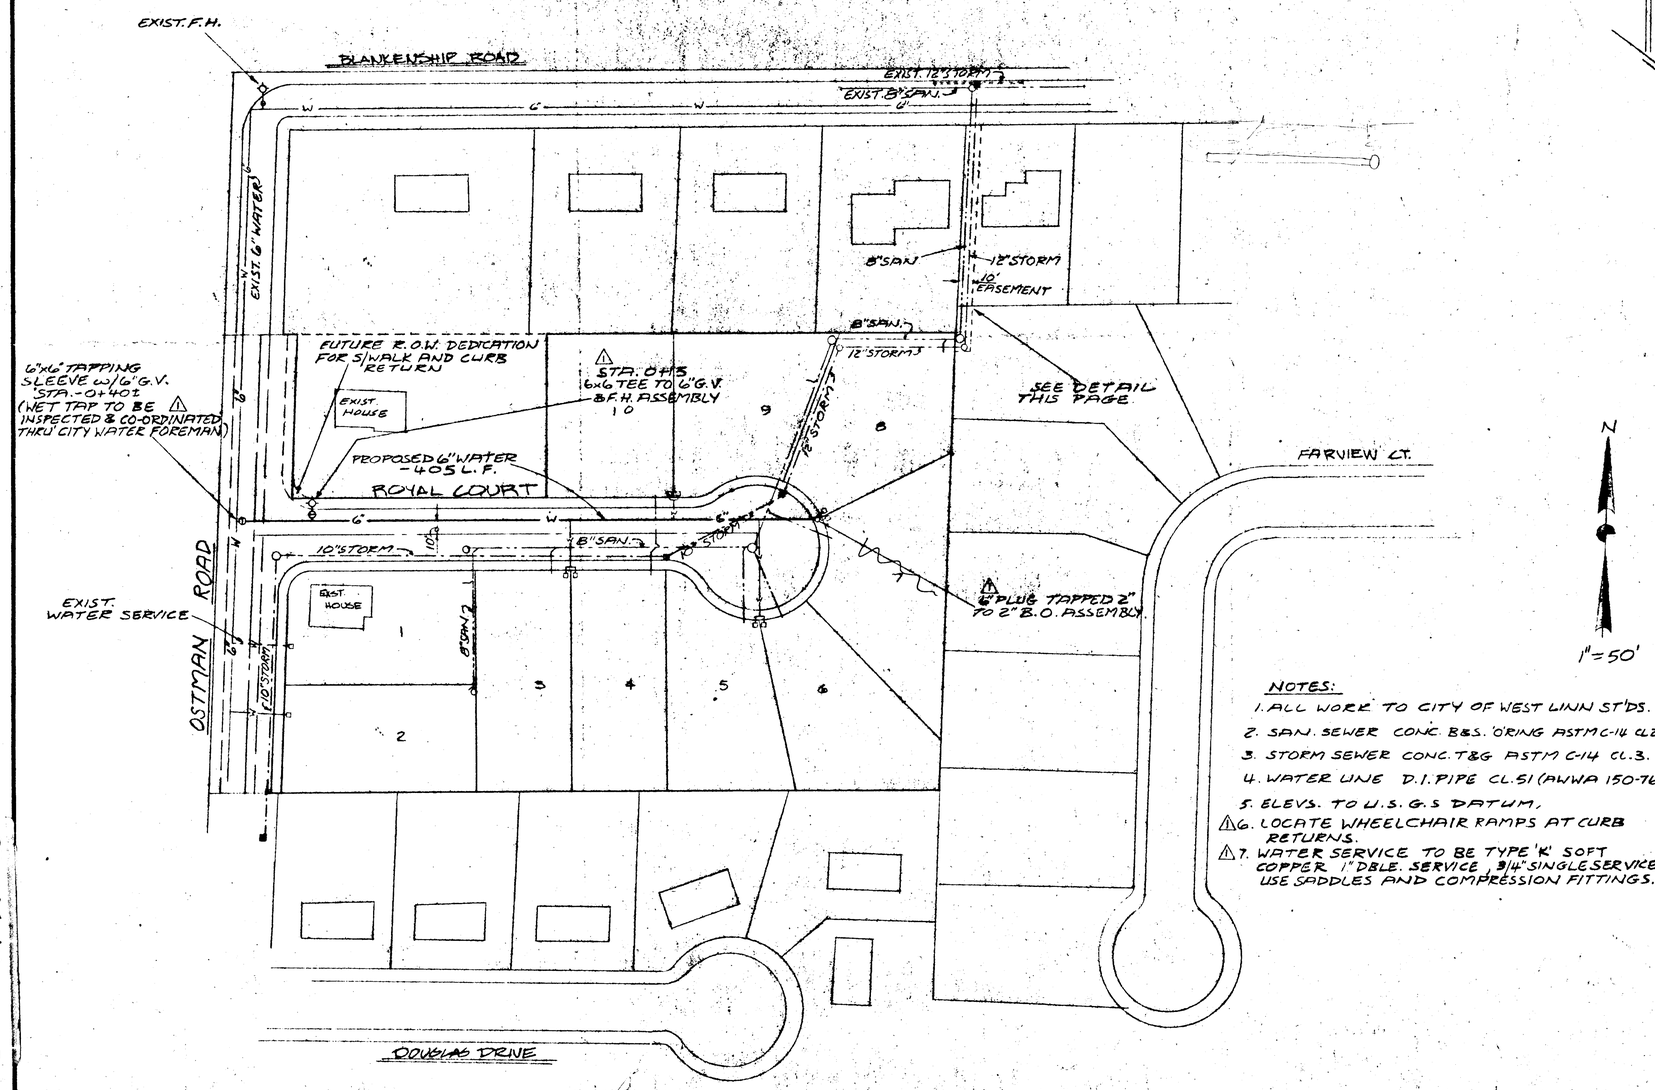

NOTES:

1. ALL WORK TO CITY OF WEST LINN ST'DS.
2. SAN. SEWER CONC. B&S. 'O'RING ASTM C-14 CL2.
3. STORM SEWER CONC. T&G ASTM C-14 CL.3.
4. WATER LINE D.I. PIPE CL.51 (AWWA 150-76)
5. ELEVS. TO U.S.G.S DATUM.
6. LOCATE WHEELCHAIR RAMPS AT CURB RETURNS.
7. WATER SERVICE TO BE TYPE 'K' SOFT COPPER 1" DBLE. SERVICE, 3/4" SINGLE SERVICE. USE SADDLES AND COMPRESSION FITTINGS.

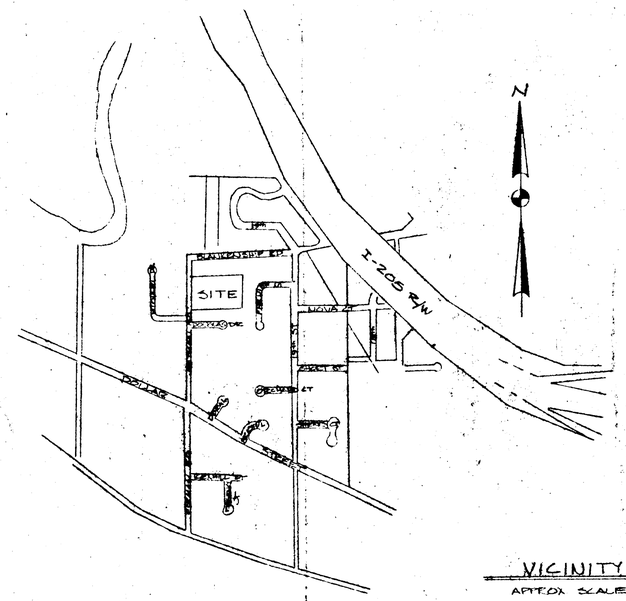

VICINITY MAP
APPROX SCALE 1"=600'

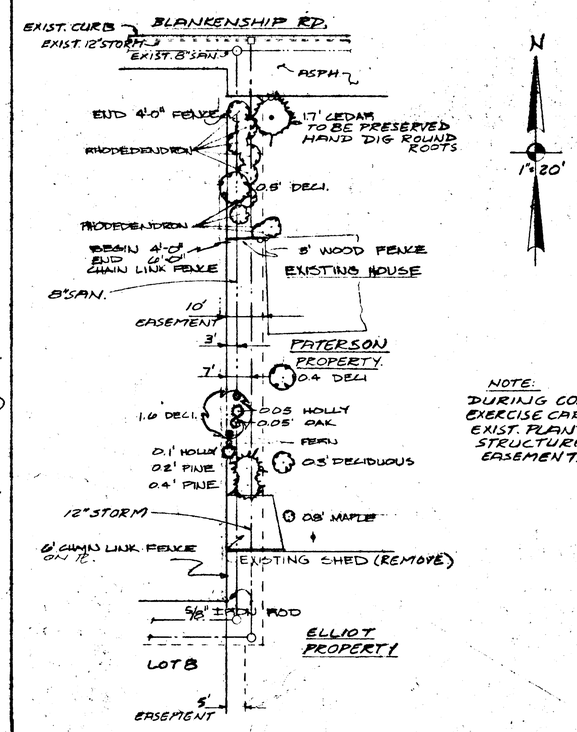

NOTE:
DURING CONSTRUCTION EXERCISE CARE TO SAVE EXIST. PLANTS AND STRUCTURES OUTSIDE EASEMENT.

SAN. & STORM OUTFALL DETAIL
1"=20'

PRINTED
MAY 3 1979

REVISIONS	BY
1. 8-8-78	J.M.

MR. RAY DRIESEL
SELLERS ADDITION
WEST LINN, OREGON.

REGISTERED PROFESSIONAL ENGINEER
OREGON
NOV. 4, 1974
RONALD G. TATONE

ZAROSINSKI-TATONE ENGINEERS, INC.
3737 S.E. 8TH AVENUE, PORTLAND, OREGON 97202
PHONE: (503) 235-8795

DEVELOPMENT PLAN AND WATER DISTRIBUTION

DATE 7-6-78
SCALE AS NOTED
DRAWN J. McL.M.
JOB 767-2
SHEET 1 OF 2 SHEETS

SELLERS ADD. 78

CASCADE A & E SUPPLIES CO., PORTLAND

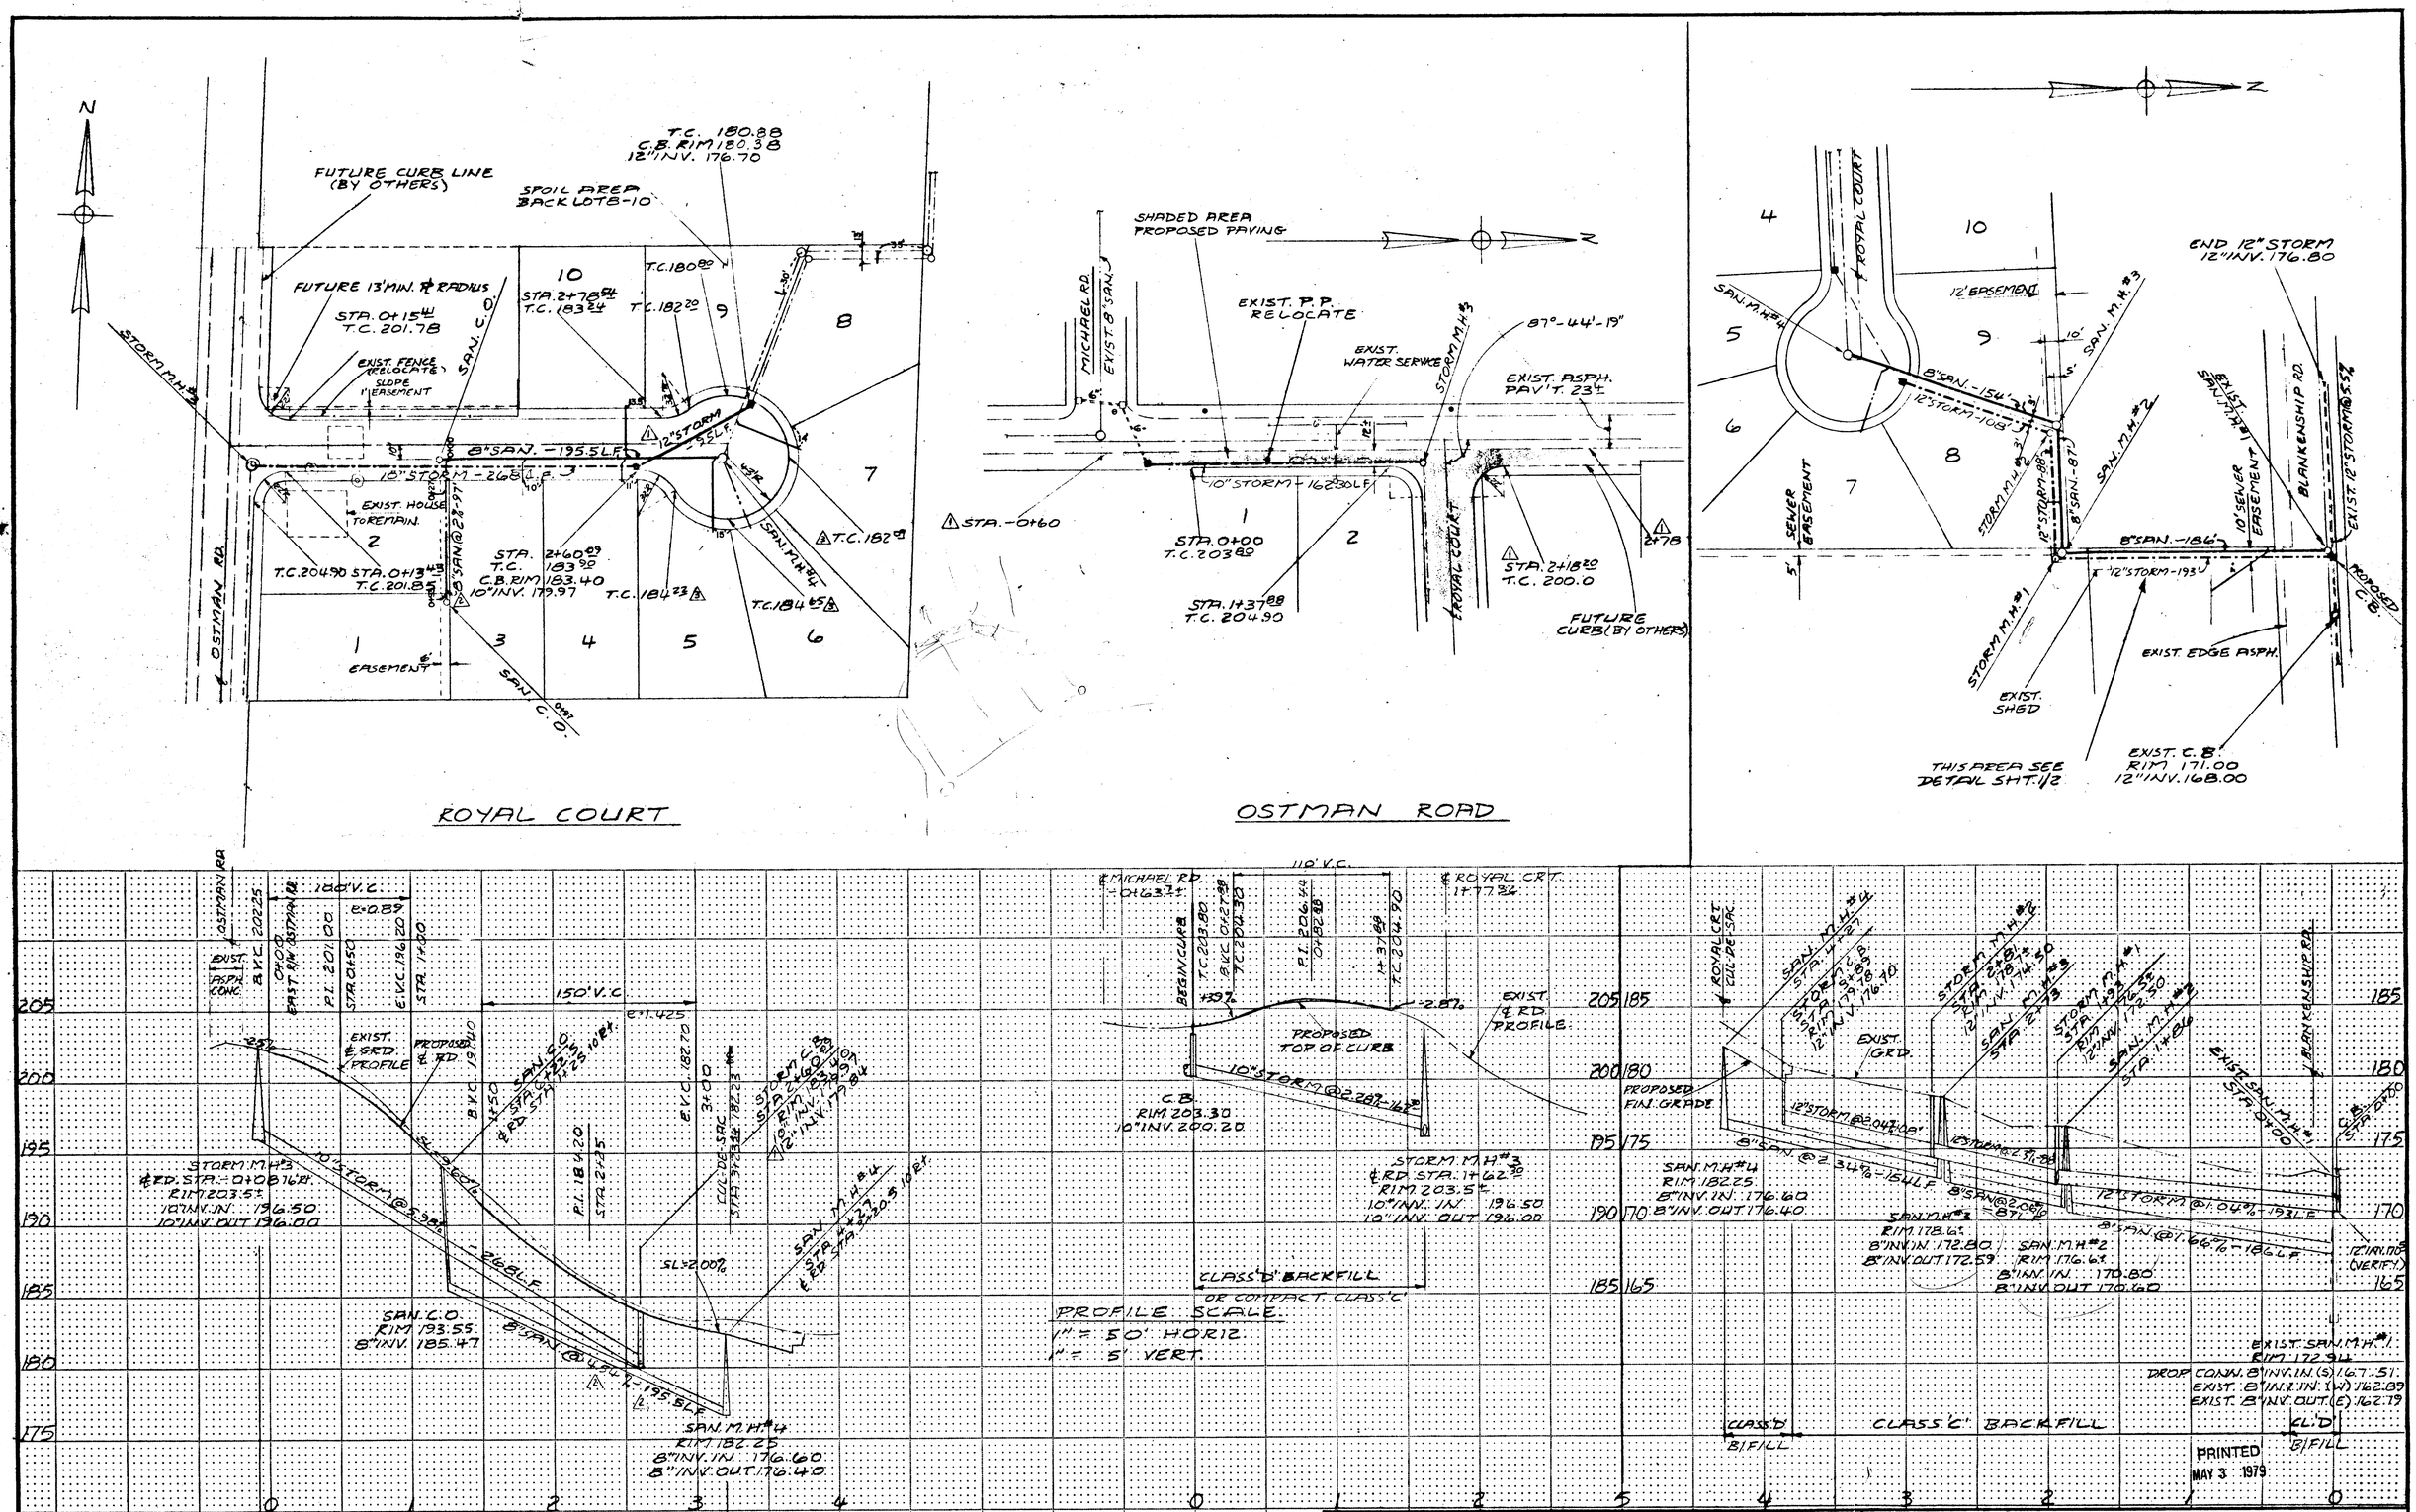

REVISIONS		
Date	Description	By
8-8-78	1 CITY REQUIREMENTS	J.M.
8-10-78	2 SAN. SEWER	J.M.
9-18-78	3 CUL-DE-SAC ELEVS	J.M.
3-23-79	AS BUILT ADDED	J.M.

DRAWN: J.M.C.M. CHECKED: R.G.T.
SCALE: 1" = 50 DATE: 6-23-78

ZAROSINSKI-TATONE ENGINEERS, INC.
3737 S.E. EIGHTH AVE. PORTLAND, ORE.

LOCATED IN S.E. 1/4 SEC. 34
T2S, R1E, W.M.
WEST LINN, OREGON

REGISTERED PROFESSIONAL ENGINEER 3919 OREGON JULY 4, 1978 RONALD G. TATONE

MR. RAY DRIESEL
SELLERS ADDITION
WEST LINN, OREGON.

PLAN AND PROFILE
ROYAL CRT. AND OSTMAN RD.

JOB NO. 7616
2/2

CASCADE ARCHITECTURAL AND ENGINEERING SUPPLIES CO. PORTLAND OREGON