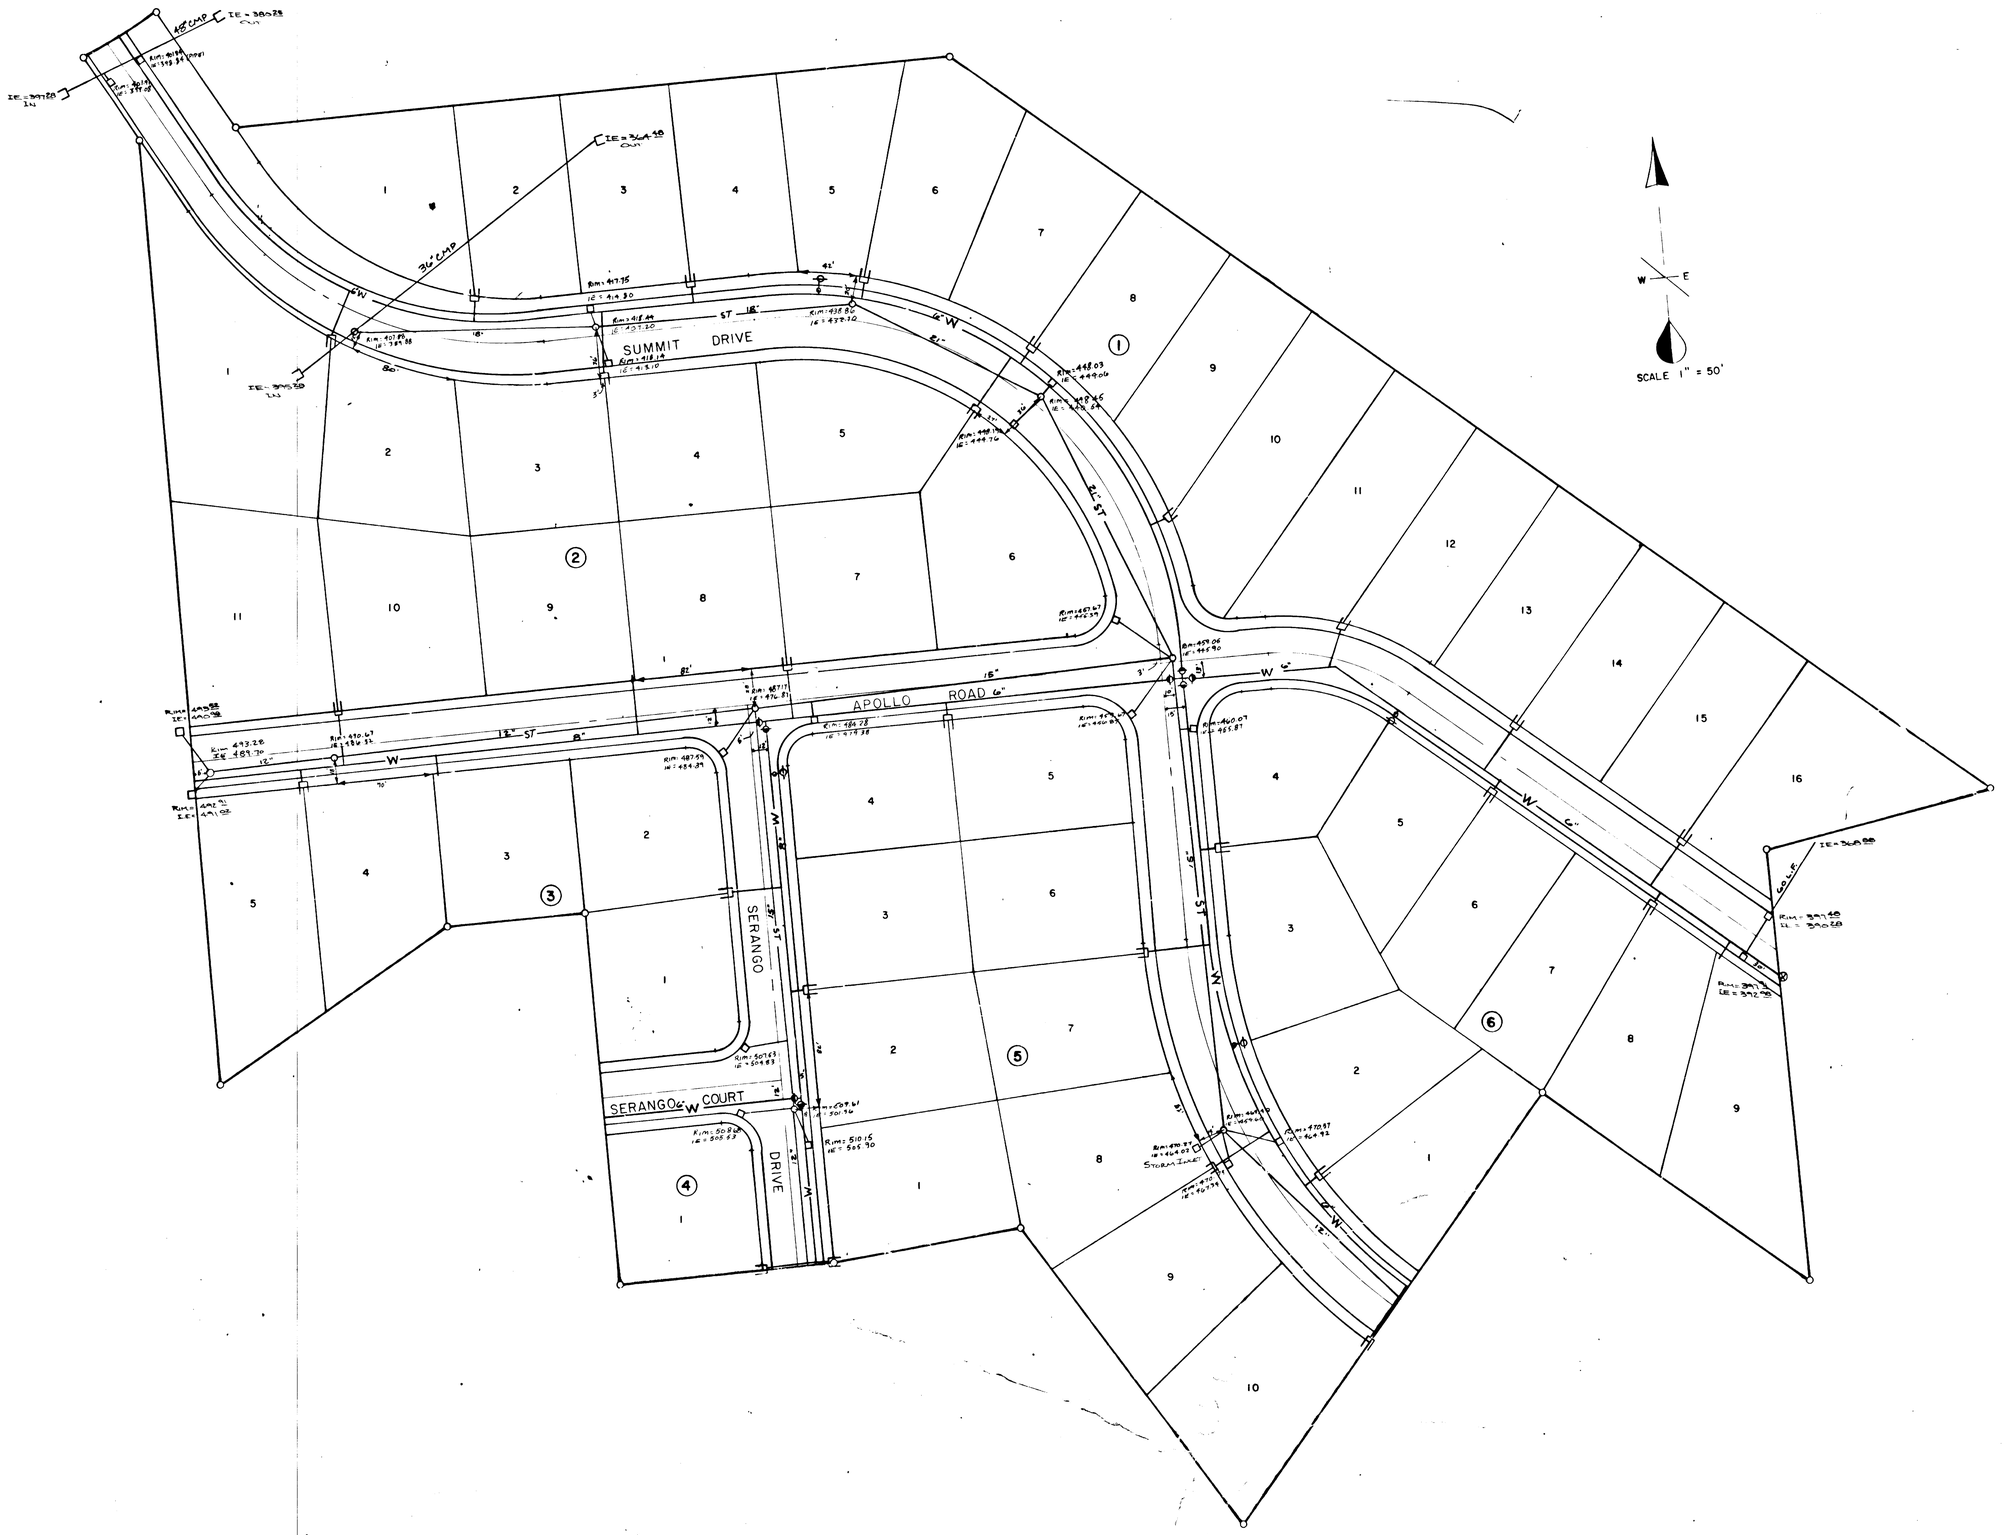

DATE NO BY REVISION	DRAFT DESIGN DATE JAN 1980 KD FILE	PROFESSIONAL LAND SERVICES 323 SE 3RD HILLSBORO, ORE 648-2019	CHARLES GOTANDA P.O. BOX 9410 BAKERSFIELD, CAL. 93389	SERANGO No. 1 AS BUILTS	STORM SEWER & WATER

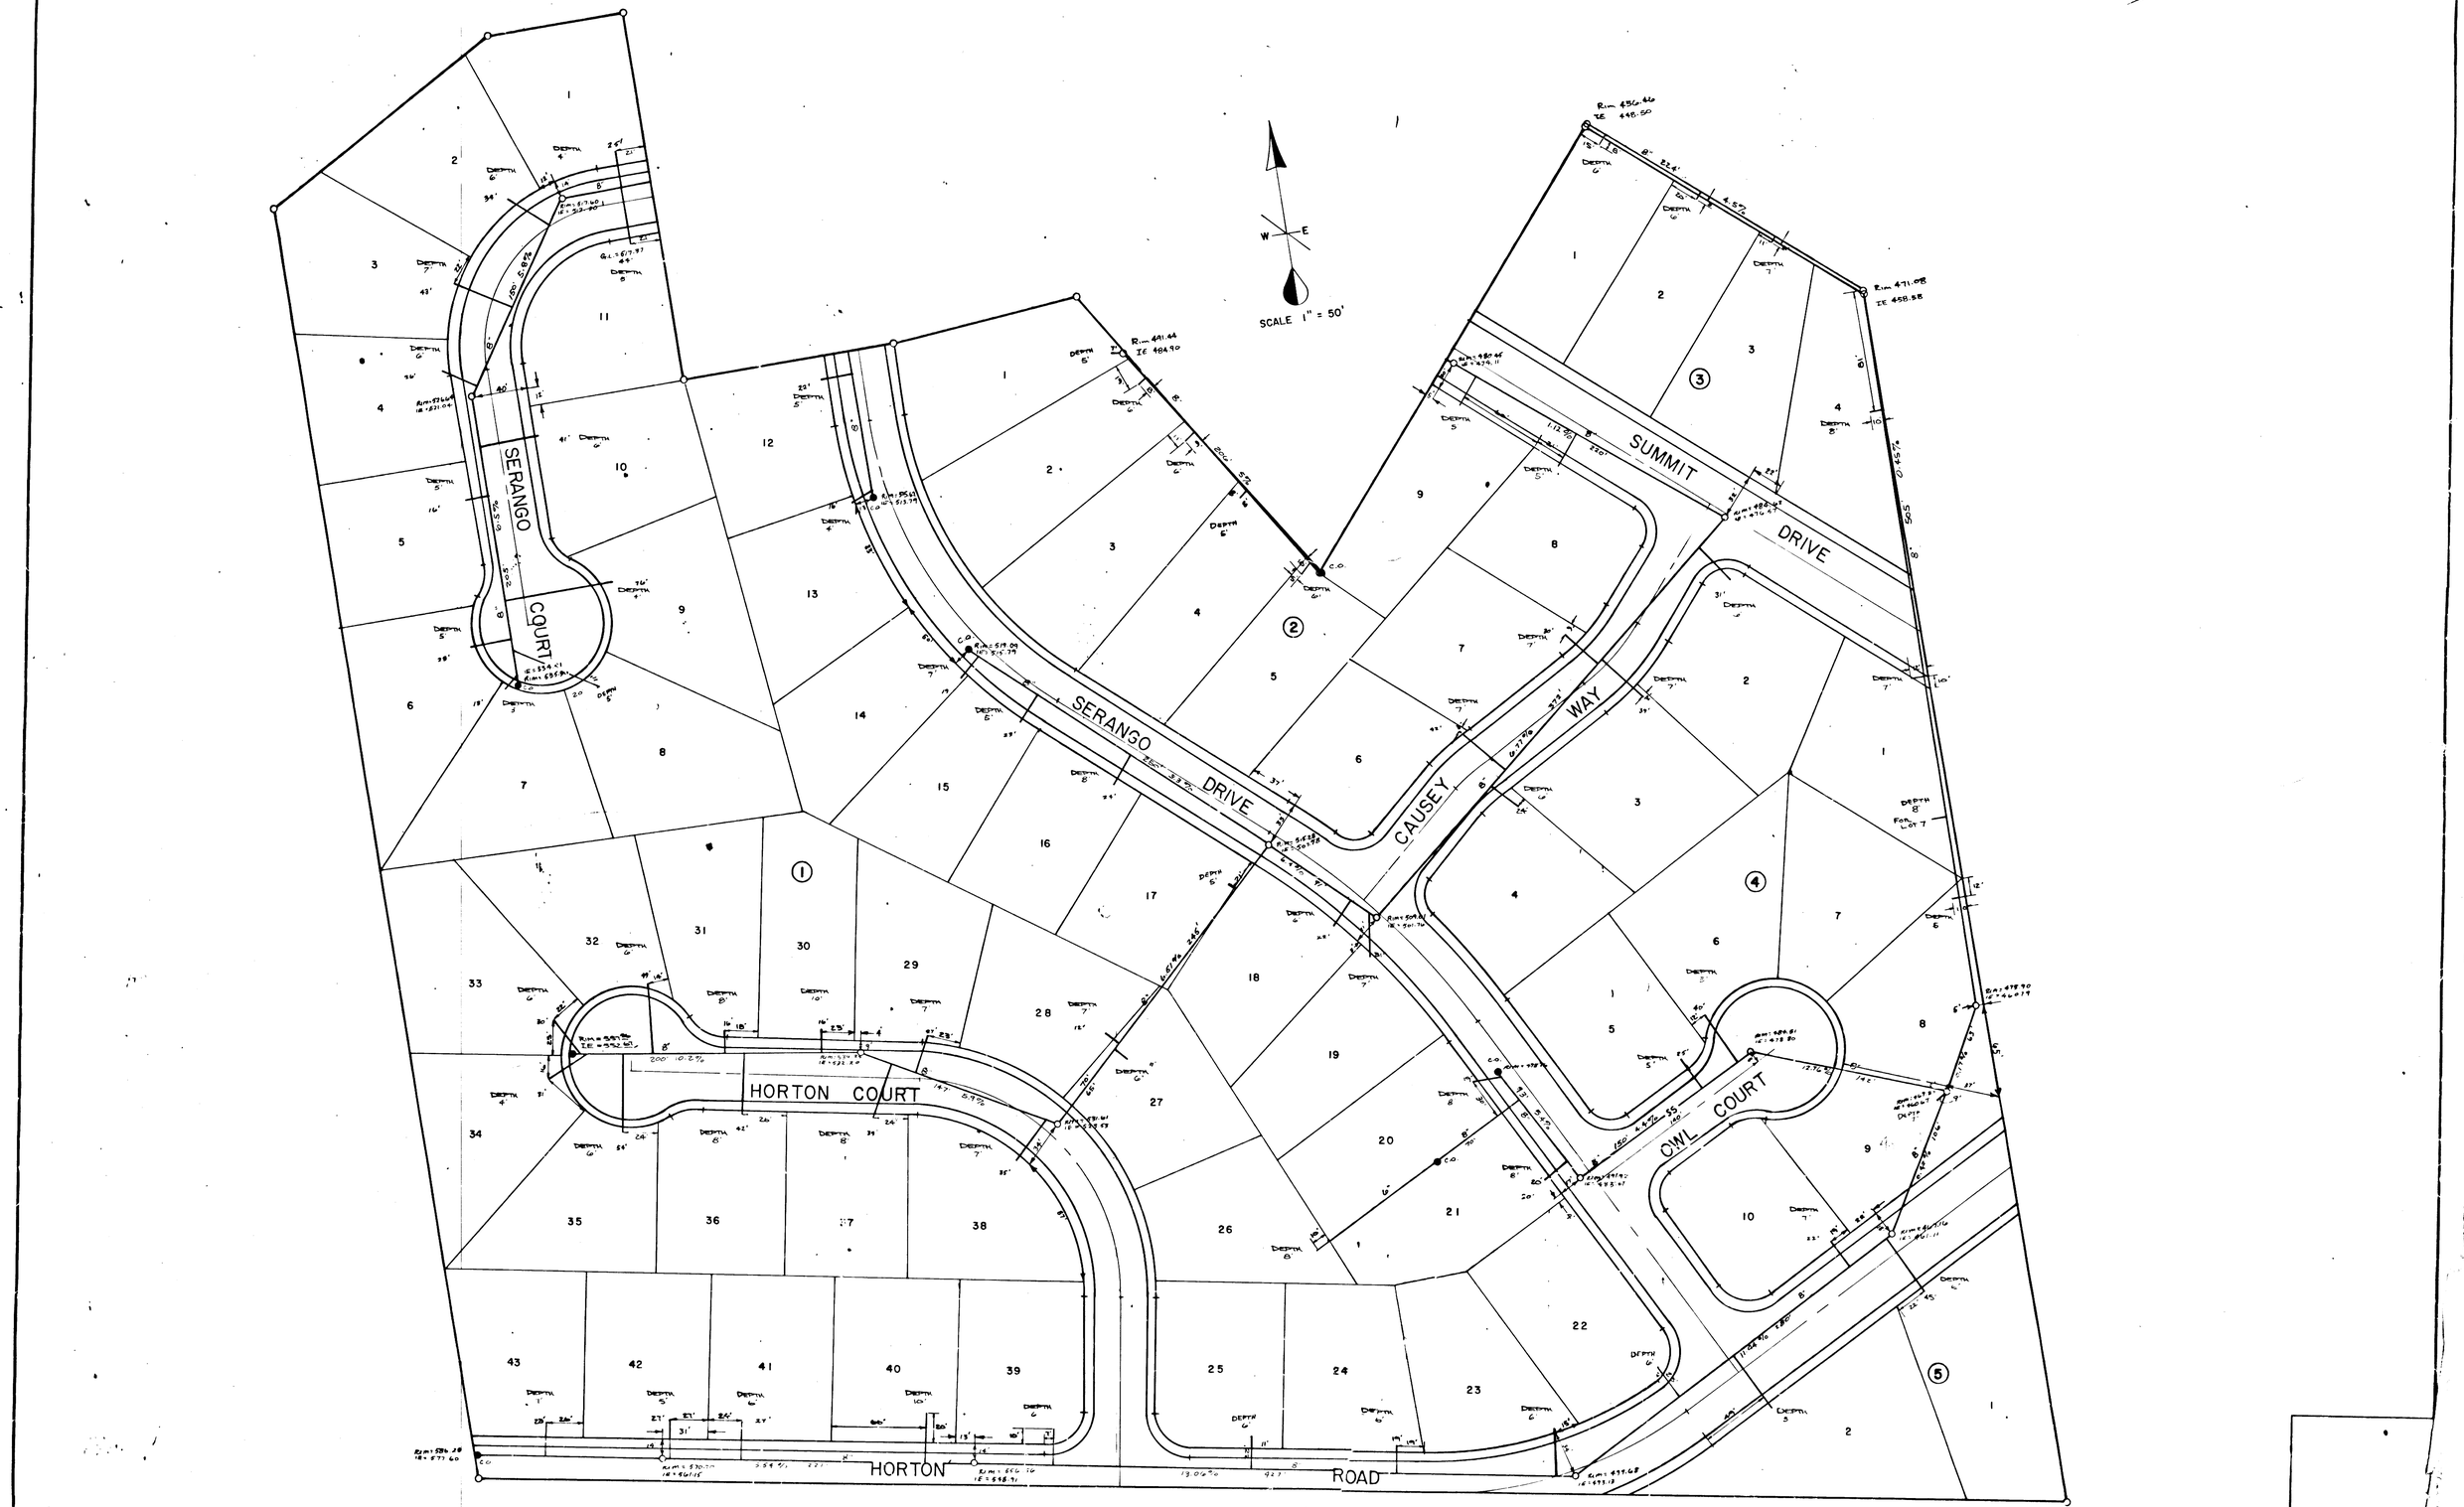

DRAFT/ DESIGN	PROFESSIONAL LAND SERVICES	CLIENT	CHARLES GOTANDA	SERANGO No. 2 AS BUILTS	SANITARY SEWER PLAN
DATE JAN. 1980 CK'D	323 SE 3RD HILLSBORO, ORE		P.O. BOX 9410		
FILE	648-2019		BAKERSFIELD, CAL. 93389		
USE NO BY REVISION					

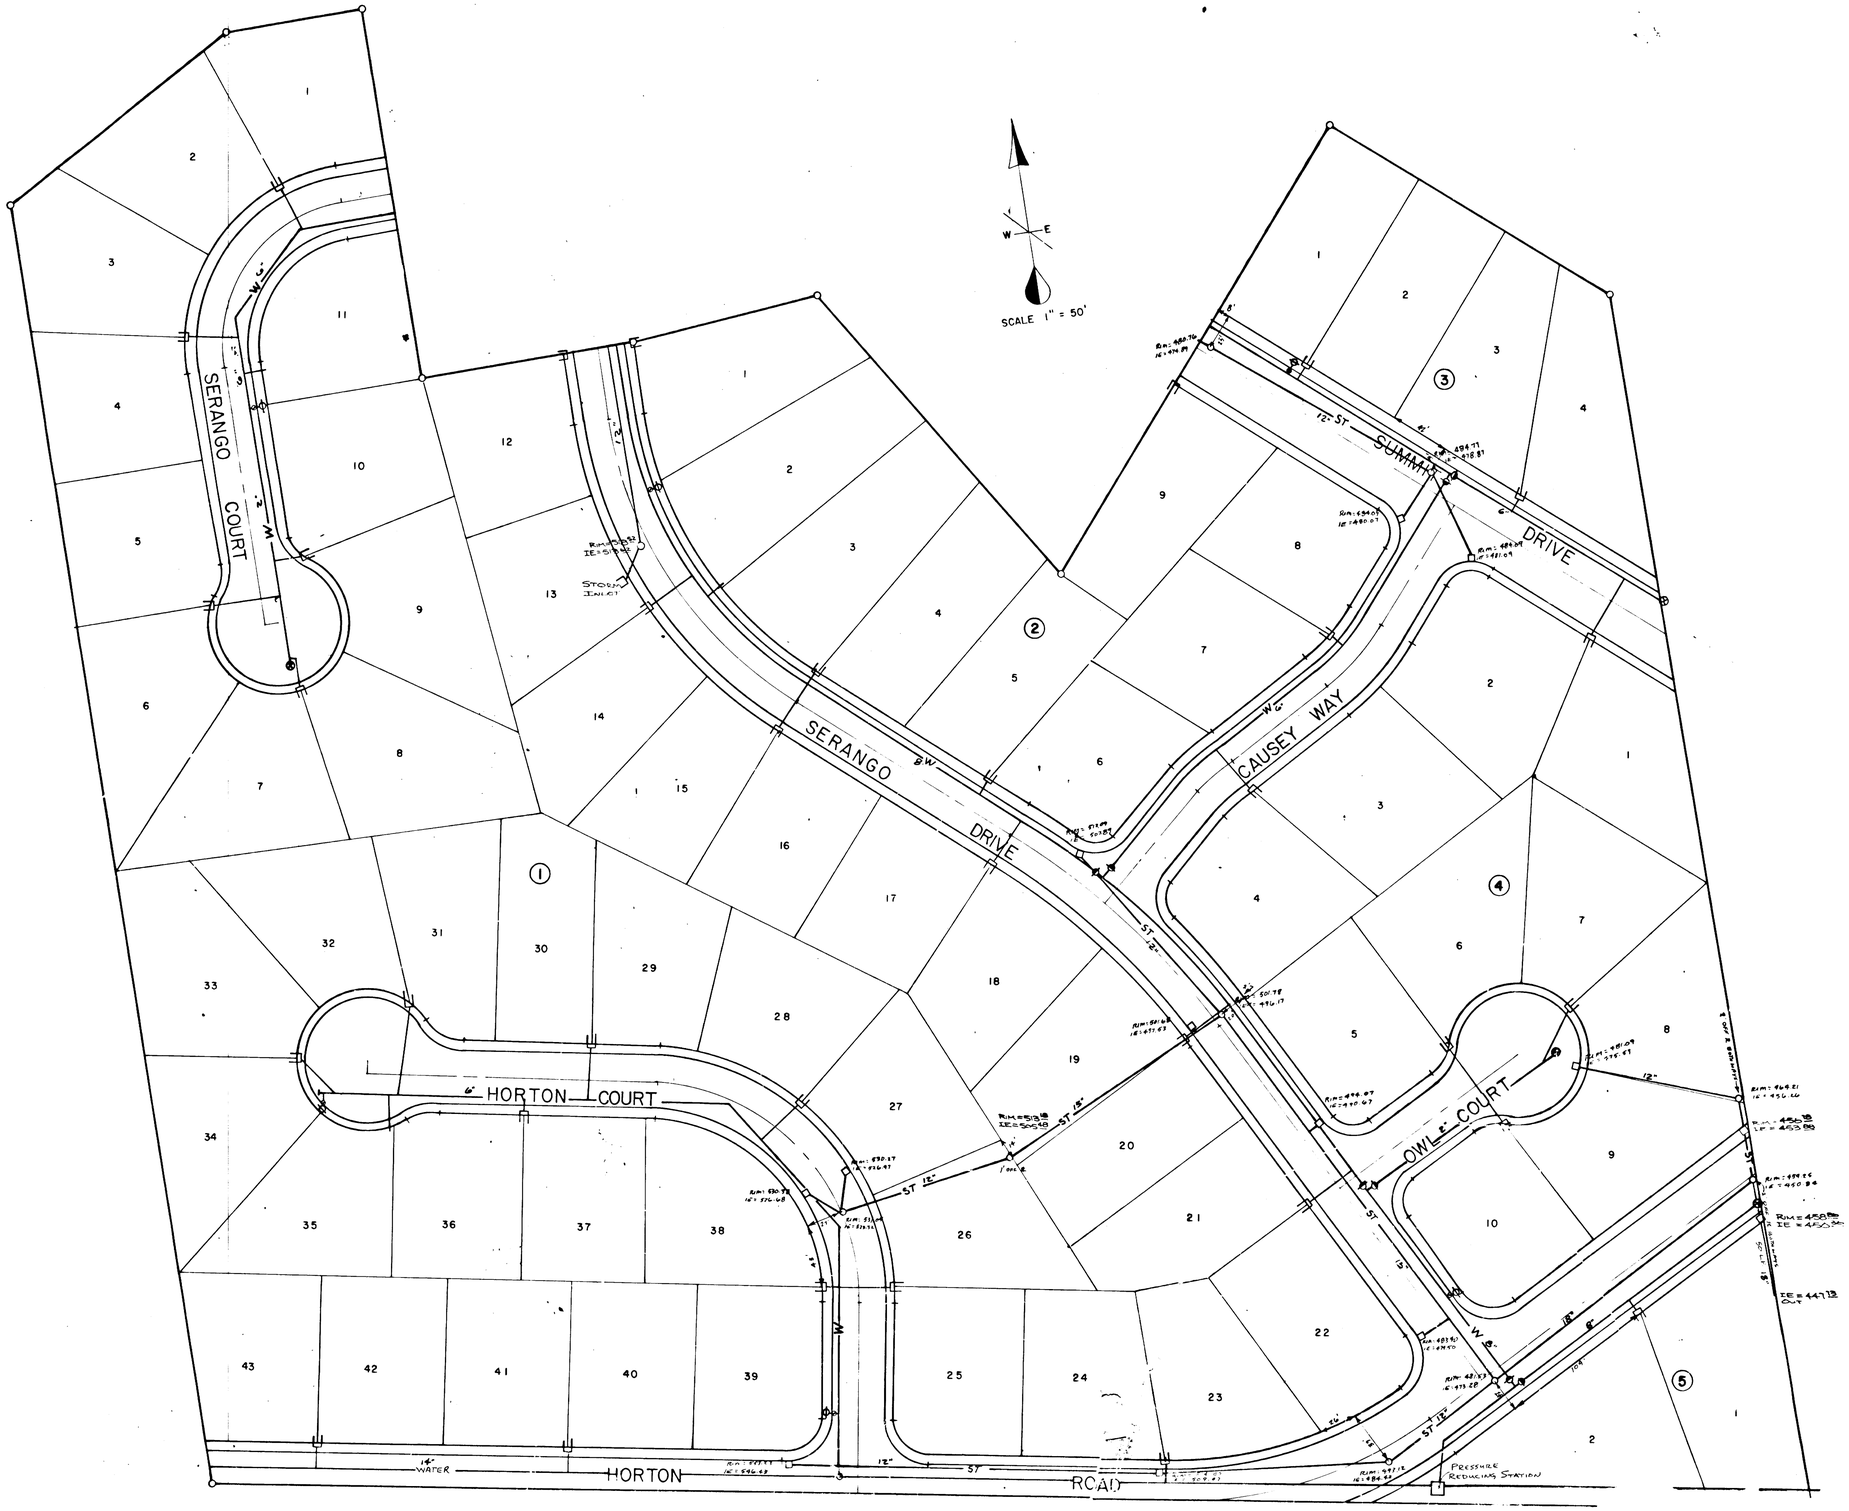

DATE	NO	BY	REVISION	CHIEF DESIGN
				DATE Jan. 1985 L.H.D.
				FILE

PROFESSIONAL LAND SERVICES

323 S.E. 3RD HILLSBORO, OR.

648-2013

CLIENT

CHARLES GOTANDA

P.O. BOX 9410

BAKERSFIELD, CAL. 93389

STORM

Water

SUMMIT DRIVE

APOLLO ROAD

SERANGO

SERANGO COURT

DRIVE

SCALE 1" = 50'

W — E

House Service Lot # Will Be Installed At Time Building Permit is issued.































































