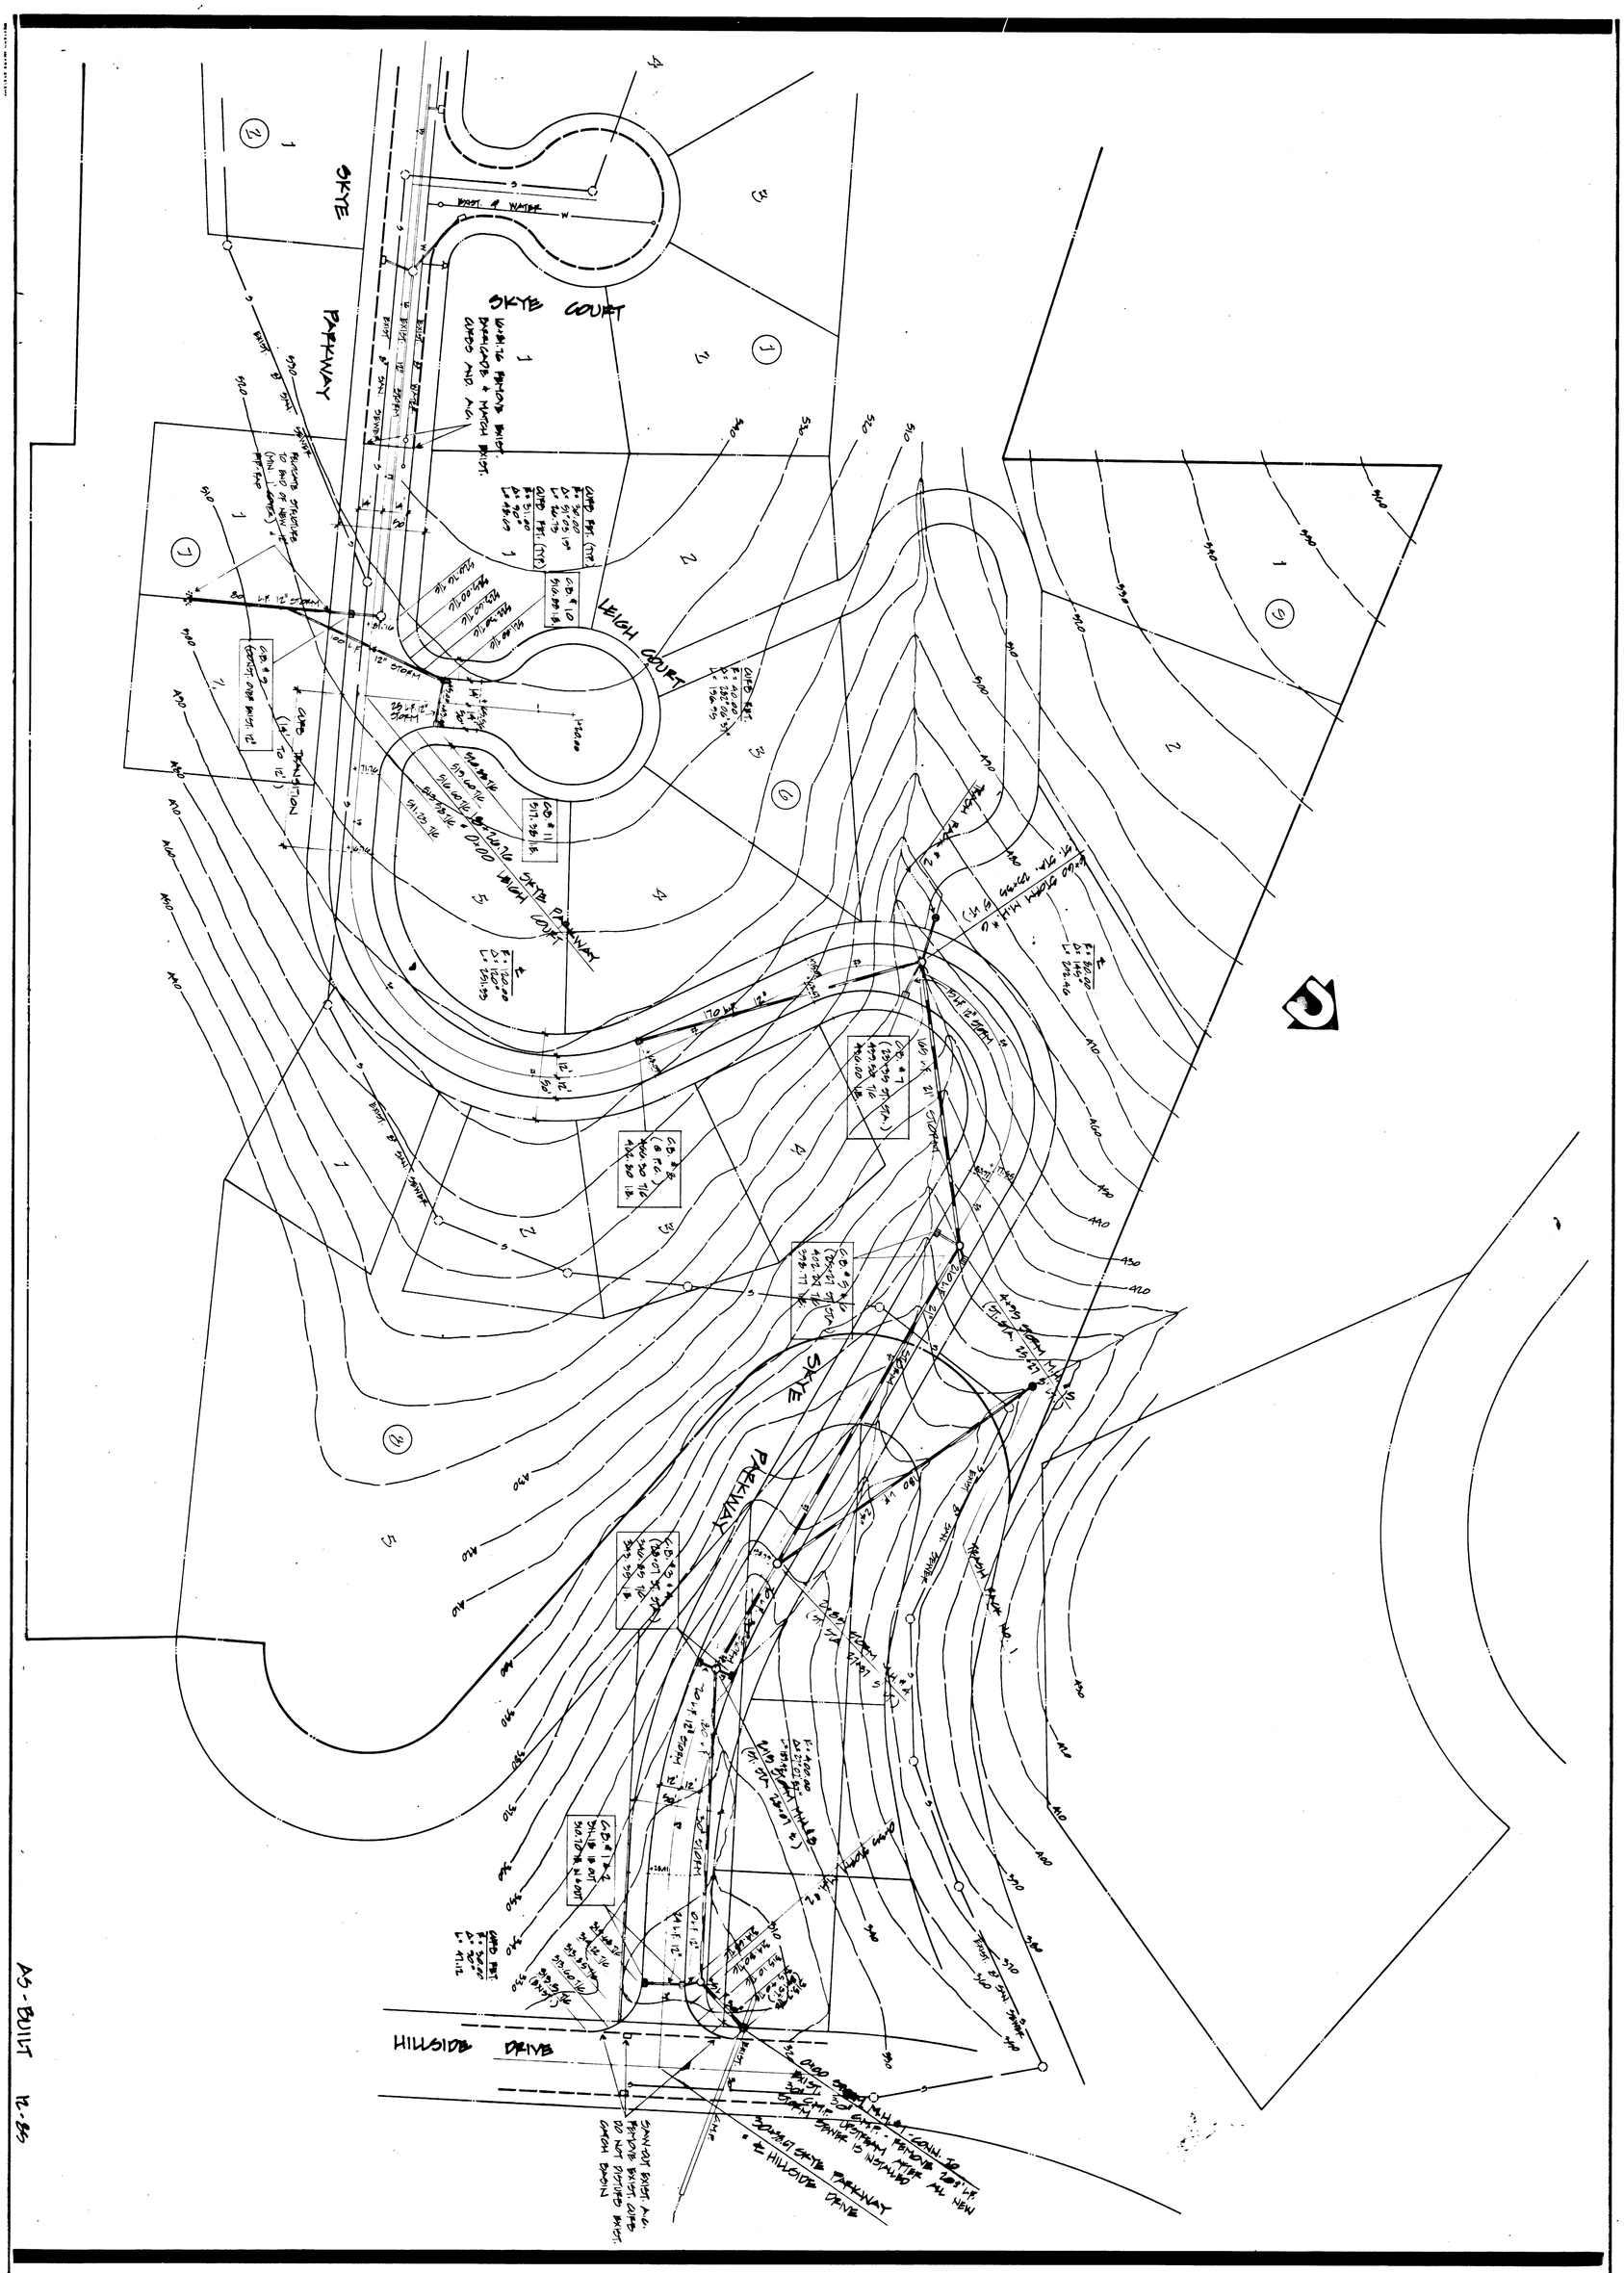

1	OF 5 SHEETS		
SCALE 1" = 40'	DESIGN DG / DFB		
DATE JAN. 1985	DRAWN DHG		
FILE CHI 006	CHECKED DFB		

REVISIONS

DEA
DAVID EVANS AND ASSOCIATES, INC.
2626 SW CORBETT AVE. · PORTLAND, OR 97201 · 503/223-6663

REGISTERED PROFESSIONAL ENGINEER 6577 OREGON JULY 11 1967 DAVID FRANK EVANS

SKYLINE RIDGE 2B

OREGON

STREET AND STORM SEWER PLAN

WEST LINN,
CENTURION HOMES, INC.
4430 CORNWALL STREET
WEST LINN, OREGON 97068

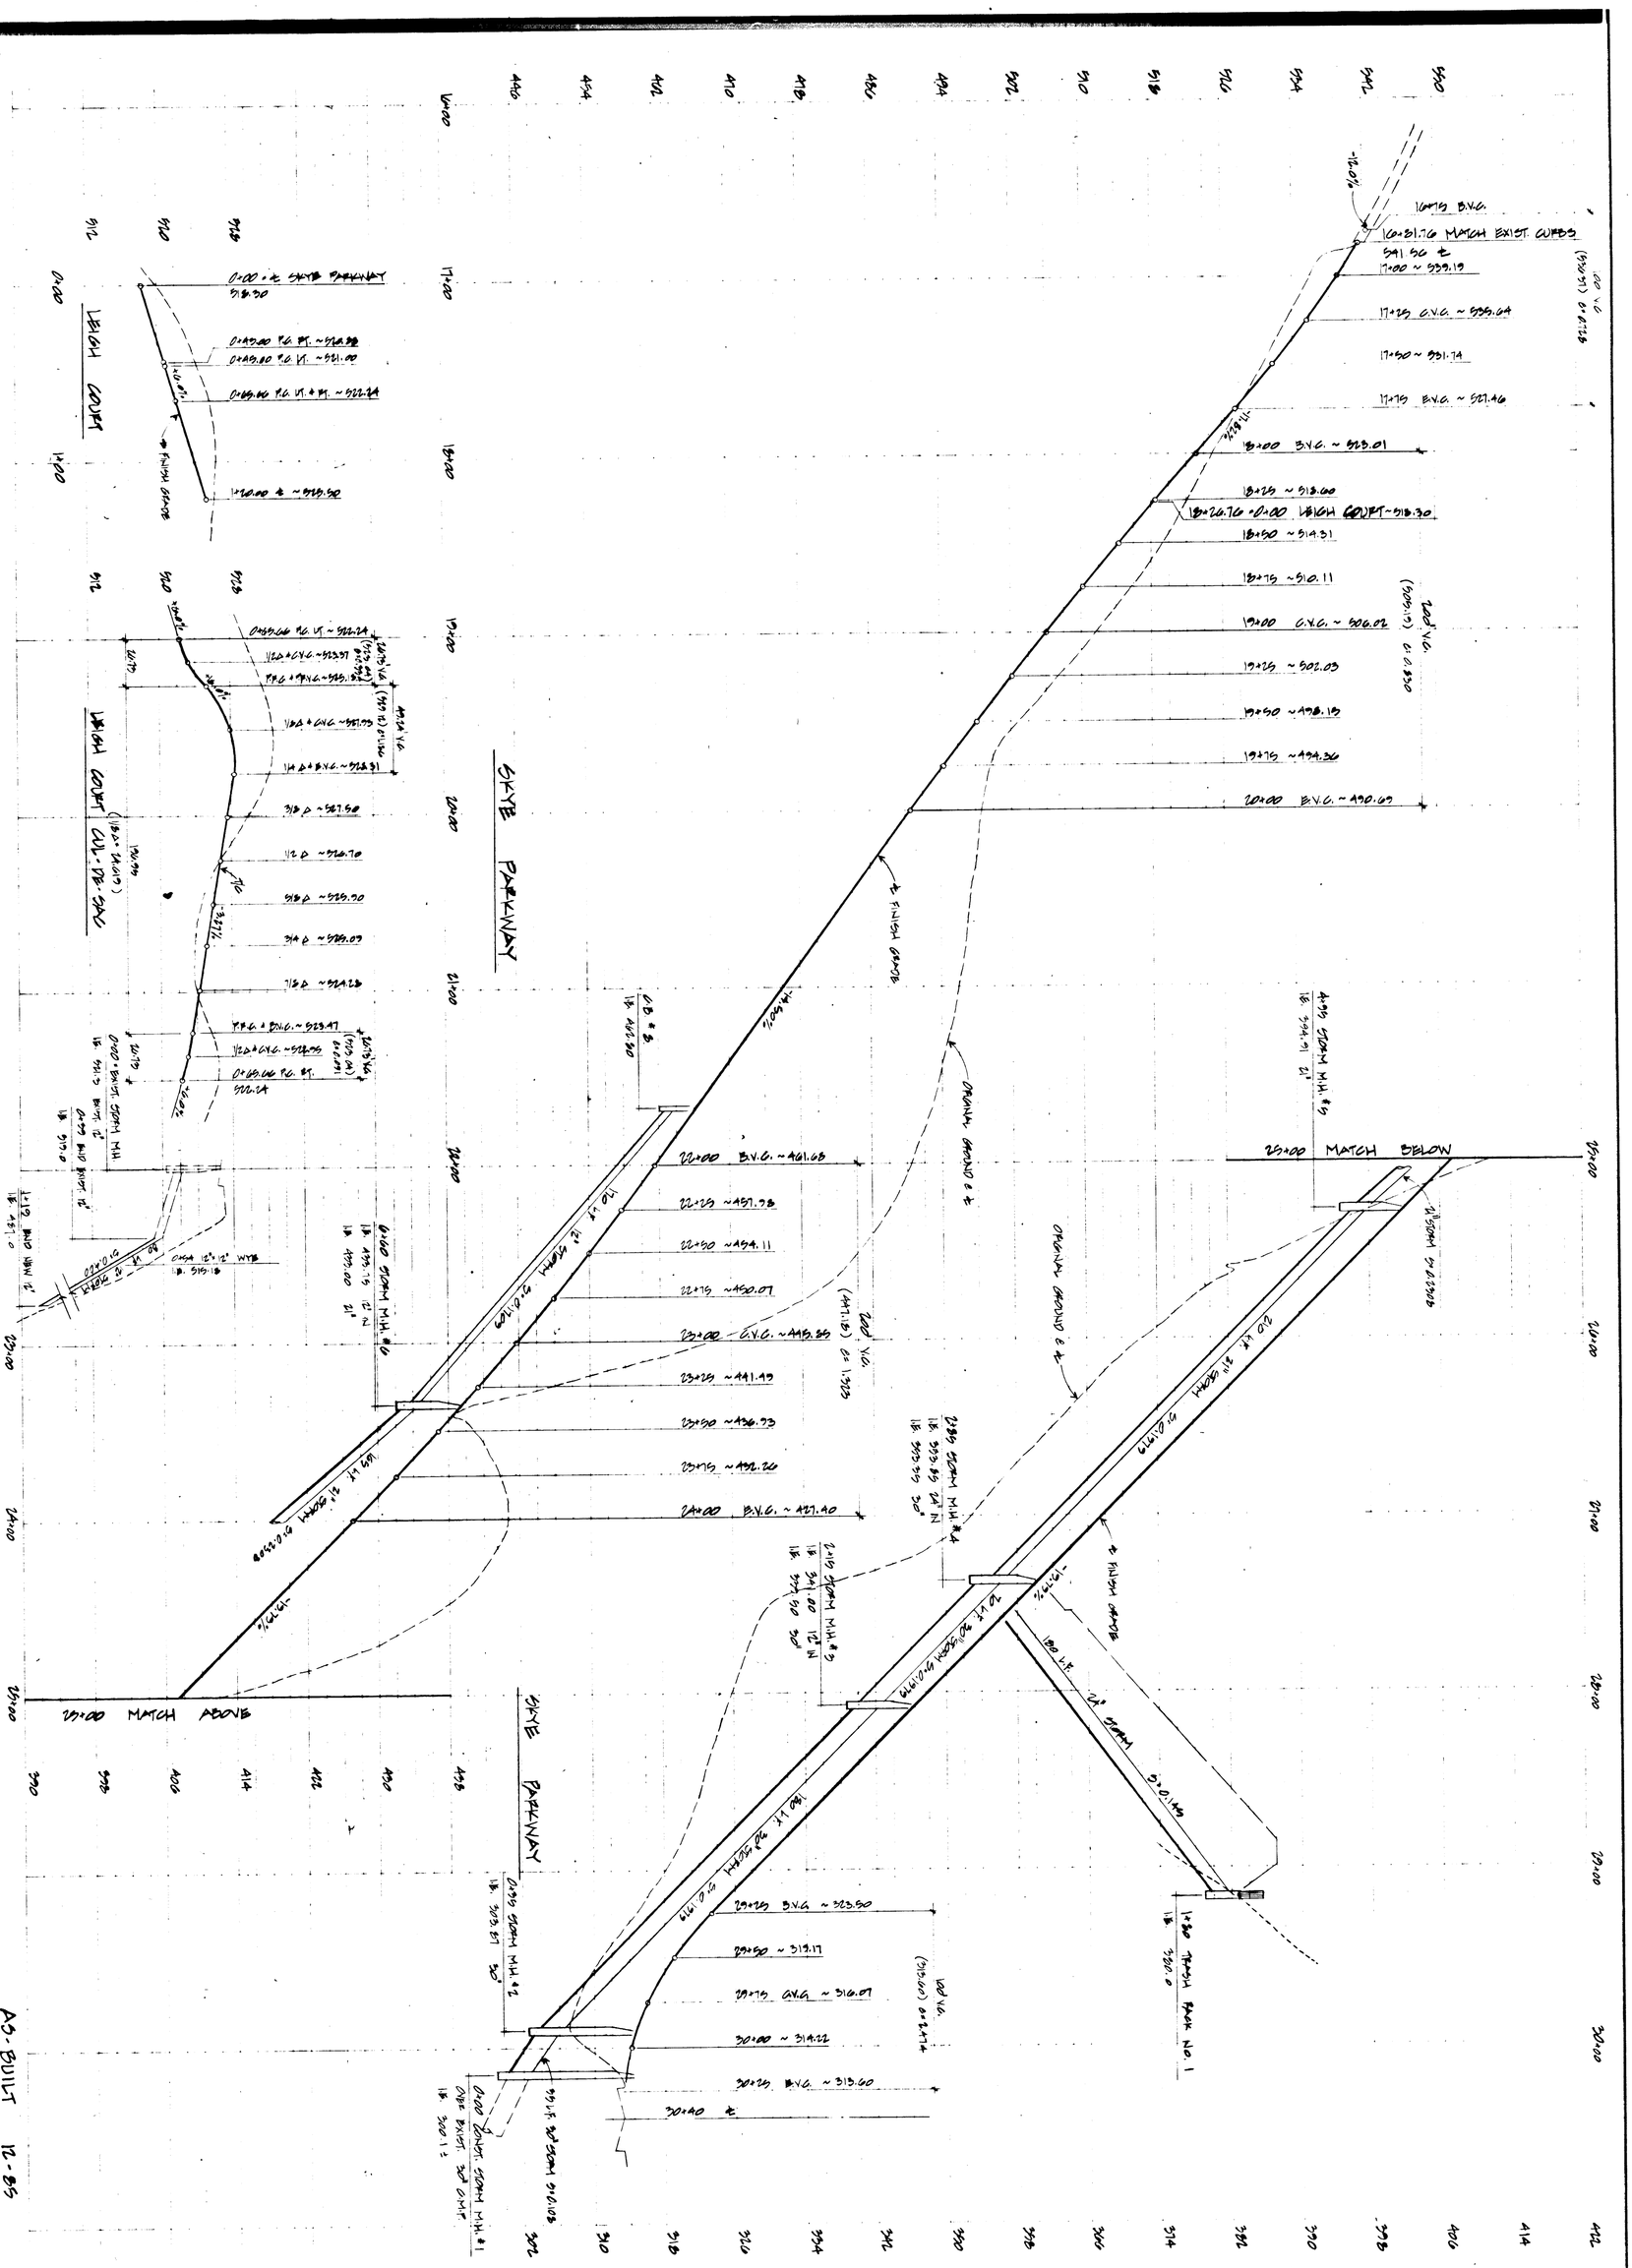

2 OF 5 SHEETS

SCALE 1"=40' HOR. 1"=5' VERT. DESIGN DB / DFB

DATE JAN. 1982 DRAWN DHG

FILE 6411.000 CHECKED DFB

REVISIONS

DEN

DAVID EVANS and ASSOCIATES, INC.

200 SW MARKET ST. PORTLAND, OR 97201 503/223-6663

SKYLINE RIDGE 2B

OREGON

STREET AND STORM SEWER PROFILES

WEST LINN,

CENTURION HOMES, INC.

4400 CORNWALL STREET

WEST LINN, OREGON 97068

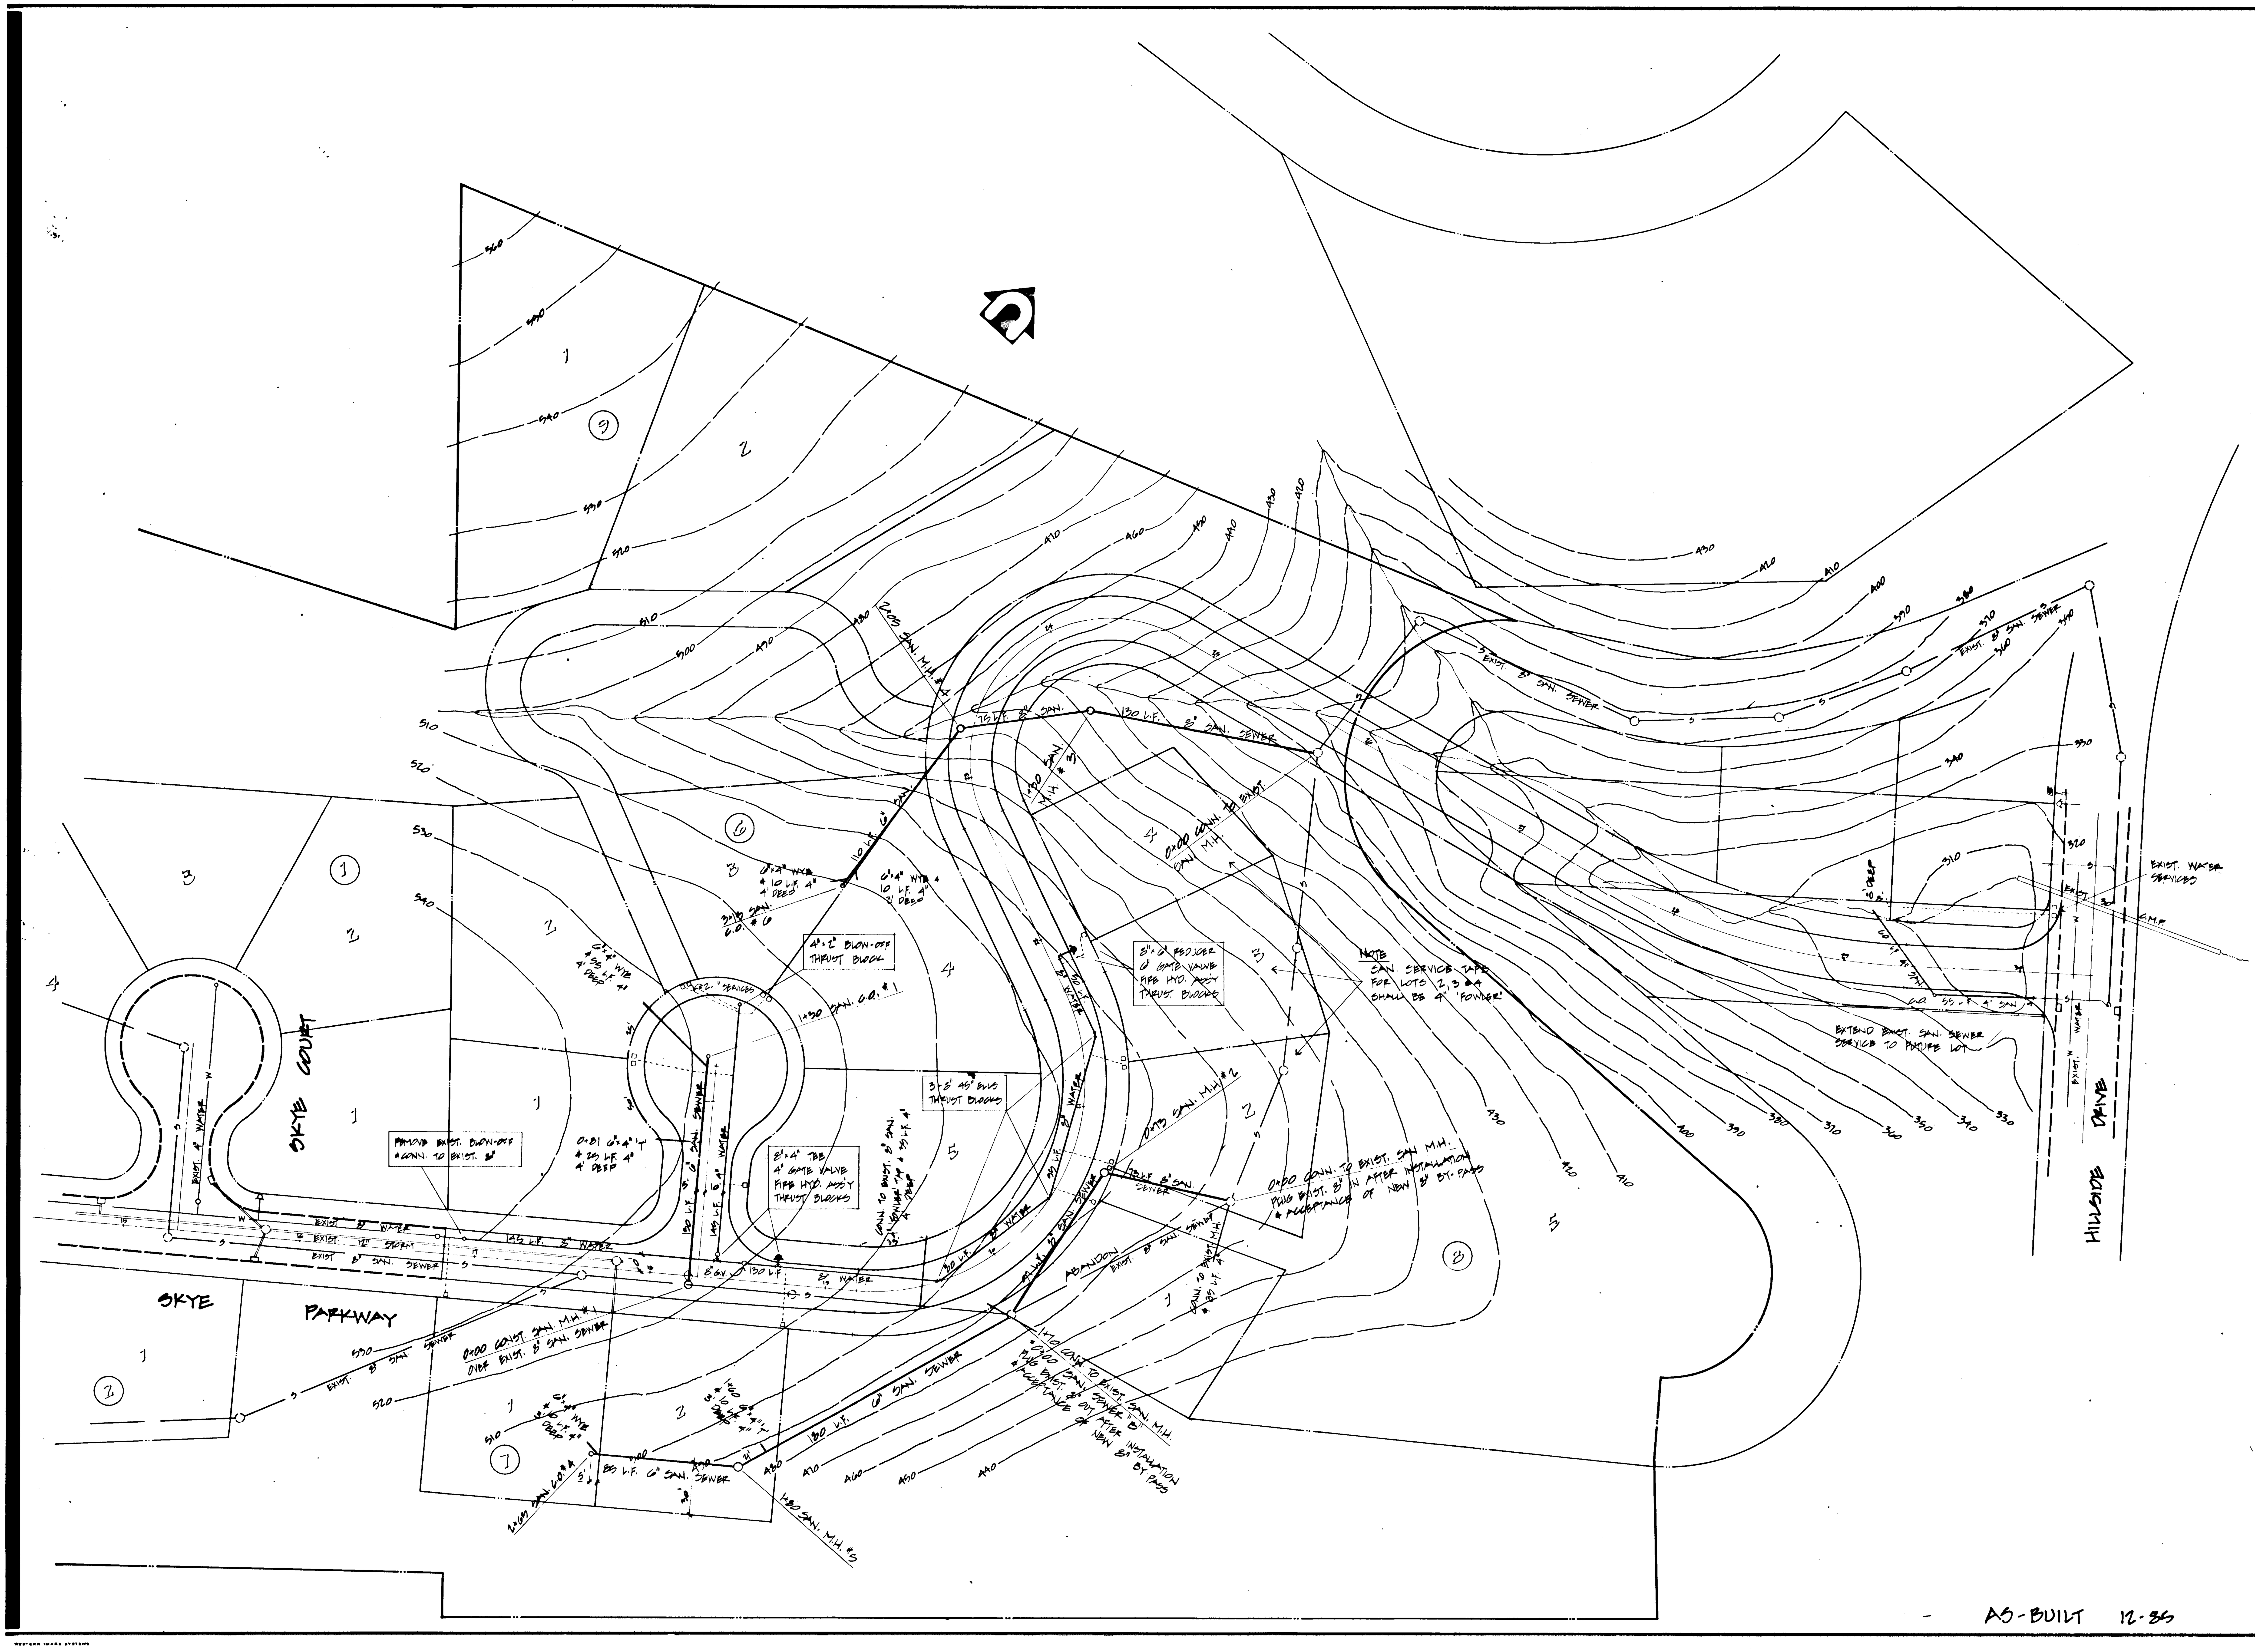

SKYLINE RIDGE 2B
WEST LINN, OREGON

SANITARY SEWER AND WATER PLAN

CENTURION HOMES, INC.
4430 CORNWALL STREET
WEST LINN, OREGON 97068

DEA
DAVID EVANS and ASSOCIATES, Inc.
2828 SW CORBETT AVE. · PORTLAND, OR 97201 · 503/223-6663

REVISIONS

3 OF 5 SHEETS

SCALE 1" = 40'
DATE JAN. 1989
FILE CH1 006
DESIGN DC/DFG
DRAWN DHG
CHECKED DFG

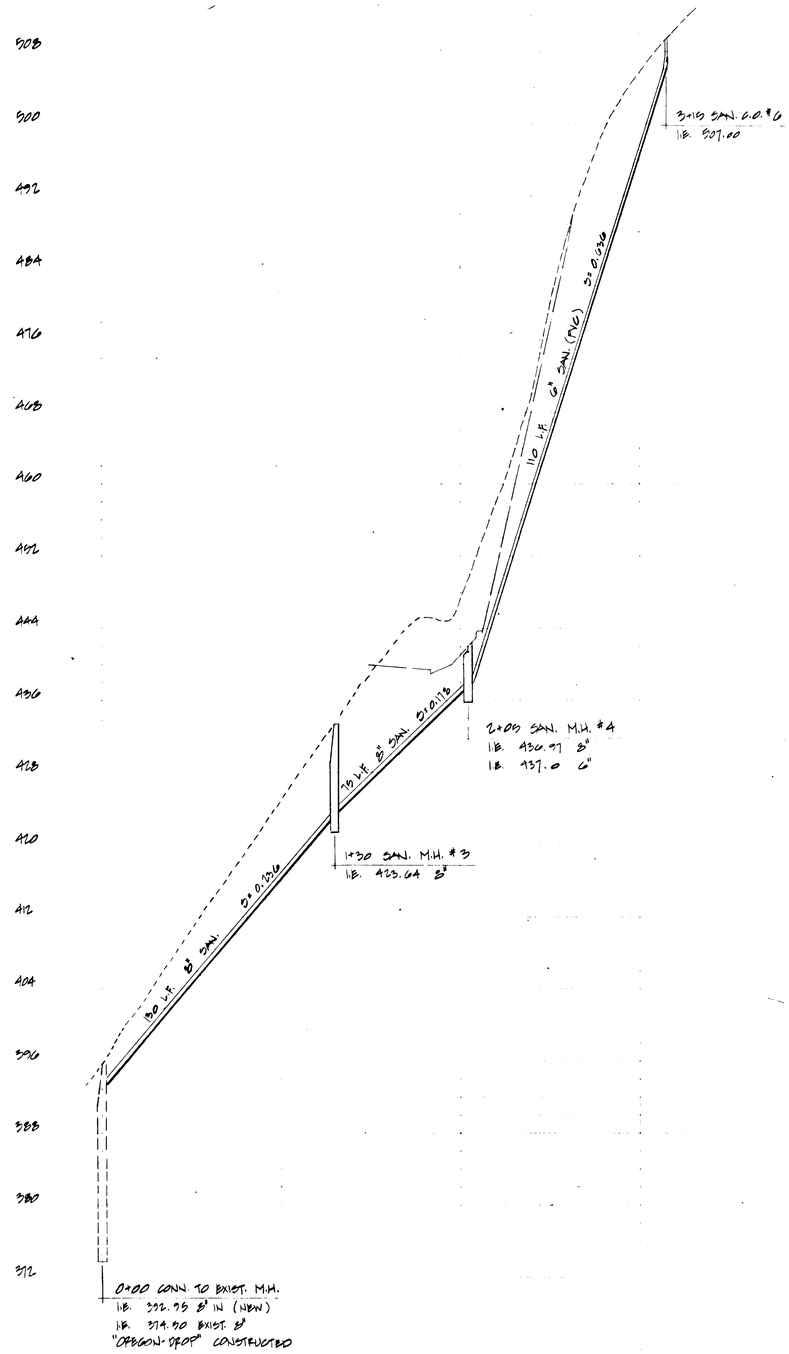

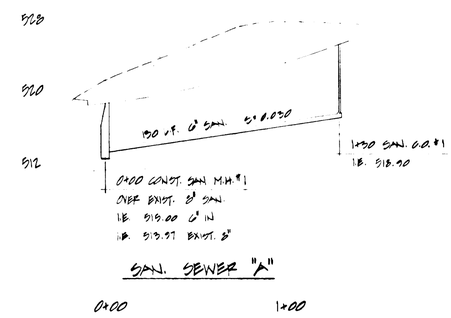

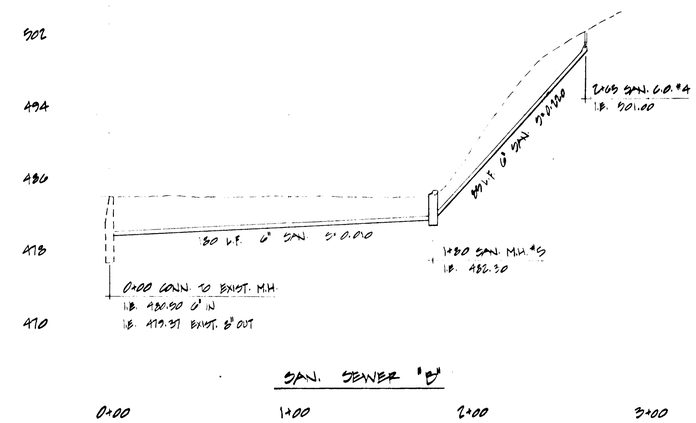

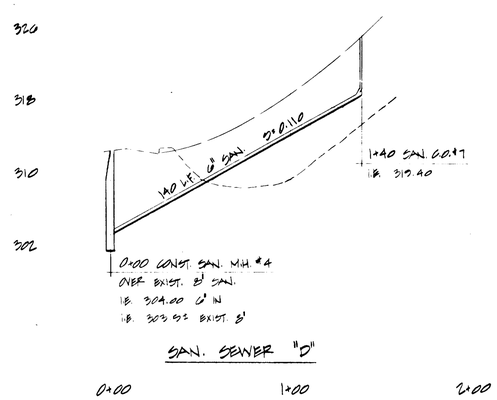

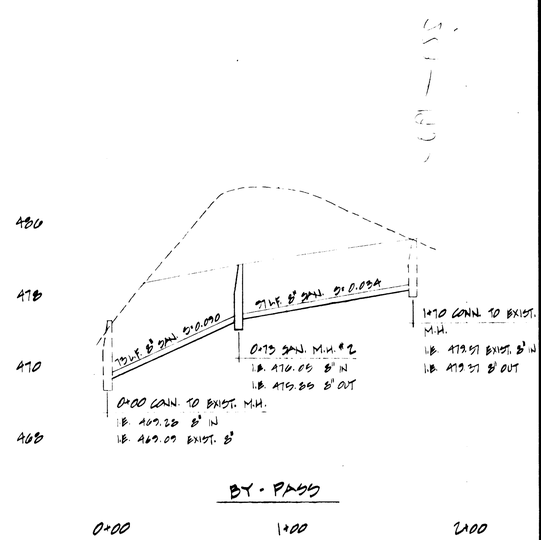

AS-BUILT 12-85

SKYLINE RIDGE 2B

SANITARY SEWER PROFILES

OREGON

WEST LINN,
CENTERLON HOMES INC.
4450 CORNWALL STREET
WEST LINN, OREGON 97068

DAVID EVANS and ASSOCIATES, INC.
2000 S.W. FIFTH AVE. PORTLAND, OR. 97201 503/223-6663

REVISIONS

4 OF 5 SHEETS

SCALE 1"=40' HOR. 1"=5' VERT. DESIGN JAC 1/86
DATE JAN. 1986 DRAWN JAC
REF. CAD 2010 CHECKED JCB