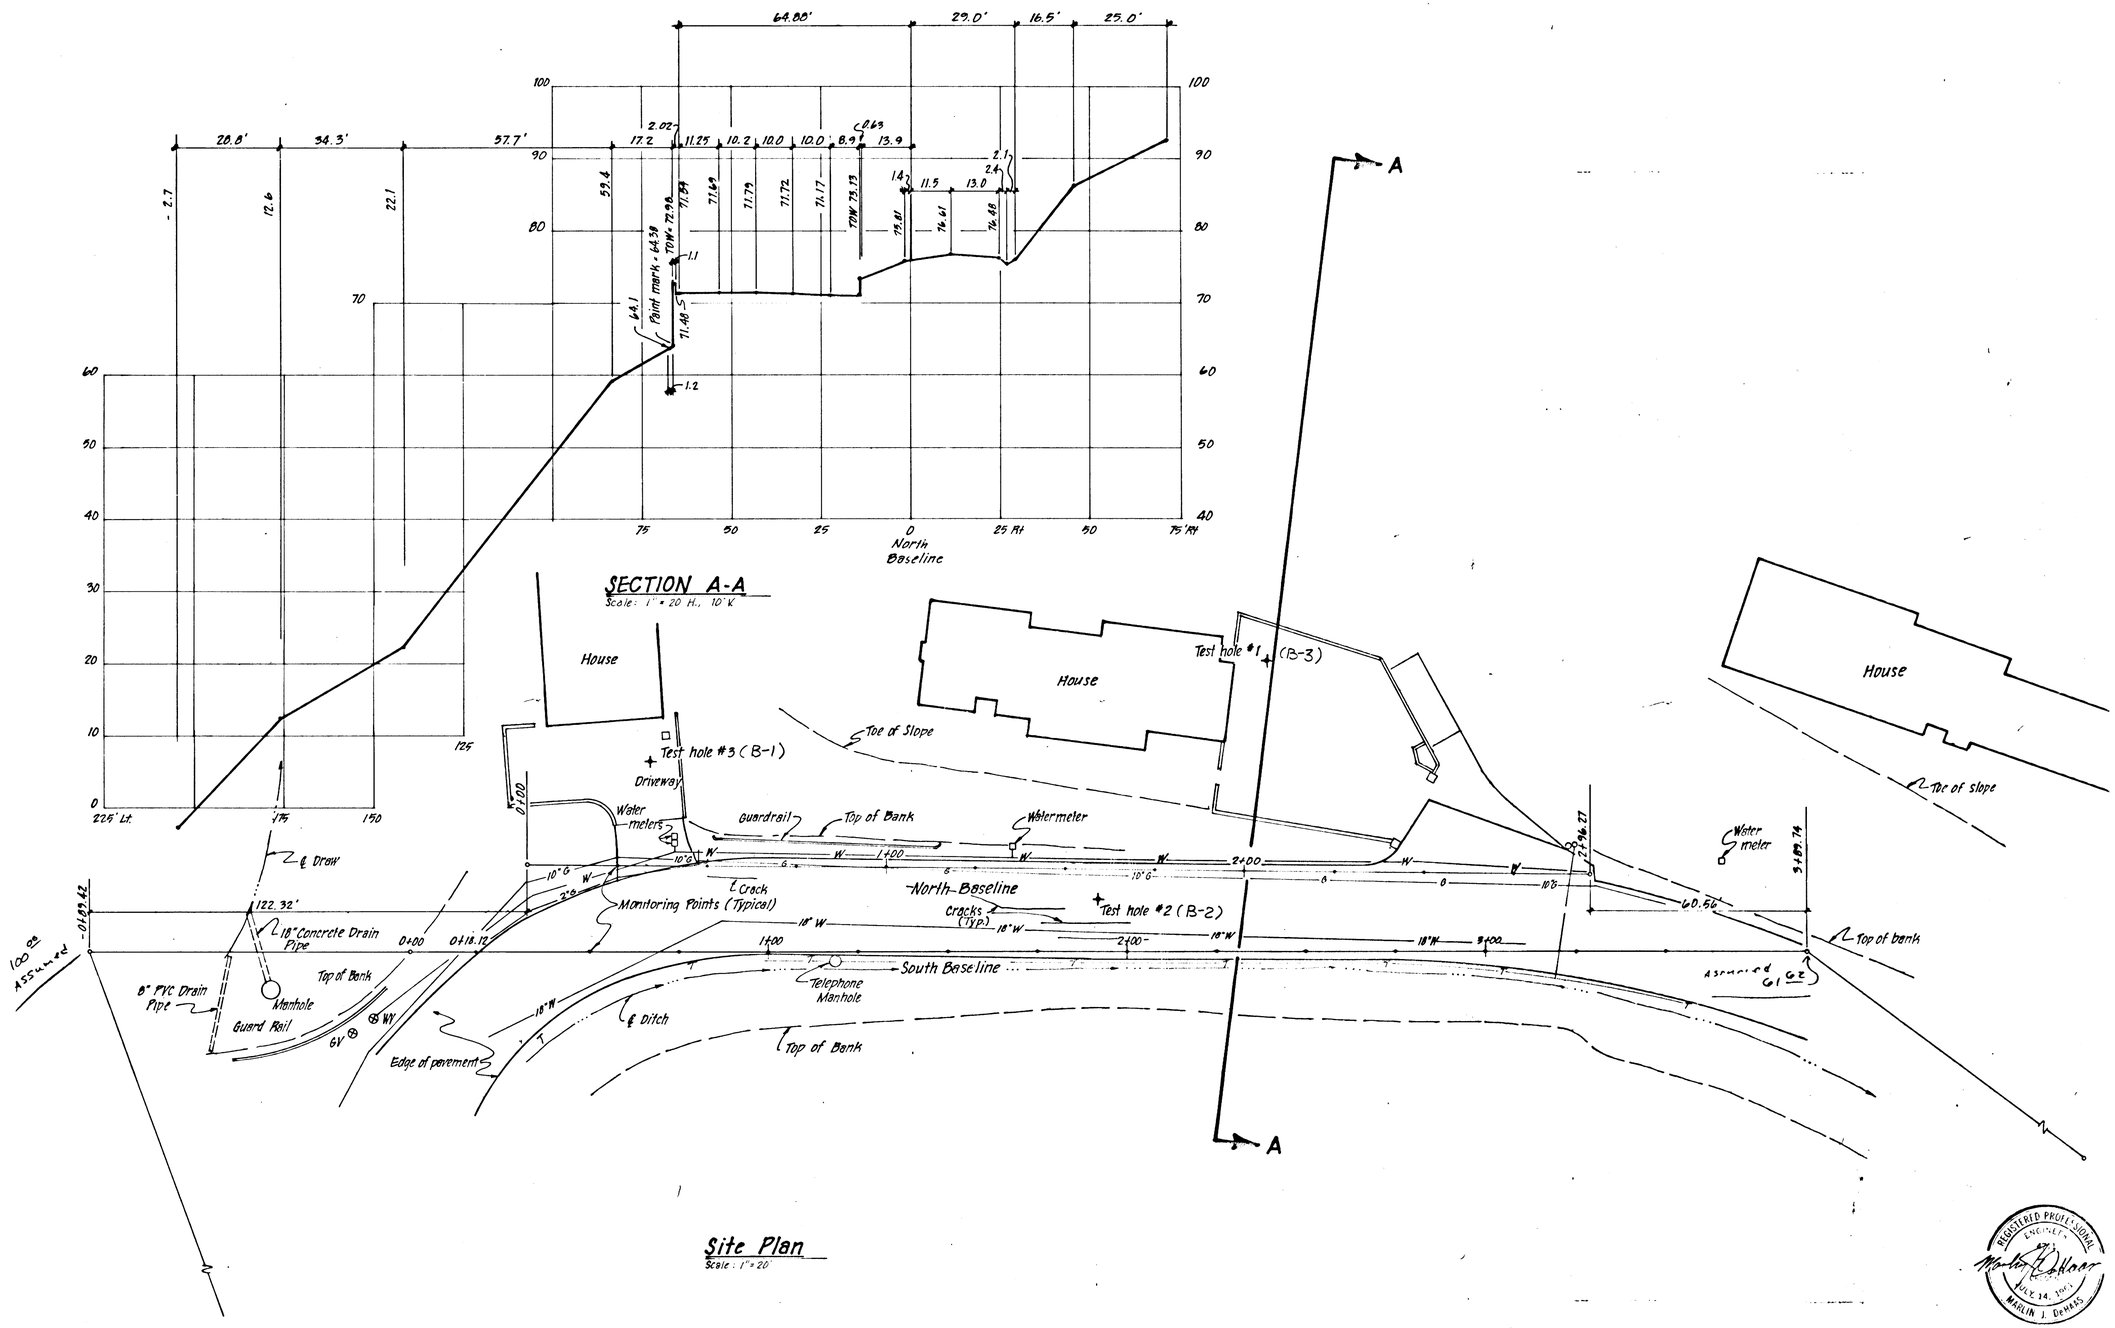

DATE	NO.	REVISIONS	BY

KW DESIGNED
DMF DRAWN
MJD CHECKED
APPROVED
DATE

DE HAAS & Associates, Inc.
Consulting Engineers & Surveyors

Suite 300 - AGC Center
9450 S.W. Commerce Circle
Wilsonville, Oregon 97070
(503) 682-2450
Res. 636-6195

City of West Linn
Skyline Road Slide Control Monitoring

Site Plan
Cross-Section

SHEET 1/2

SCALE As Shown | DATE March 12, 1991 | FILE 90.085.250

REGISTERED PROFESSIONAL ENGINEER
JULY 14, 1991
MARLIN J. DeHAAS