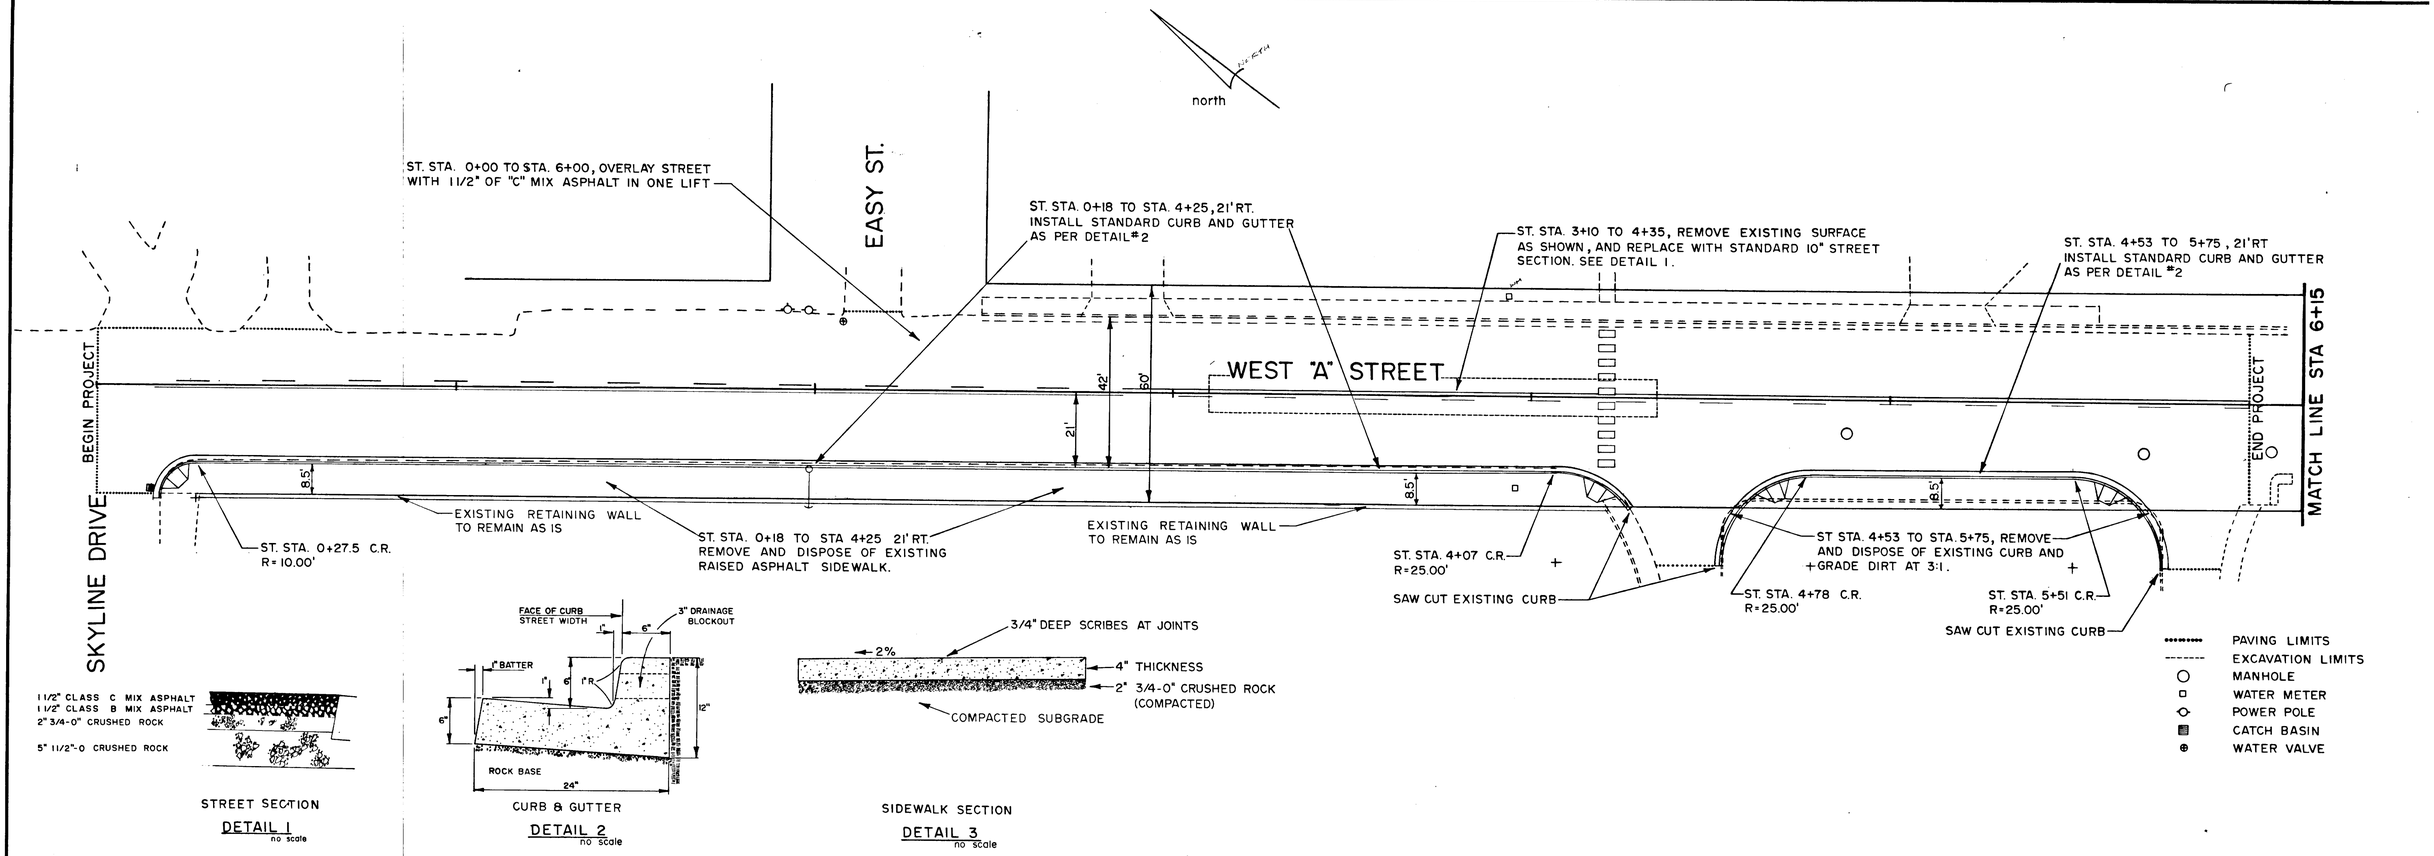

REGISTERED PROFESSIONAL ENGINEER 11311 OREGON JUL 17, 1981 EARL RUSSELL REED

Earl Russell Reed

DATE	NO.	REVISION

DRAWN & DESIGN JWM
FILE
DATE OCT, 1987
SCALE HOR 1"=20' VERT 1"=5'

CITY OF WEST LINN

PUBLIC WORKS DEPARTMENT

WEST "A"
STREET IMPROVEMENTS

SKYLINE TO McKILLICAN

1/1