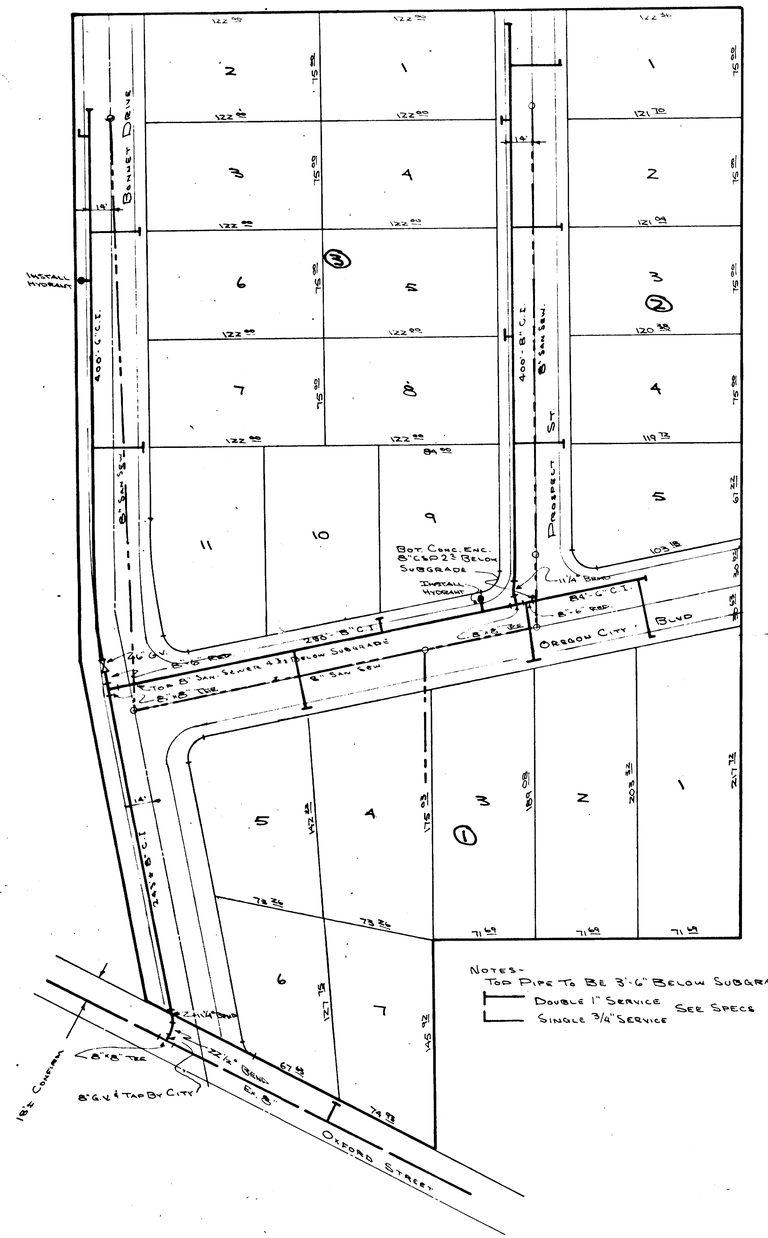

Notes-
Top Pipe To Be 3'-6" Below Subgrade

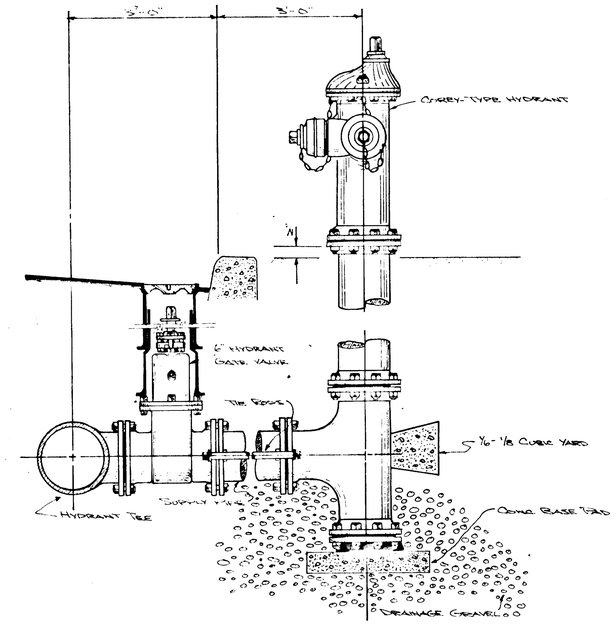

Typical Hydrant Installation
No Scale

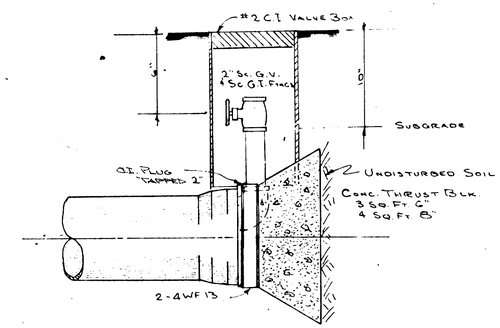

Typical Pipe End Construction
No Scale

WATER SYSTEM PLAN West Linn Heights No 2	
CLYDE E CARLSON CONSULTING CIVIL ENGINEER 14449 SE STARK ST PORTLAND OREGON 97233	SHT 1 OF 2 DATE July, 1972 REV

C-16