PLAN OF
SHA-WA-ANA
SECTION 24 T2S R1E, W.M.
CLACKAMAS COUNTY, ORE.

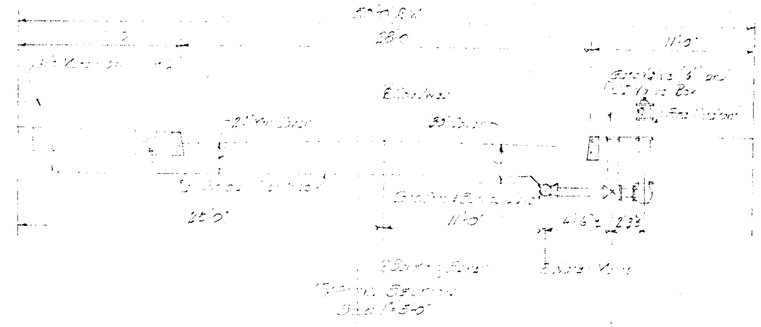

Legend:
New Water Mains
New Services
Gate Valves
Fire Hydrants
Existing Water Mains
Existing Services
Proposed Lines
Sewer Lines
Note: For more details see Drawing of Pleasant Ridge Est.

HOUSE SERVICES
Sha-Wa-Ana

REVISION	DATE	DESCRIPTION	BY

PORTLAND WATER DIST. CLACKAMAS COUNTY, OREGON

JOB No. 8K-1
DESIGNED BY: W.J.D.
TRACED BY:
CHECKED BY: W.J.D.
DATE: 2-27-61
APPROVED BY: W. J. Dorner

PROPOSED IMPROVEMENTS
DOMESTIC WATER MAINS & SERVICES
PLAN OF SHA-WA-ANA

SCALE: 1" = 50' SHEET 1 OF 1

W. J. DORNER
CONSULTING ENGINEER
PORTLAND OREGON

DRAWING NUMBER 328

SPARE