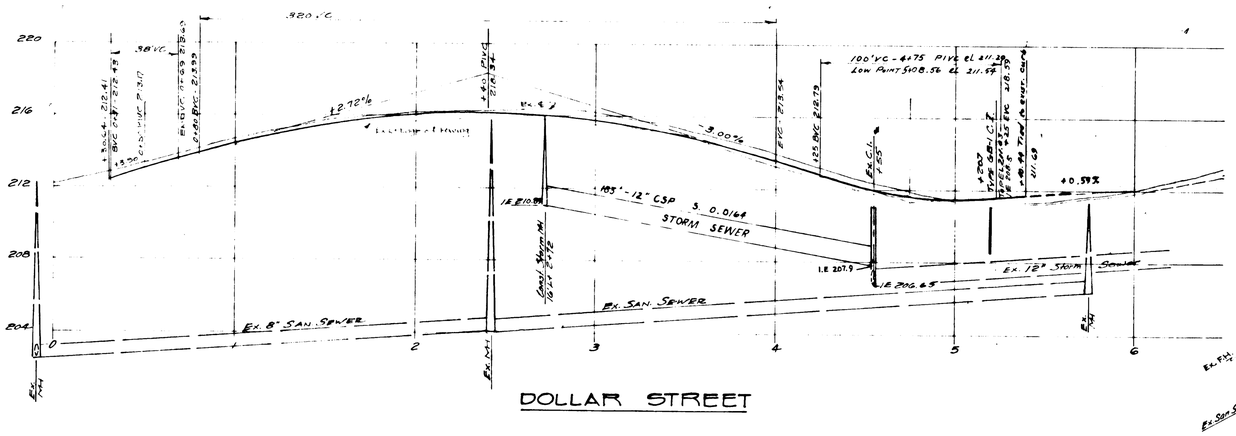

NOTE: Profiles of existing pavement as of 8-23-77.

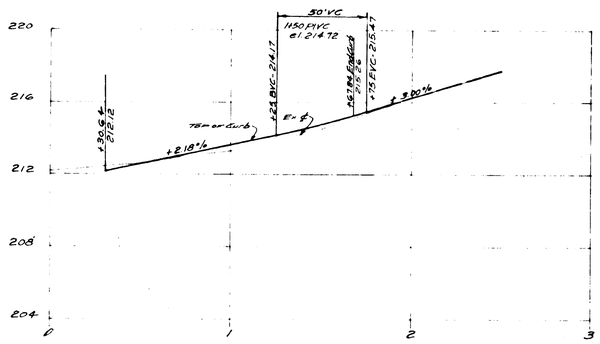

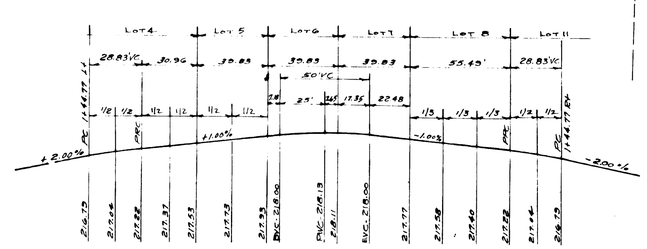

PROFILE SCALE
1" = 4' V
1" = 40' H

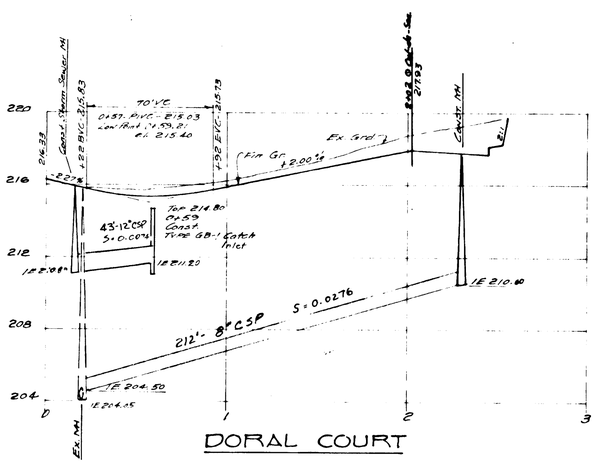

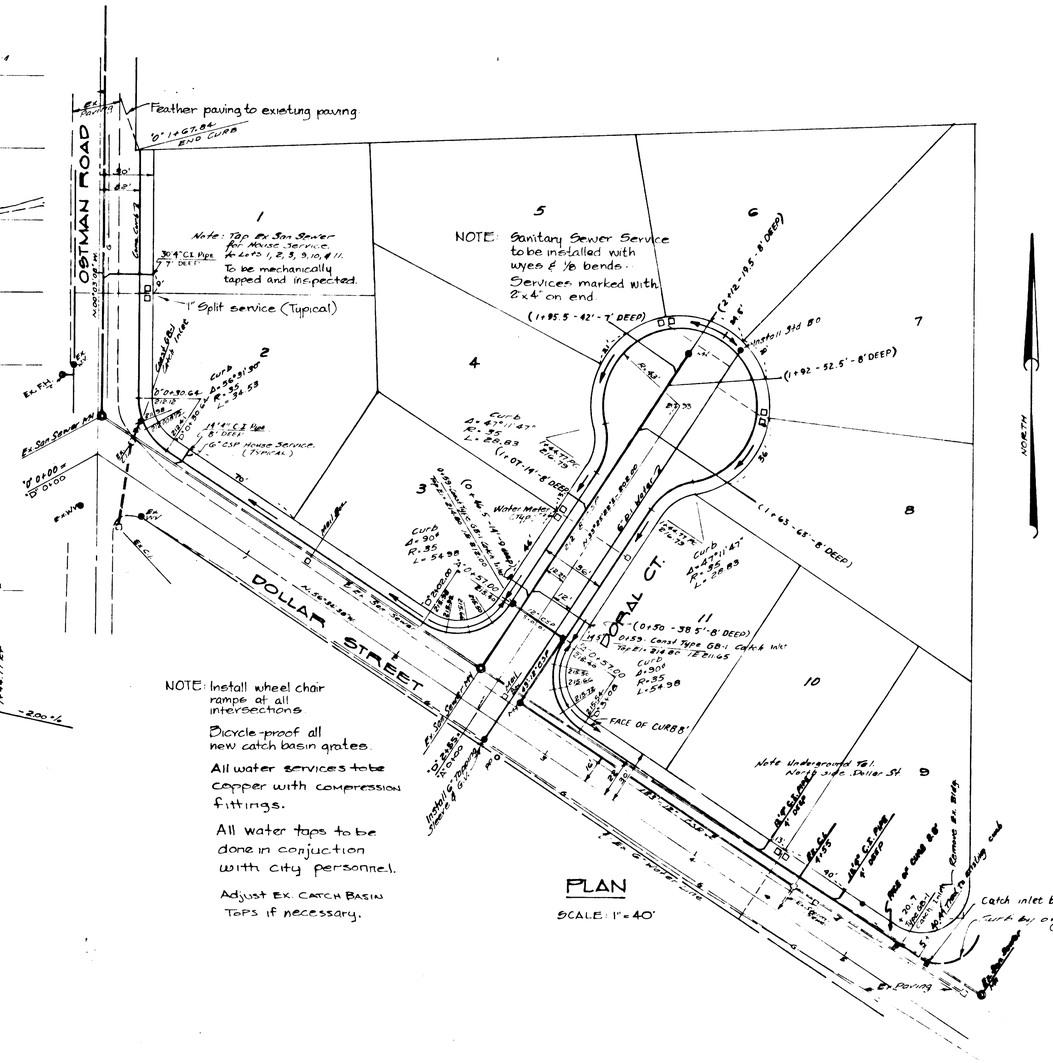

PLAN
SCALE: 1" = 40'

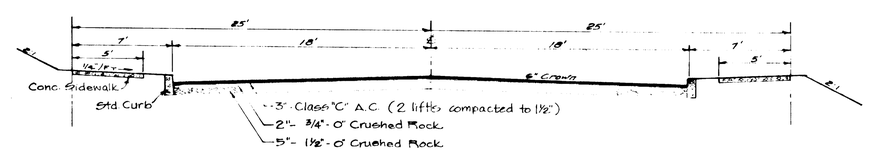

TYPICAL SECTION
DORAL COURT

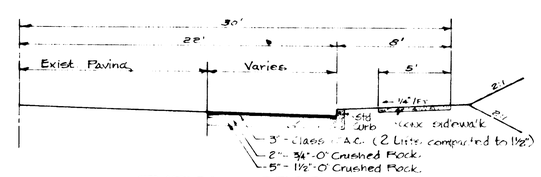

TYPICAL SECTION
DOLLAR STREET
OSTMAN ROAD

NOTE: Exist. Street Condition may make it necessary to pave to exist. crown. (Added 2/6/78)

NOTE: Street, storm sewer, sanitary sewer and water service to be constructed in accordance with the Standard Specifications of the City of West Linn.

REVISIONS
Notes Added: 9-12-77
AS-BUILT ADDED: 6-21-78

MARTIN ENGINEERING CO.
4621 S.W. KELLY AVE.
PORTLAND, OREGON 97201

FOR:
DORAL DEVELOPMENT CO.
15695 S.E. CORDOVA COURT
MILWAUKIE, OREGON 97222

DATE: AUGUST 26, 1977 B-68

(AS-BUILT) 6-16-78

STREET, SANITARY SEWER, STORM SEWER AND WATER PLANS & PROFILES
WILL LINN SUBDIVISION
CITY OF WEST LINN, OREGON