LEGEND — TORO PRODUCTS

Symbol	QTY	Part No.	Description
	9	625-00-24	ADJUSTABLE PART CIRCLE SPRINKLER 5GPM
	49	625-00-25	ADJUSTABLE PART CIRCLE SPRINKLER 5.0GPM
	10	625-00-26	ADJUSTABLE PART CIRCLE SPRINKLER 7-9.0GPM
	5	624-00-26	FULL CIRCLE SPRINKLER 9.0GPM
	13	570-HP-15	12" Pop-up SHRUB HEADS 15' radius
	29	570-HP-12	12" Pop-up SHRUB HEADS 12' radius
	23	570-P-12	3" Pop-up Lawn HEADS 12' radius
	1	126-01-11	CUSTOM II Normally OPEN CONTROLLER
	1	- -	FEBCO 1½" Pressure Vacuum BREAKER
	1	- -	WATTS 1½" PRESSURE REDUCER
	1	- -	2" gate valve for main shutoff
	1	- -	QUICK CONNECT FOR AIR COMPRESSOR
	8	232-01-06	1½" NORMALLY OPEN HYDRAULIC VALVE
	3	232-01-04	1" NORMALLY OPEN HYDRAULIC VALVE

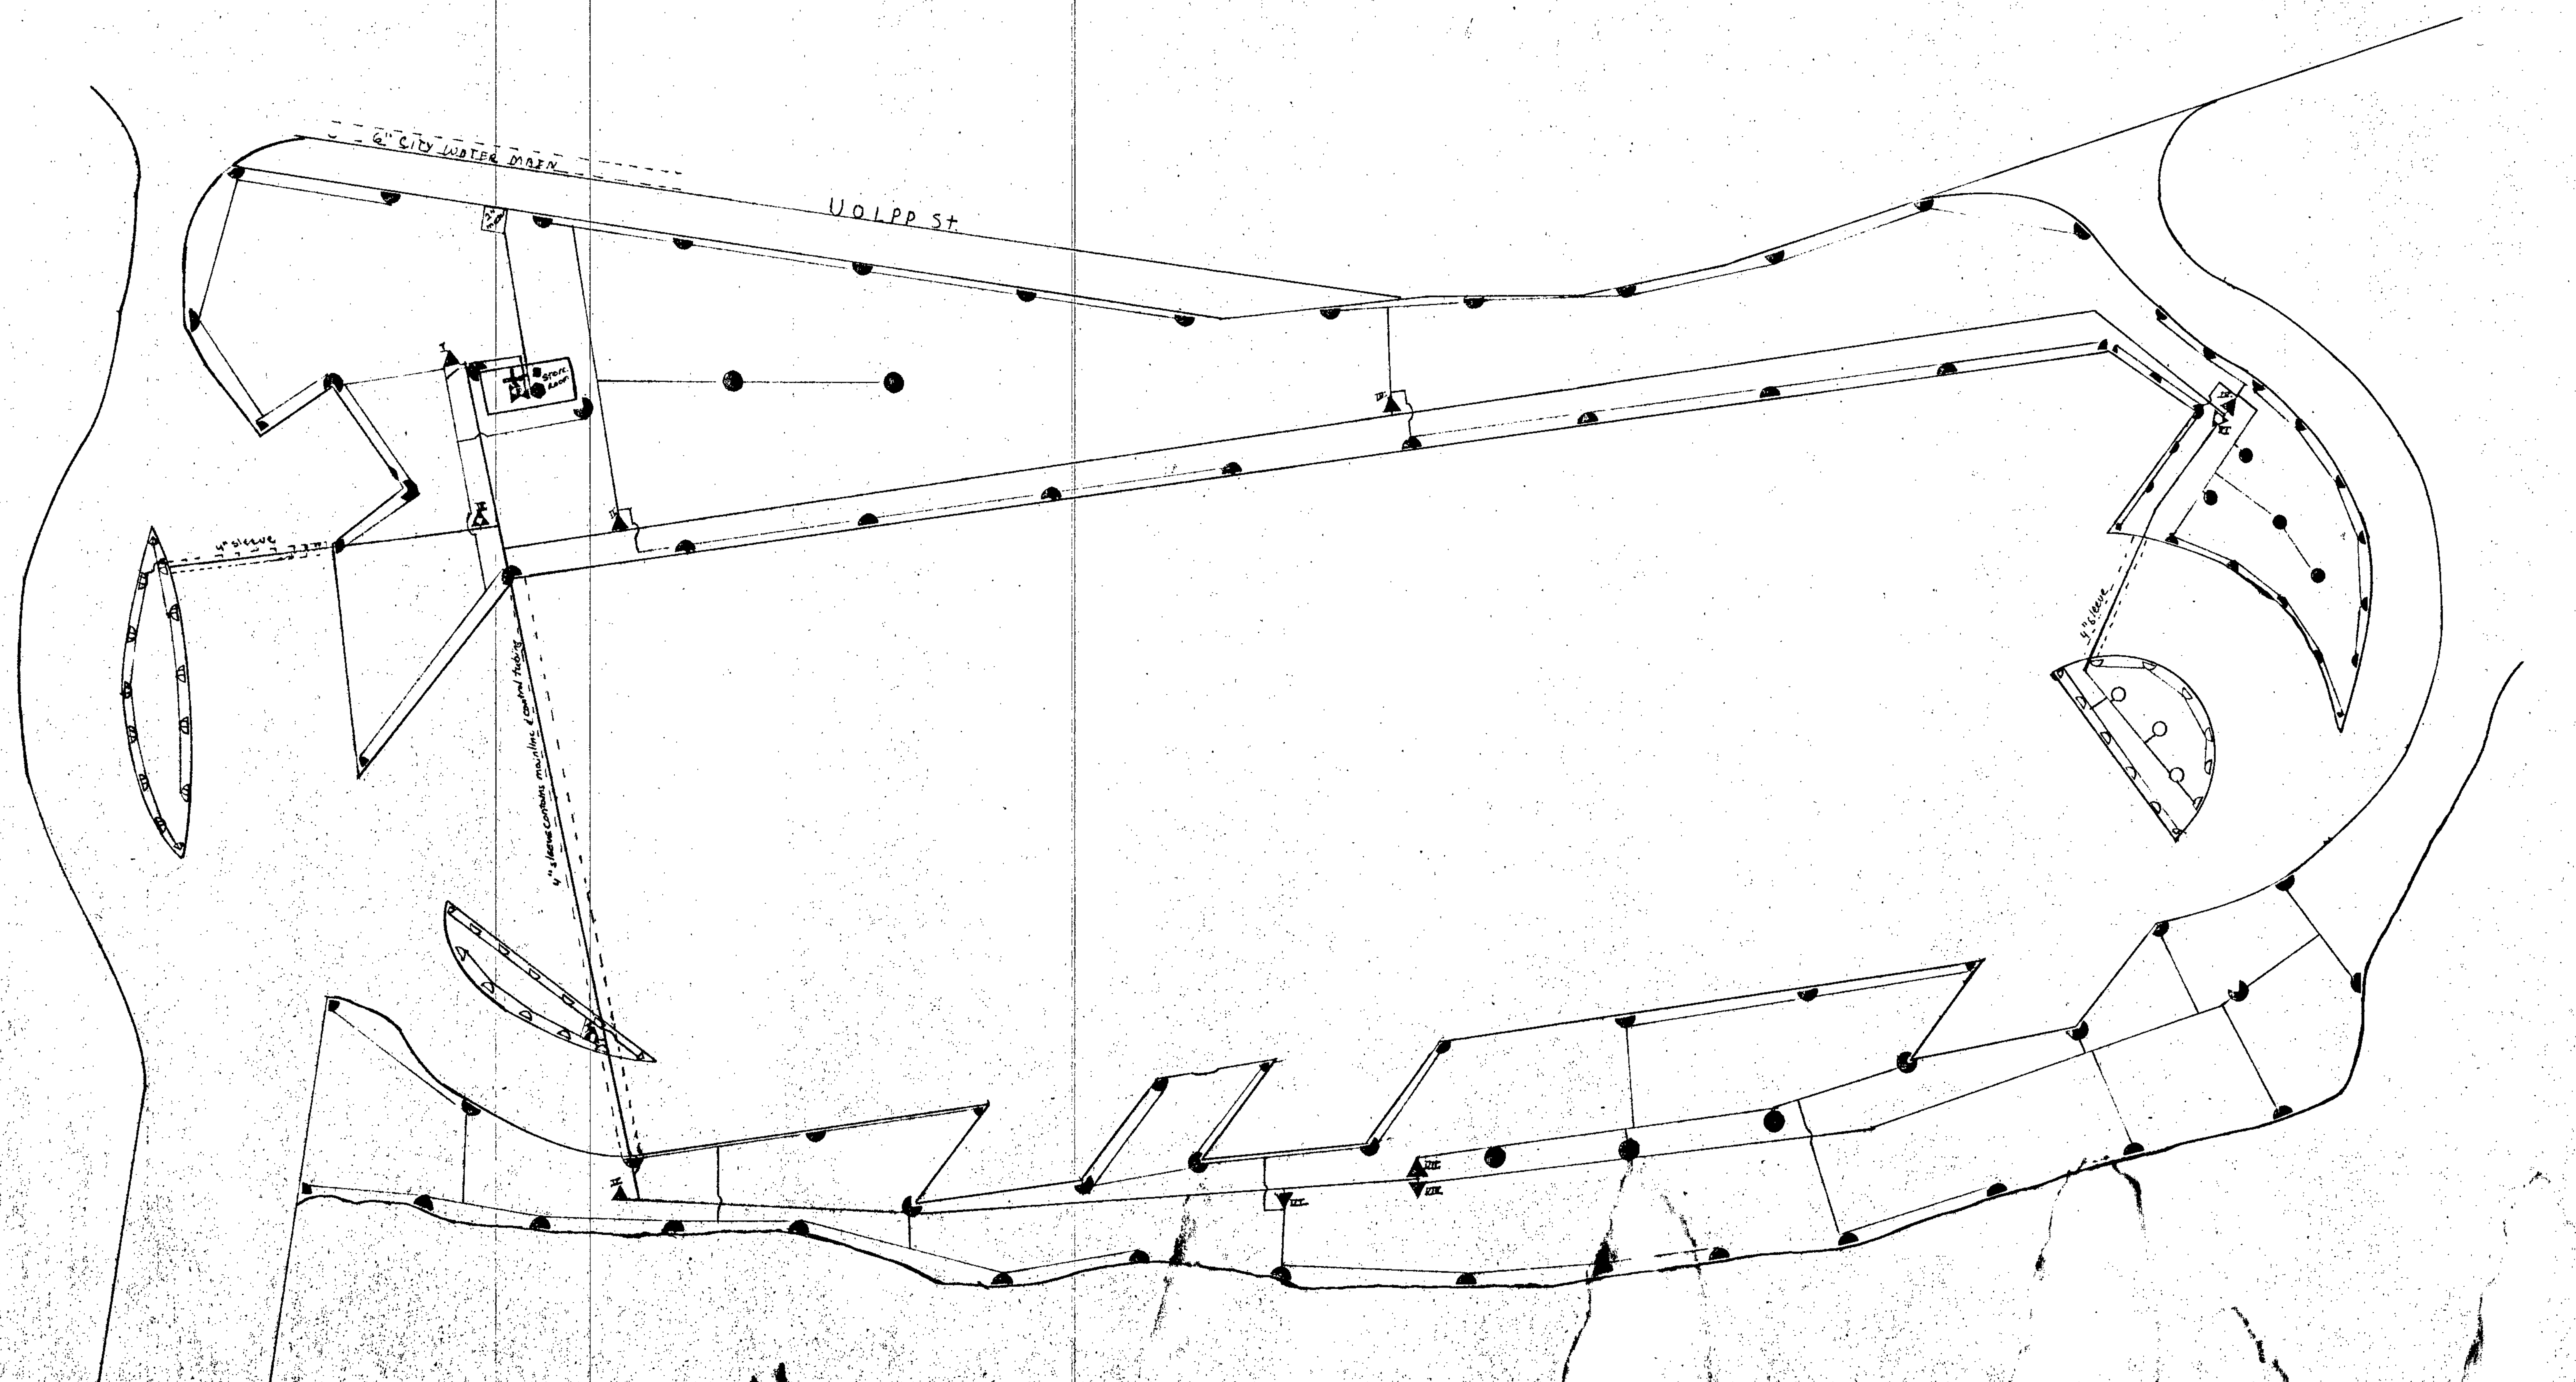

DATE	NO.	REVISION

DRAWN AS INSTALLED
FILE   DATE 12/26/81
SCALE

CITY OF WEST LINN
PUBLIC WORKS DEPARTMENT

WILLAMETTE BOAT RAMP
WILLAMETTE PARK

STATIC PRESSURE 130 PSI
OPERATING PRESSURE 80 PSI
HEAD PRESSURE 65 PSI
Irrigation Completed 10/30/81
Design By: Ken Worcester

ALL TURF STATIONS SHOULD OPERATE APPROXIMATELY 4 HOURS A WEEK TO PROVIDE 1½ INCHES OF WATER EXCEPT FOR STATION NO. 4 WHICH SHOULD RUN FOR 1½ HOUR

SHRUB STATIONS PUT OUT APPROXIMATELY 1" PER HOUR

LEGEND			TORO PRODUCTS
Symbol	QTY	PART NO.	DESCRIPTION
	9	625-00-24	ADJUSTABLE PART CIRCLE SPRINKLER 5.6PM
	49	625-00-25	ADJUSTABLE PART CIRCLE SPRINKLER 5.0GPM
	10	625-00-26	ADJUSTABLE PART CIRCLE SPRINKLER 7.9GPM
	5	624-00-26	FULL CIRCLE SPRINKLER 9.0GPM
	13	570-HP-15	12" POP-UP SHRUB HEADS 15' radius
	29	570-HP-12	12" POP-UP SHRUB HEADS 12' radius
	23	570-P-12	2" POP-UP LAWN HEADS 12' radius
	1	126-01-11	CUSTOM 11 Normally OPEN CONTROLLER
	1	- -	FERCO 1½" PRESSURE VACUUM BREAKER
	1	- -	WATTS 1½" PRESSURE REDUCER
	1	- -	2" gate valve for main shutoff
	1	- -	QUICK CONNECT FOR AIR COMPRESSOR
	8	232-01-06	1½" NORMALLY OPEN HYDRAULIC VALVE
	3	232-01-04	1" NORMALLY OPEN HYDRAULIC VALVE

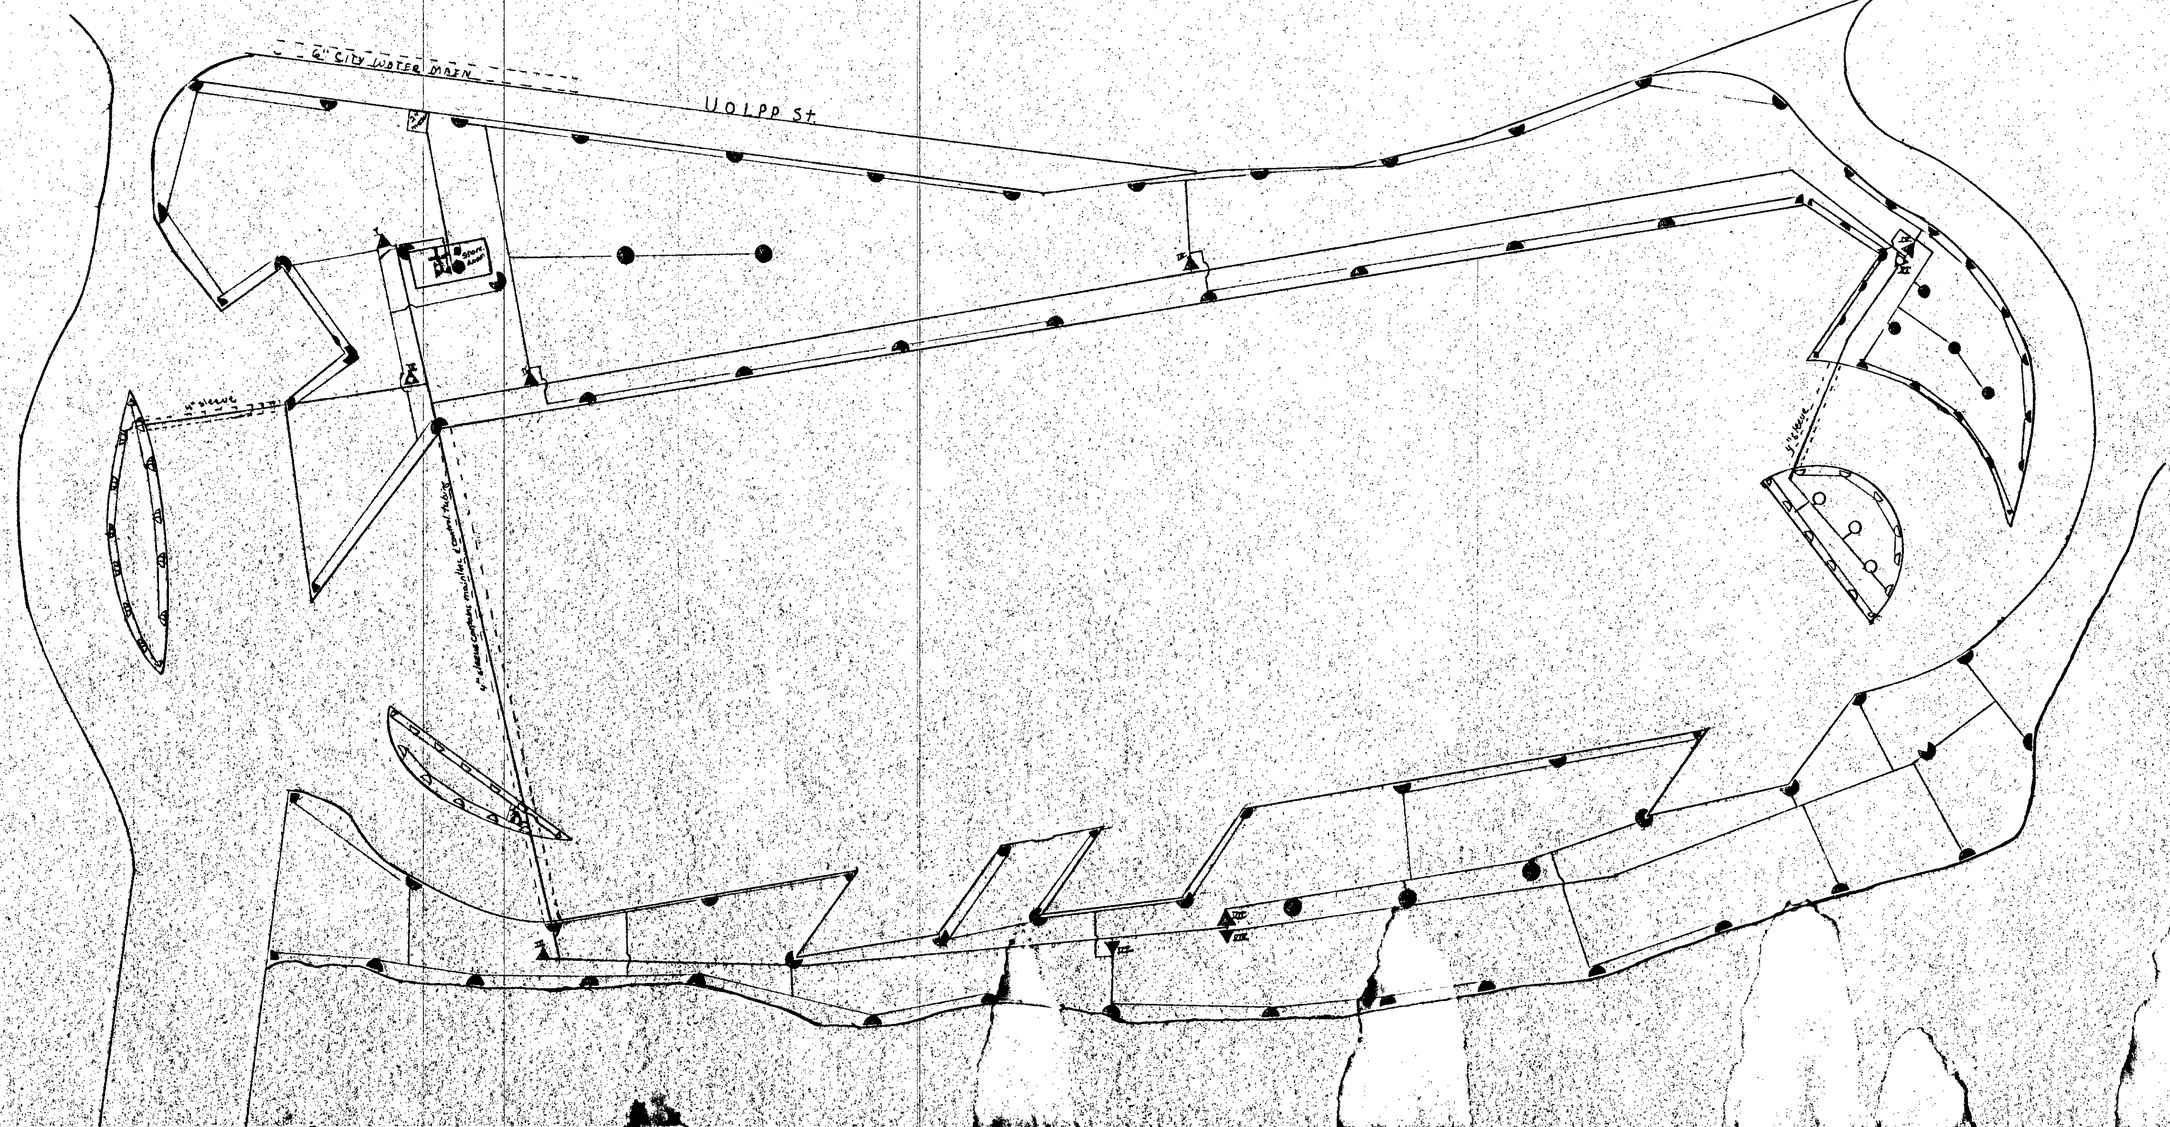

BOAT RAMP

DATE	REVISION	DRAWN AS INSTALLED	
		FILE	DATE
		SCALE	

CITY OF WEST LINN

PUBLIC WORKS DEPARTMENT

WILLAMETTE BOAT RAMP

WILLAMETTE PARK

STATIC PRESSURE 130 PSI
OPERATING PRESSURE 90 PSI
HEAD PRESSURE 65 PSI
IRRIGATION COMPLETED 10/30/81
DESIGN BY KEN WORCESTER

ALL TURF STATIONS SHOULD OPERATE APPROXIMATELY 4 HOURS A WEEK TO PROVIDE 1½ INCHES OF WATER EXCEPT FOR STATION NO 4 WHICH SHOULD RUN FOR 1½ HOURS

SHRUB STATION PUT OUT APPROXIMATELY 1" PER HOUR