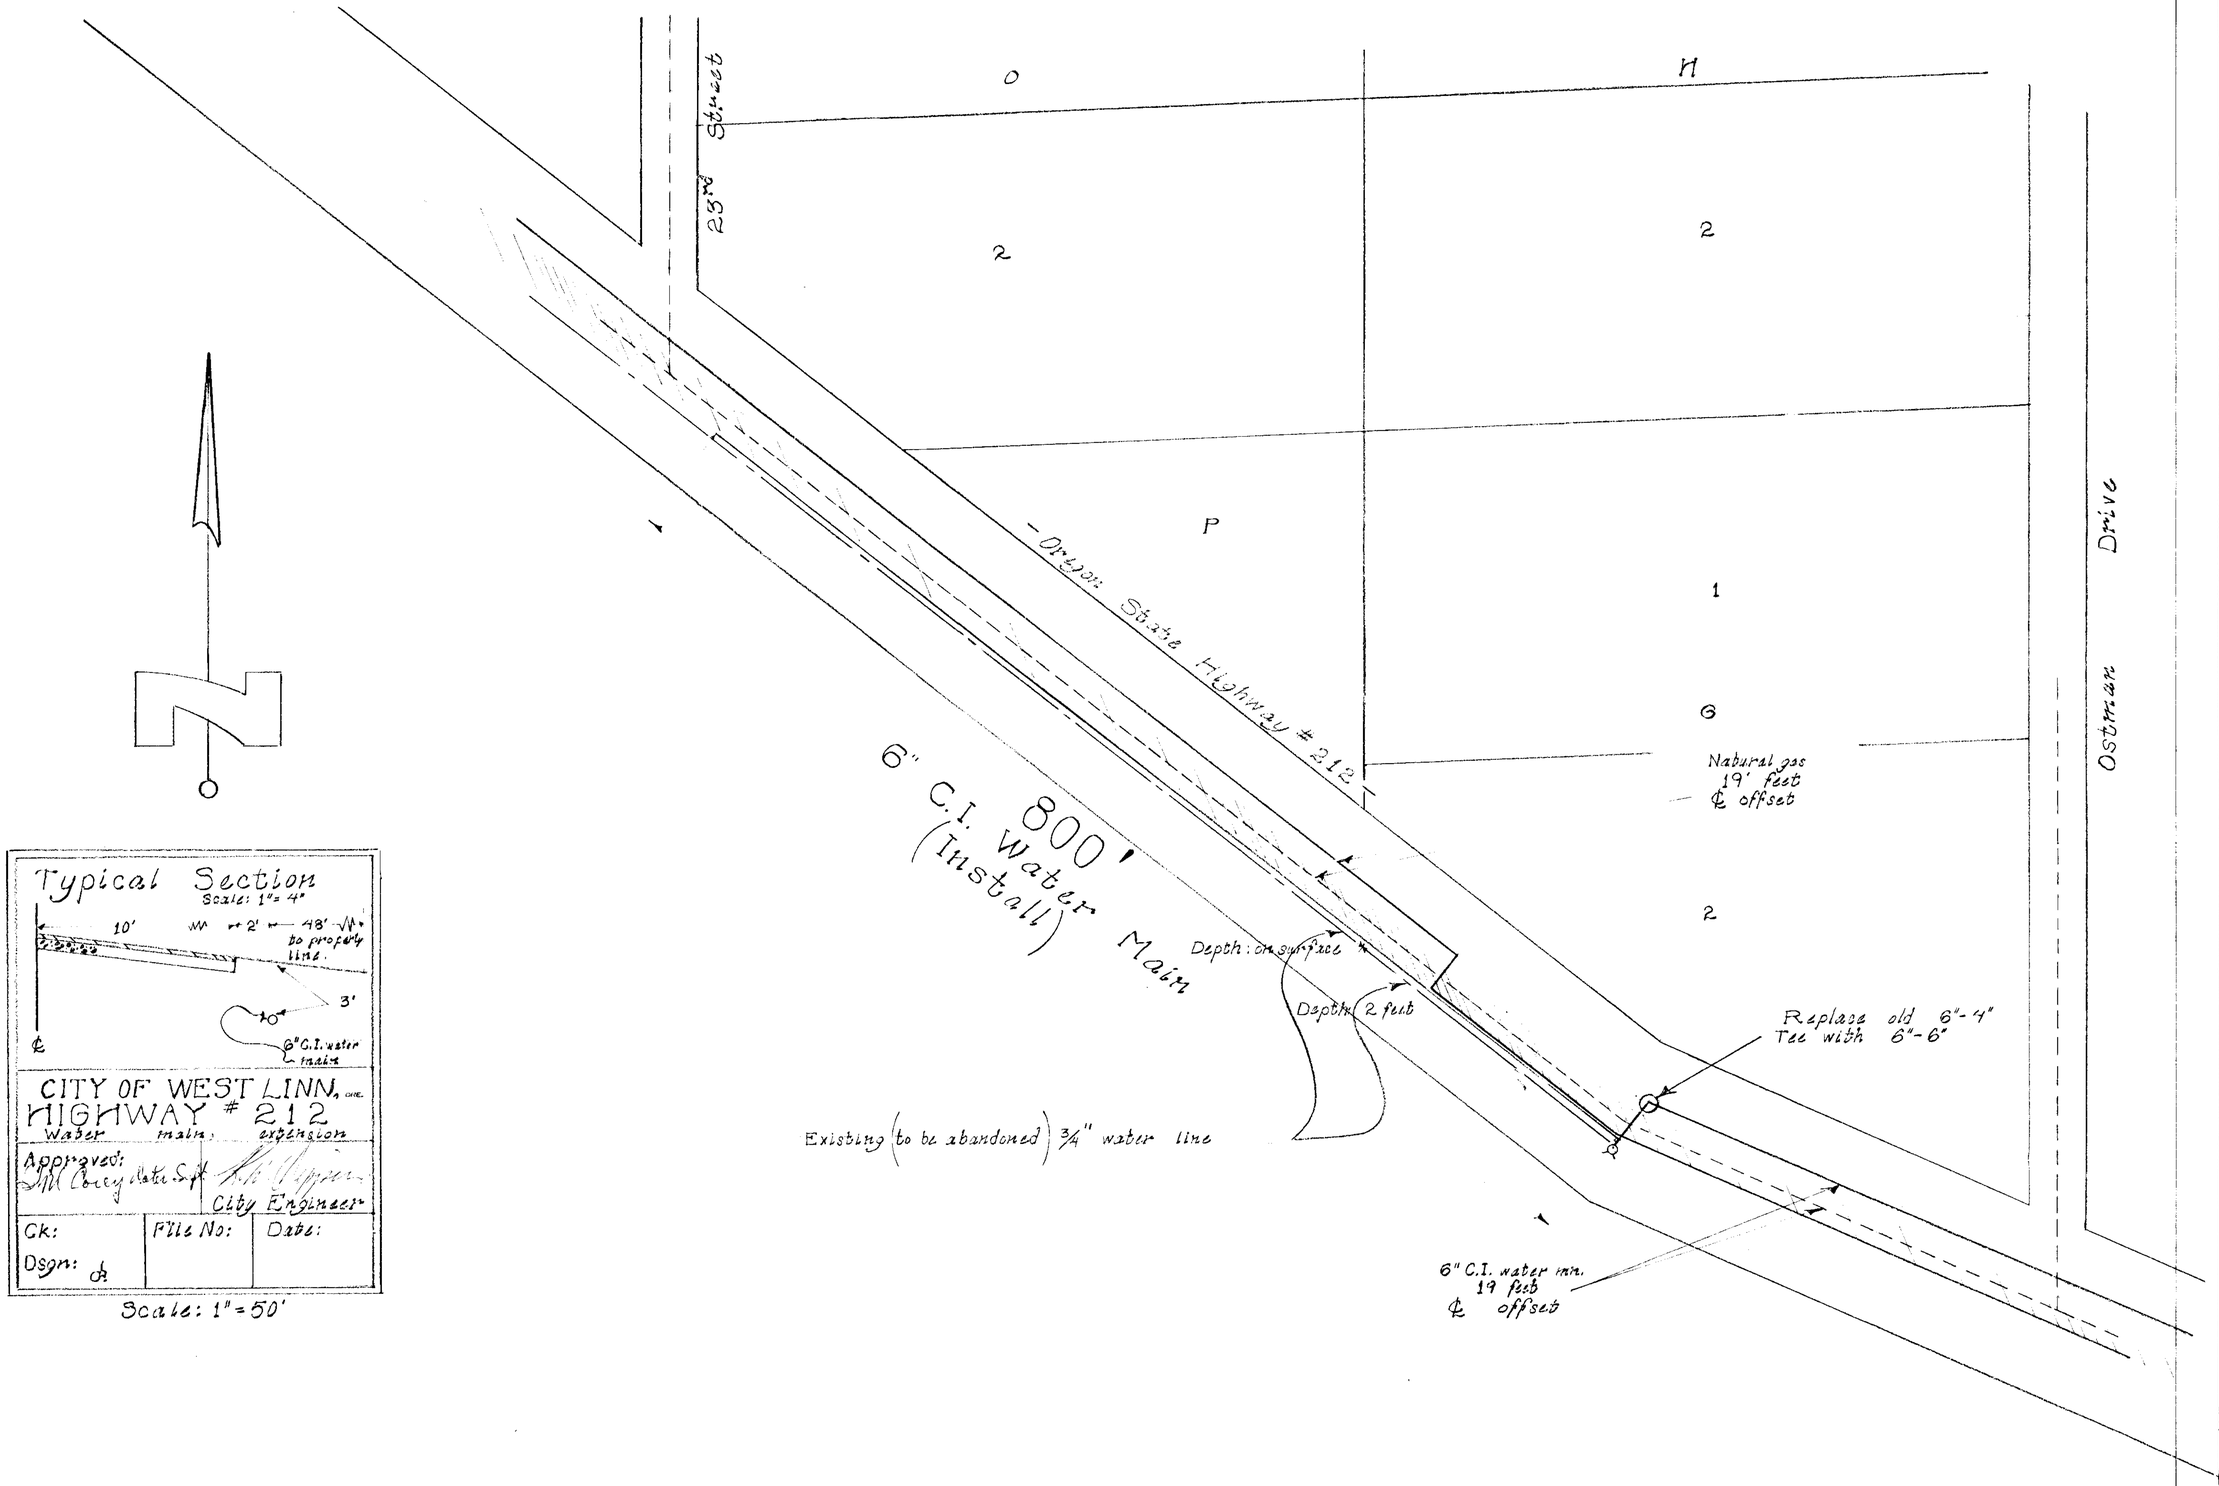
23rd Street
O
H
2
2
P
1
G
2
Oregon State Highway # 212
6" C.I. 800' Water Main (Install)
Natural gas 19' feet ℄ offset
Depth: on surface
Depth: 2 feet
Replace old 6"-4" Tee with 6"-6"
Existing (to be abandoned) 3/4" water line
6" C.I. water mn. 19 feet ℄ offset
Ostman Drive
Typical Section
Scale: 1" = 4'
10'
2'
48' to property line
3'
6" C.I. water main
℄
CITY OF WEST LINN, ORE.
HIGHWAY # 212
Water main extension
Approved:
City Engineer
Ck:
Dsgn:
File No:
Date:
Scale: 1" = 50'