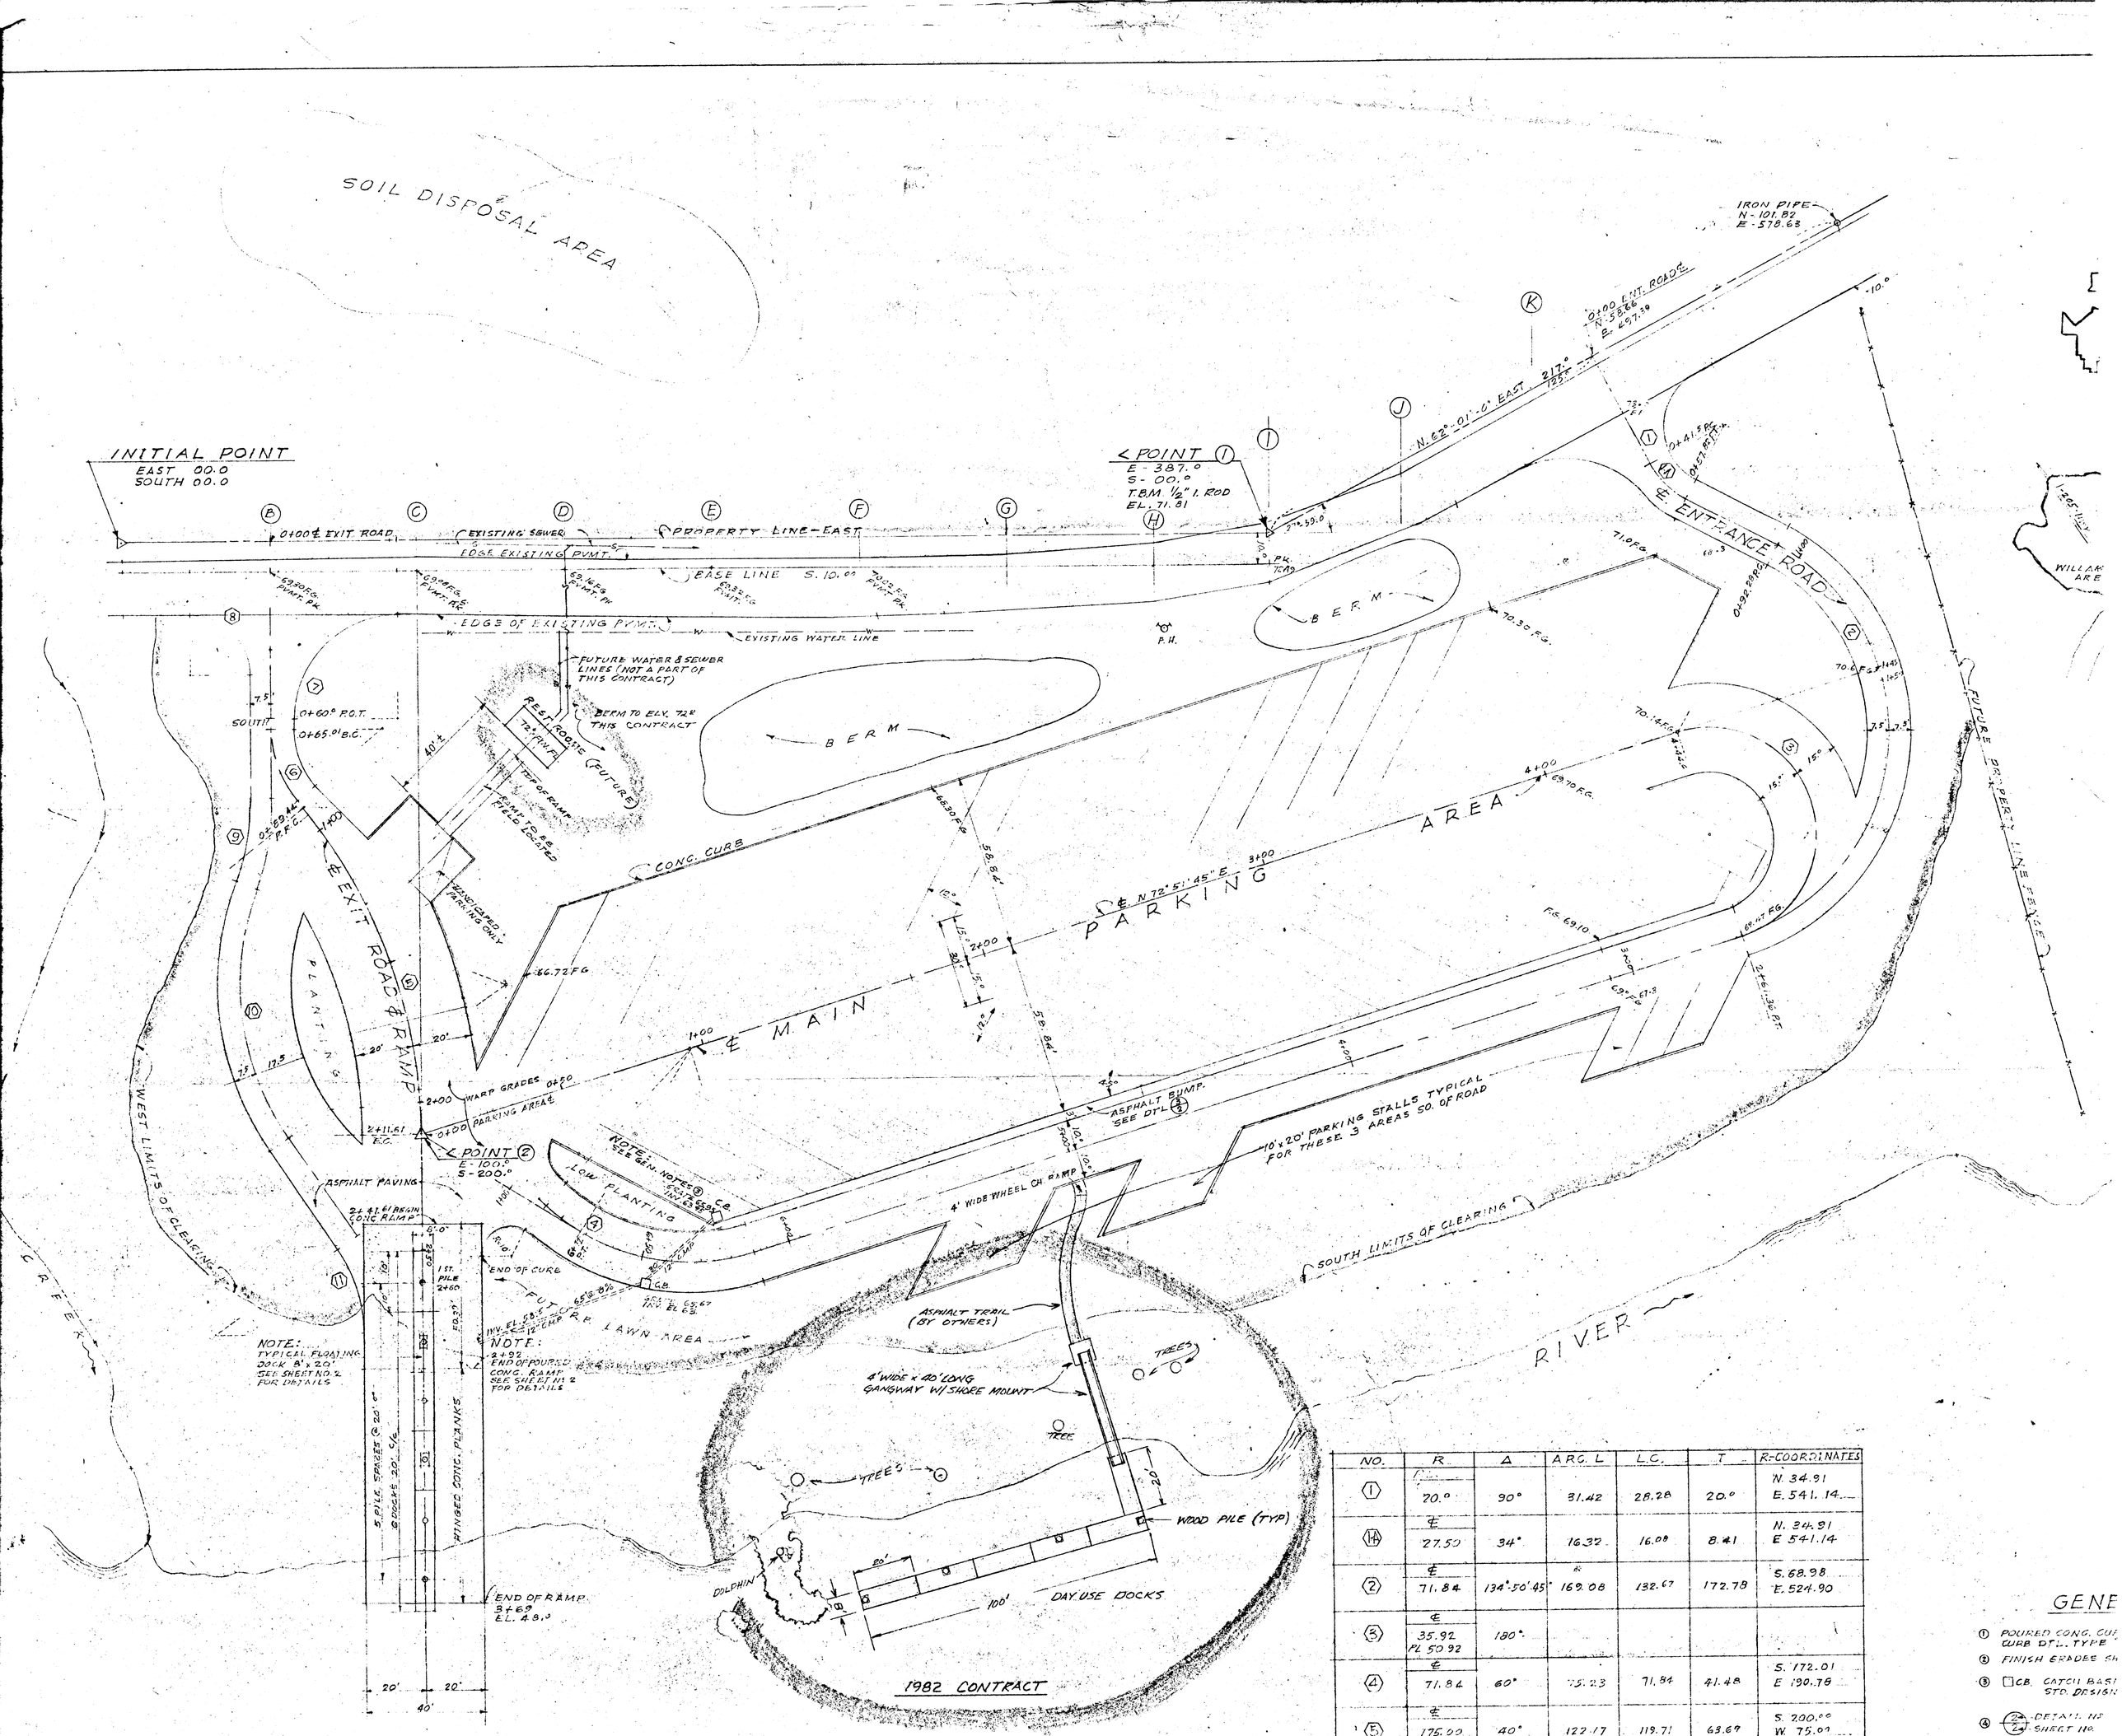

SITE PLAN

SCALE: 1" = 20'

NO.	R	Δ	ARC. L	L.C.	T	R-COORDINATES
1	PL 20.0	90°	31.42	28.28	20.0	N. 34.91 E. 541.14
14	℄ 27.50	34°	16.32	16.08	8.41	N. 34.91 E 541.14
2	℄ 71.84	134°-50'-45"	169.08	132.67	172.78	S. 68.98 E. 524.90
3	℄ 35.92 PL 50.92	180°				
4	℄ 71.84	60°	75.23	71.84	41.48	S. 172.01 E 190.78
5	℄ 175.00	40°	122.17	119.71	63.69	S. 200.00 W. 75.00
6	℄ 35.00	40°	24.43	23.94	12.74	S. 65.01 E. 85.87
7	PL 35.00	90°	PL 54.98	49.50	PL 35.00	S. 60.00 E. 93.37
8	PL 20.00	90	PL 31.42	28.28	PL 20.00	S 45.00 E 22.37
9	PL 75.0	21°-30'	28.14	27.98	28.14	S. 90.00 W 24.13
10	℄ 90	56°-00'	87.96	84.50	47.85	S 150.47 E. 129.39
11	PL 50.0	34°-30'	34.30	29.65	15.53	S 266.61 E 80.00

GENE

1. POURED CONC. CUR CURB DTL. TYPE
2. FINISH GRADES SH
3. □CB. CATCH BASI STD. DESIGN
4. 2+ DETAIL NO / 2+ SHEET NO.
5. EXIS
6. TREES TO BE SAVE PRIOR TO

DESIGNED D.K.K.	APPROVED		
DRAWN L.P.	SCALE 1" = 20 FT	DATE SEPT. 1990	
CHECKED J.W.D.	FILE		

CITY OF WEST LINN
OREGON
PUBLIC WORKS DEPARTMENT

WILLAMETTE PARK BOAT RAMP

PLAN