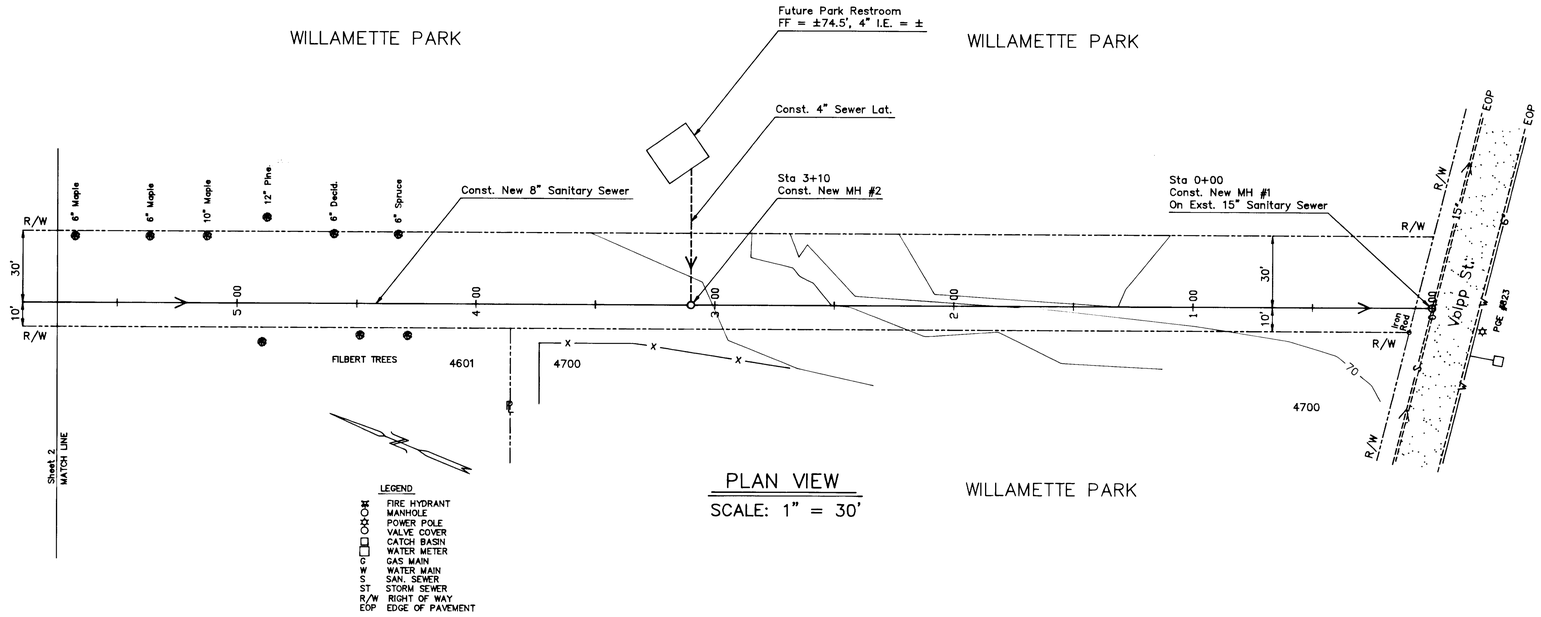

LEGEND

- FIRE HYDRANT
- MANHOLE
- POWER POLE
- VALVE COVER
- CATCH BASIN
- WATER METER
- G GAS MAIN
- W WATER MAIN
- S SAN. SEWER
- ST STORM SEWER
- R/W RIGHT OF WAY
- EOP EDGE OF PAVEMENT

PLAN VIEW

SCALE: 1" = 30'

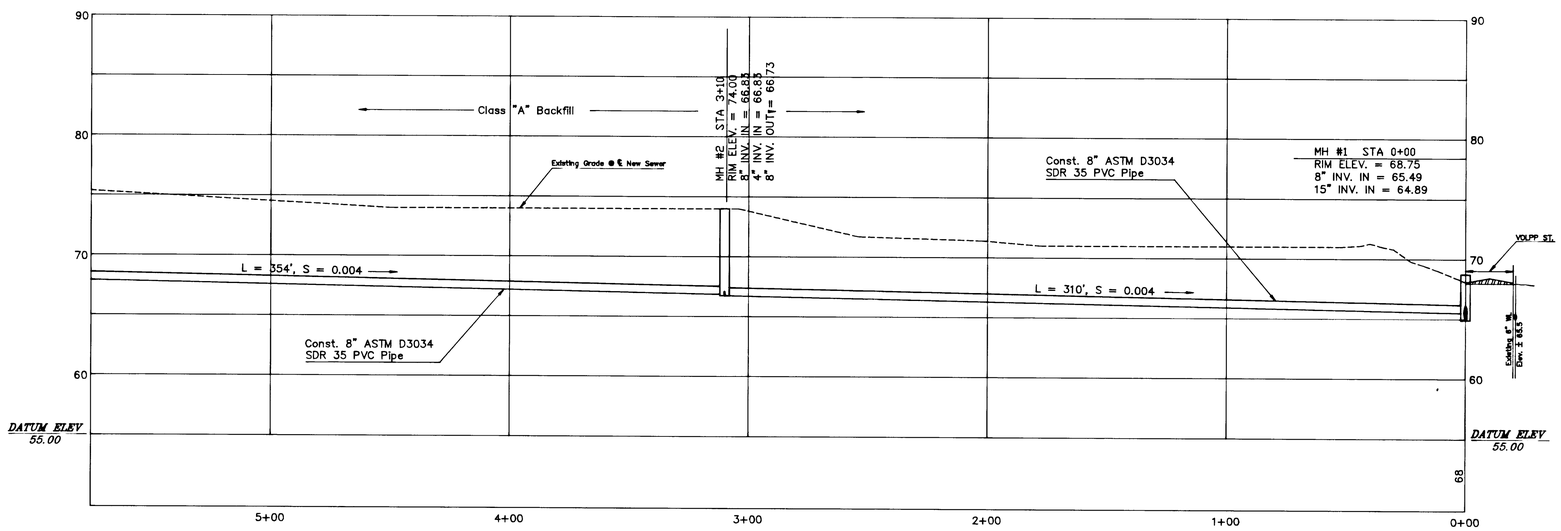

PROFILE VIEW

H: 1" = 30'
V: 1" = 6'

AS BUILT 8/92

REGISTERED PROFESSIONAL ENGINEER 14,958 OREGON JULY 25, 1990 KEITH D. GARLINGHOUSE

DATE	NO.	REVISION	DRAWN BY: REPPETO/K.KEMP	CITY OF WEST LINN ENGINEERING DEPARTMENT	WILLAMETTE PARK/11th ST. SANITARY SEWER IMPROVEMENT STA. 0+00 to STA. 5+75	SURVEYED BY: JOHN REPPETO, P.L.S. #657	PROJECT NO. CI-92-05	1/3
			FILE: CI-92-05 DATE: 4-1-93			CHECKED BY: STAFF	DRAWING FILE: 9205P03A	
			SCALE: AS NOTED			DESIGNED BY: K.GARLINGHOUSE, P.E.		

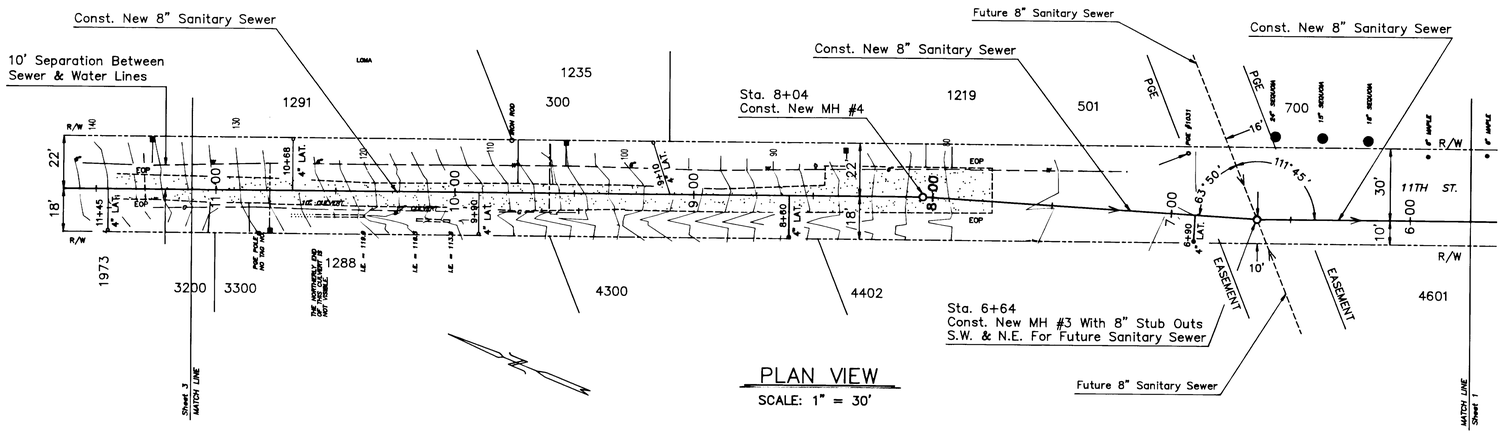

PLAN VIEW

SCALE: 1" = 30'

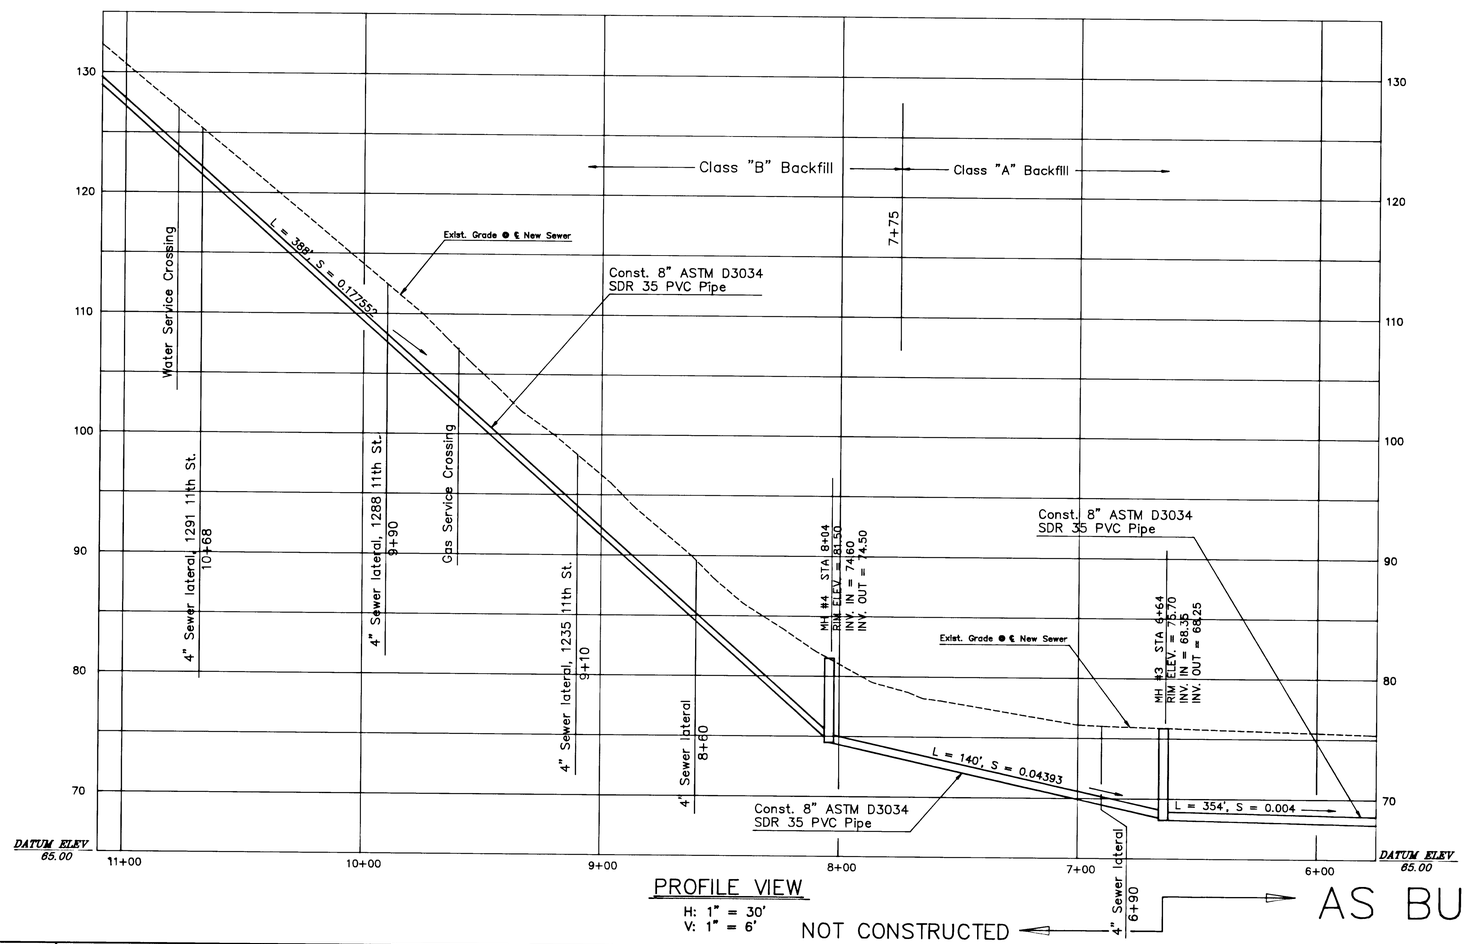

PROFILE VIEW

H: 1" = 30'
V: 1" = 6'

NOT CONSTRUCTED

AS BUILT 8/92

LEGEND

- FIRE HYDRANT
- MANHOLE
- POWER POLE
- VALVE COVER
- CATCH BASIN
- WATER METER
- GAS MAIN
- W WATER MAIN
- S SAN. SEWER
- ST STORM SEWER
- R/W RIGHT OF WAY

REGISTERED PROFESSIONAL ENGINEER 14,958 OREGON MAY 25, 1990 KEITH D. GARLINGHOUSE

DATE	NO.	REVISION

DRAWN BY: REPPETO/K.KEMP
FILE: CI-92-05 DATE: 4-1-93
SCALE: AS NOTED

CITY OF WEST LINN
ENGINEERING DEPARTMENT

WILLAMETTE PARK/11th ST. SANITARY SEWER IMPROVEMENT
STA. 5+75 to STA. 11+10

SURVEYED BY: JOHN REPPETO, P.L.S. # 657
CHECKED BY: STAFF
DESIGNED BY: K.GARLINGHOUSE, P.E.

PROJECT NO. CI-92-05
DRAWING FILE: 9205P02A

2/3

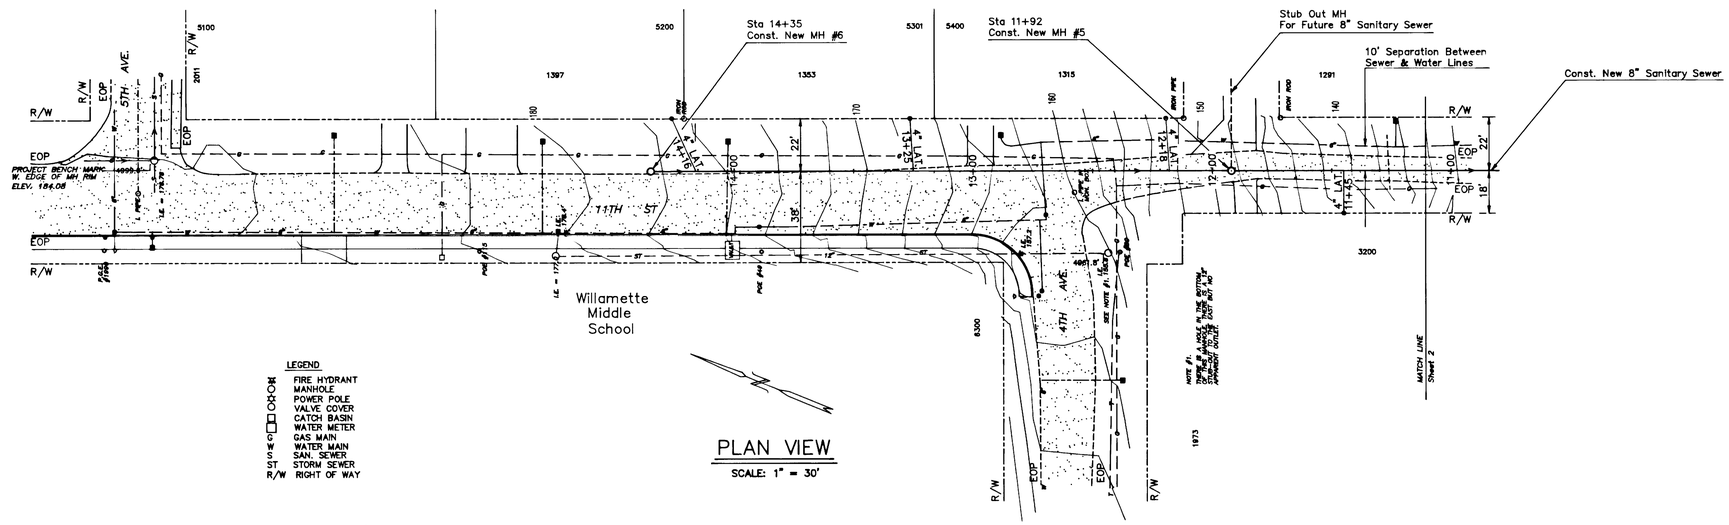

LEGEND

- FIRE HYDRANT
- MANHOLE
- POWER POLE
- VALVE COVER
- CATCH BASIN
- WATER METER
- G GAS MAIN
- W WATER MAIN
- S SAN. SEWER
- ST STORM SEWER
- R/W RIGHT OF WAY

PLAN VIEW

SCALE: 1" = 30'

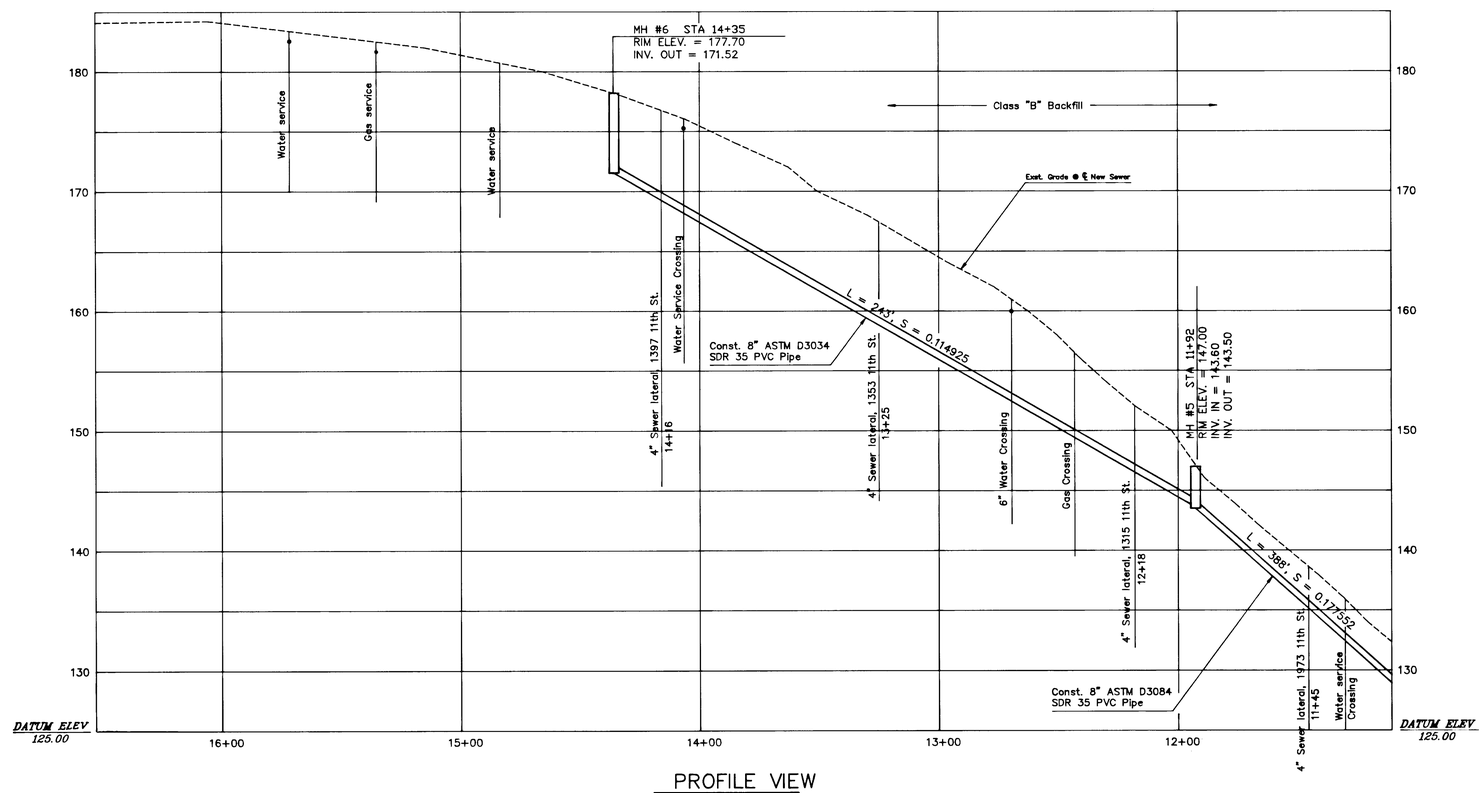

PROFILE VIEW

H: 1" = 30'
V: 1" = 6'

REGISTERED PROFESSIONAL ENGINEER 14,958 OREGON JULY 25, 1990 KEITH D. GARLINGHOUSE

DATE	NO.	REVISION	DRAWN BY: REPPETO/K.KEMP FILE: CI9205 DATE: 4-1-93 SCALE: AS NOTED	CITY OF WEST LINN ENGINEERING DEPARTMENT	WILLAMETTE PARK/11th ST. SANITARY SEWER IMPROVEMENT STA. 11+10 to STA. 14+35	SURVEYED BY: JOHN REPPETO, P.L.S. #657 CHECKED BY: STAFF DESIGNED BY: K.GARLINGHOUSE, P.E.	PROJECT NO. CI-92-05 DRAWING FILE: 9205P01A	3/3