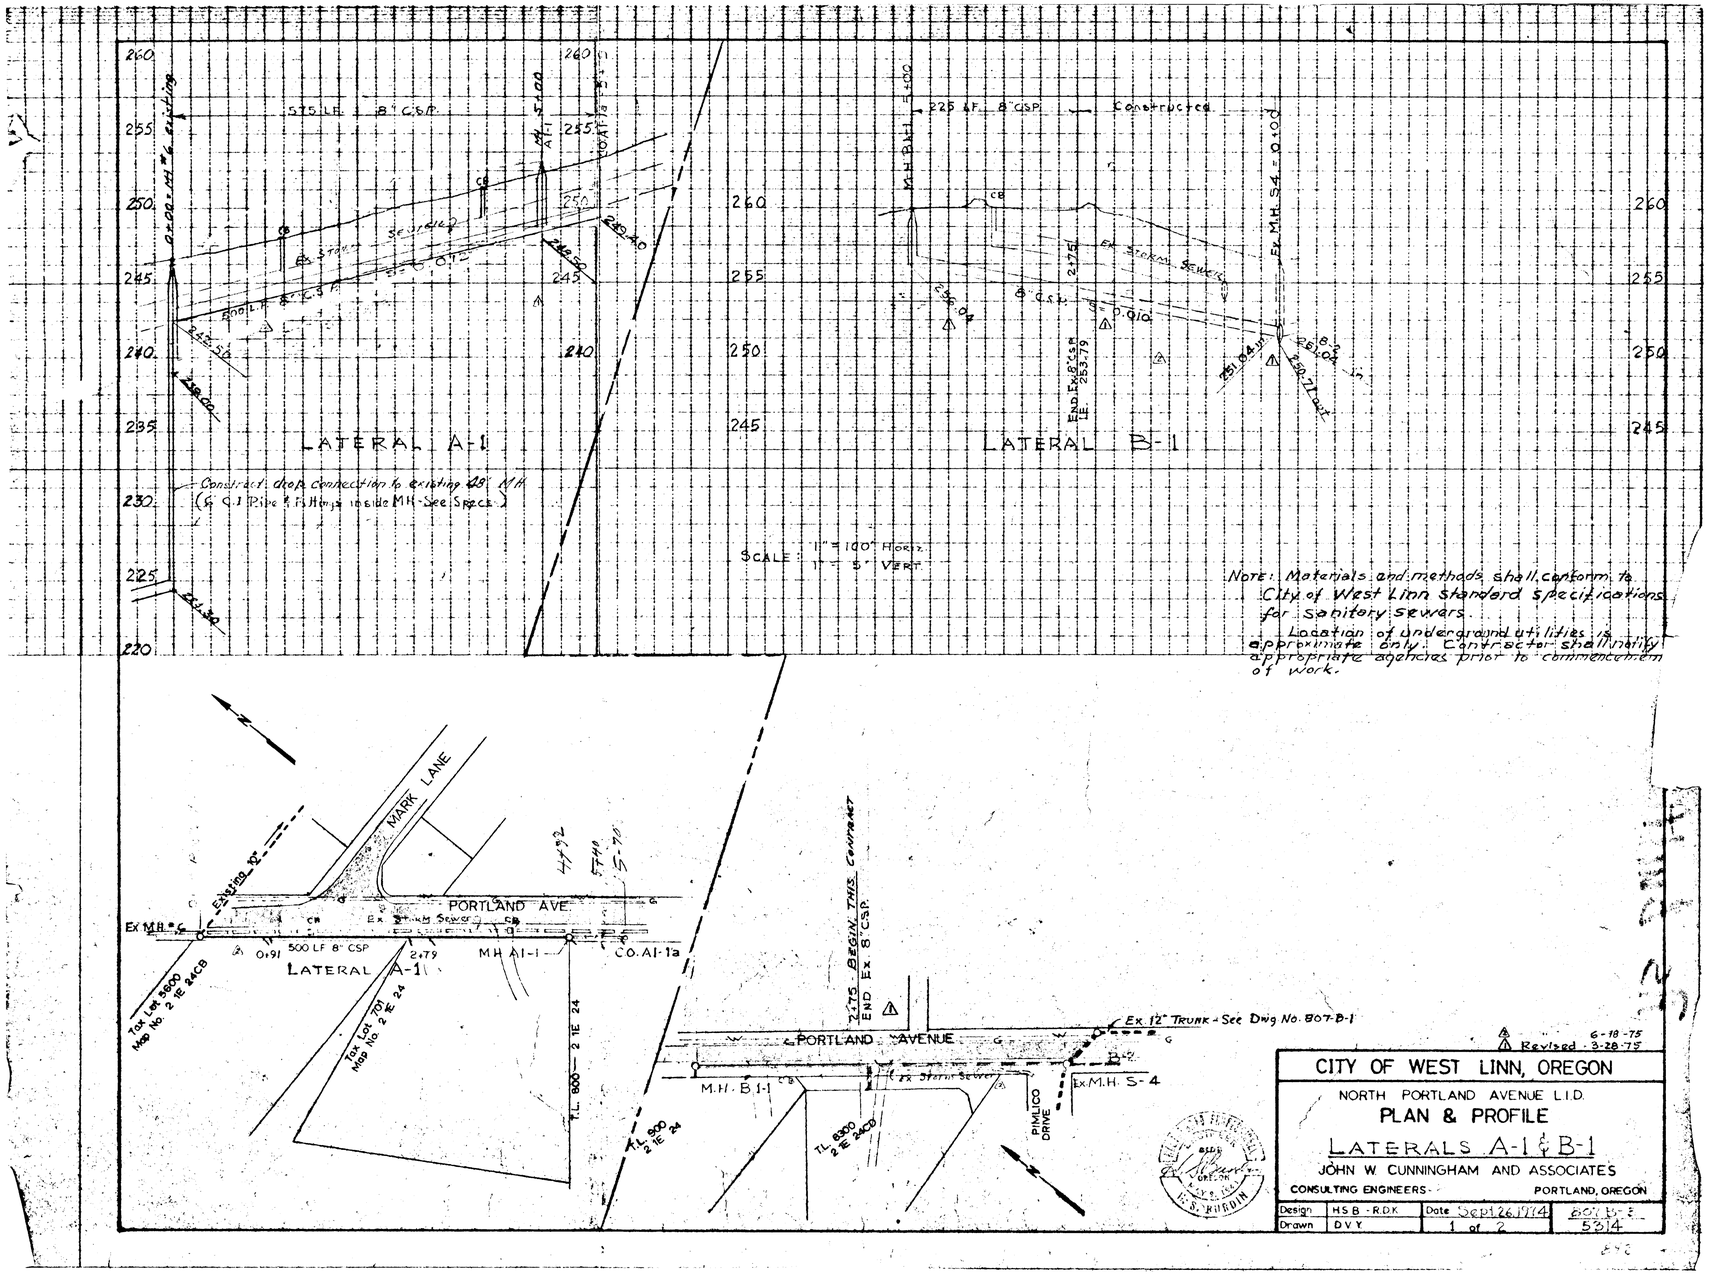

NOTE: Materials and methods shall conform to City of West Linn standard specifications for sanitary sewers.

Location of underground utilities is approximate only. Contractor shall notify appropriate agencies prior to commencement of work.

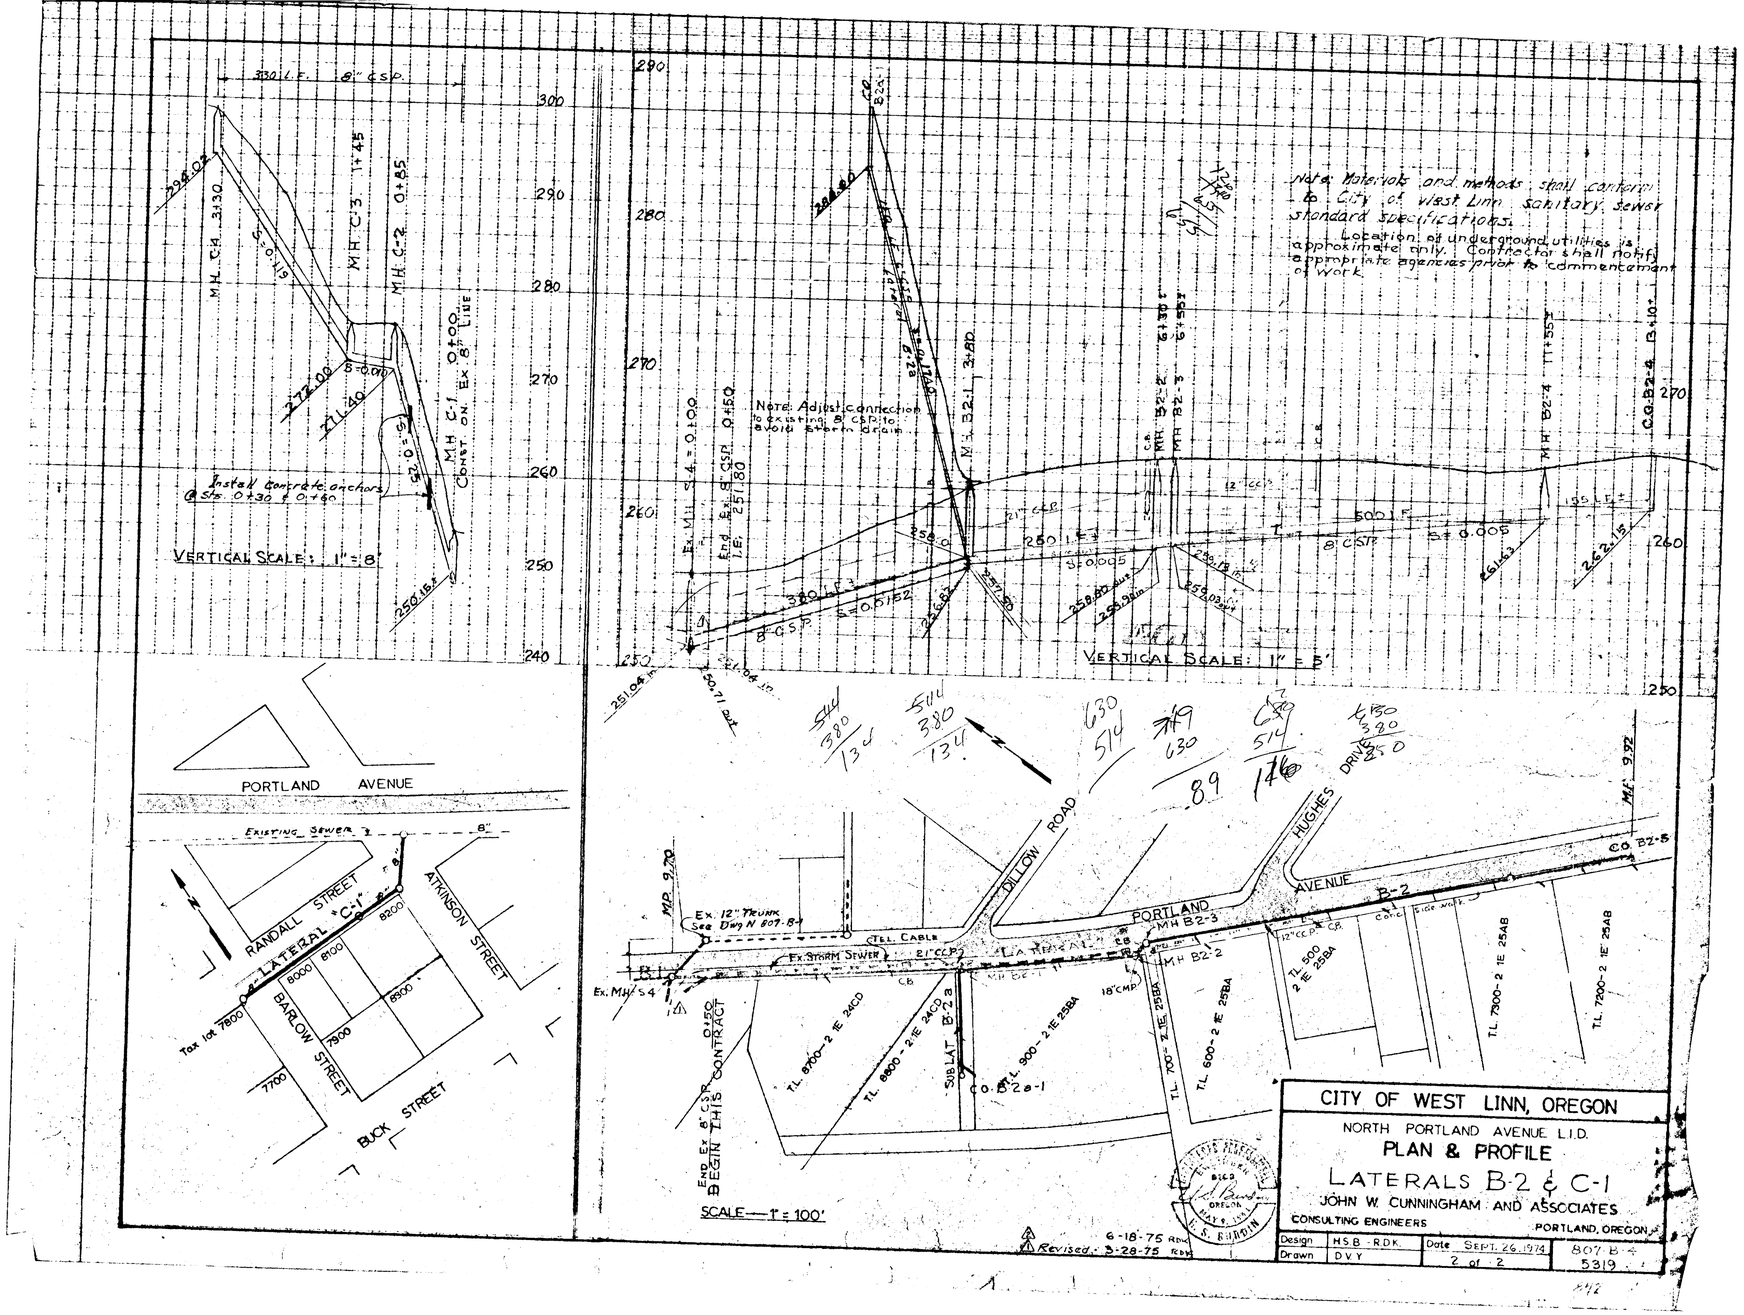

Note: Materials and methods shall conform to City of West Linn sanitary sewer standard specifications.
Location of underground utilities is approximate only. Contractor shall notify appropriate agencies prior to commencement of work.
Note: Adjust connection to existing 8" CSP to avoid storm drain.
VERTICAL SCALE: 1" = 8'
VERTICAL SCALE: 1" = 5'
PORTLAND AVENUE
RANDALL STREET
LATERAL "C-1"
ATKINSON STREET
BARLOW STREET
BUCK STREET
DILLOW ROAD
HUGHES DRIVE
PORTLAND AVENUE
SCALE — 1" = 100'
CITY OF WEST LINN, OREGON
NORTH PORTLAND AVENUE L.I.D.
PLAN & PROFILE
LATERALS B-2 & C-1
JOHN W. CUNNINGHAM AND ASSOCIATES
CONSULTING ENGINEERS
PORTLAND, OREGON
Design H.S.B. - R.D.K.
Drawn D.V.Y.
Date SEPT. 26, 1974
2 of 2
807-B-4
5319