SECTION I

SECTION II

SECTION III

LEGEND
- NEW SEWERS
- EXISTING SEWERS
- MANHOLE
- LAMPHOLE

JOHN W. CUNNINGHAM & ASSOCIATES
CONSULTING ENGINEERS
SPALDING BLDG. PORTLAND, OREGON

CITY OF WEST LINN, OREGON
SEWER IMPROVEMENTS
GENERAL LAYOUT

SCALE: 1" = 300'

		REVISIONS	DATE OCT. 1
DESIGN	E. J. J.		
DRAWN	R.D.K.		NO. 1 OF
TRACED			631-A
CHECKED			403

TRADE STANDARD MARK
PROFILE PLATE A 4 X 20
KEUFFEL & ESSER CO.
NEW YORK
MADE IN U.S.A.

8" C.S.P. 1925'±

8" C.S.P. 1125'±

10" C.S.P. 1650'±

MAIN "J"

MAIN "L"

LAT. L-1

NORTH END INTERCEPTOR

Drop M.H. 0+00 Main "J" = 27+75 Intercept.

Drop M.H. 1+40 = 0+00 Lat. "L-1"

Drop M.H. 0+00 Main "L" = 11+40 Main "J"

Existing Drop M.H. 0+00 = Existing 45.4 River St. Interceptor

Std. M.H. 0+00

Std. M.H. 2+75

Std. M.H. 2+25

Std. M.H. 23+33

Std. M.H. 25+55

Std. M.H. 19+99.30

Std. M.H. 19+52.5

Std. M.H. 16+52.5

Std. M.H. 11+76

Std. M.H. 10+85

Std. M.H. 10+00

Std. M.H. 6+46

Std. M.H. 1+84

Std. M.H. 0+00

Grade 4.91 %

Grade 4.36 %

Grade 0.50 %

Grade 4.74 %

Grade 2.50 %

Grade 0.38 %

Grade 3.90 %

Grade 4.05 %

Grade 1.46 %

Grade 0.90 %

Grade 0.59 %

Grade 0.32 %

Grade 0.50 %

Grade 0.38 %

Grade 0.50 %

Grade 0.50 %

Grade 0.50

KEUFFEL & ESSER CO.
NEW YORK
TRADE STANDARD MADE
PROFILE PLATE A 4 X 20
KEUFFEL & ESSER CO.
MADE IN U.S.A.

8" C.S.P. 325'±

Std. M.H. 0+00

Std. M.H. 1+40

Std. M.H. 2+15

Std. M.H. 3+50

L.H. 2+25

Grade 0.52 %

Grade 0.50%

142.75

148.75

149.9

HOLMES ST. SEWER

8" C.S.P. 550'±

Exist. M.H. Sta. 0+00

Std. M.H. 0+40

Std. M.H. 2+15

Std. M.H. 5+50 = 0+00 No. 4 St.

Grade 2.18 %

1.00 %

139.6

140.35

148.78

148.65

184.0

183.7

PERRIN ST. SEWER

Exist. M.H. Sta. 0+00

Std. M.H. 3+65

Std. M.H. 2+25

Grade 2.00 %

Grade 3.85 %

215.00

180.00

148.65

Std. M.H. 16+90

Std. M.H. 13+10

Std. M.H. 10+80

Std. M.H. 7+70

Grade 1.76 %

1.47 %

Grade 1.47 %

233.00

227.05

223.82

219.10

219.00

Std. M.H. 4+80

Std. M.H. 8+95

L.H. 11+25

Std. M.H. 3+25

Grade 0.50 %

0.50 %

224.10

224.00

226.18

227.33

215.00

WEST "A" (SOUTH) & WEBB ST. SEWERS

8" C.S.P. 1125'±

8" C.S.P. 1660'±

Drop M.H. 5+60

Stub West 210.50

Drop M.H. 9+60

Stub East 197.45

197.35

Grade 4.10 %

Grade 3.96 %

212.50

210.00

202.00

188.10

188.00 Exist. Sewer

Exist. M.H. Sta. 0+00

WEST "A" (NORTH) & ELLIOTT ST. SEWERS

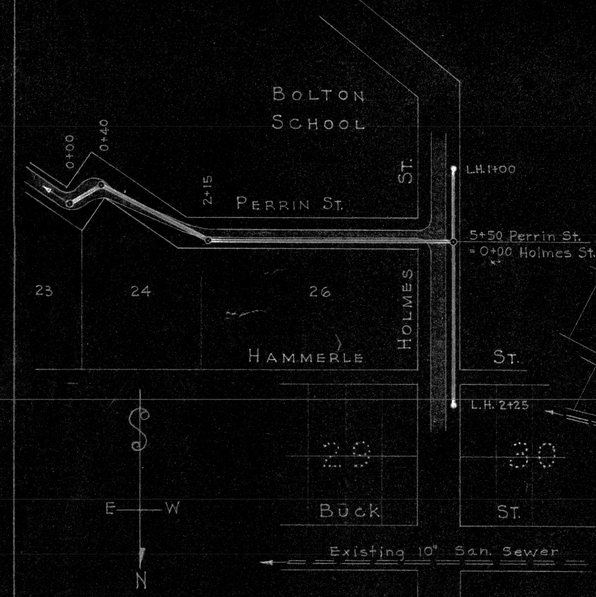

HOLMES & PERRIN ST. SEWERS

SECTION III

WEST "A"-SOUTH & WEBB ST. SEWERS

SECTION II

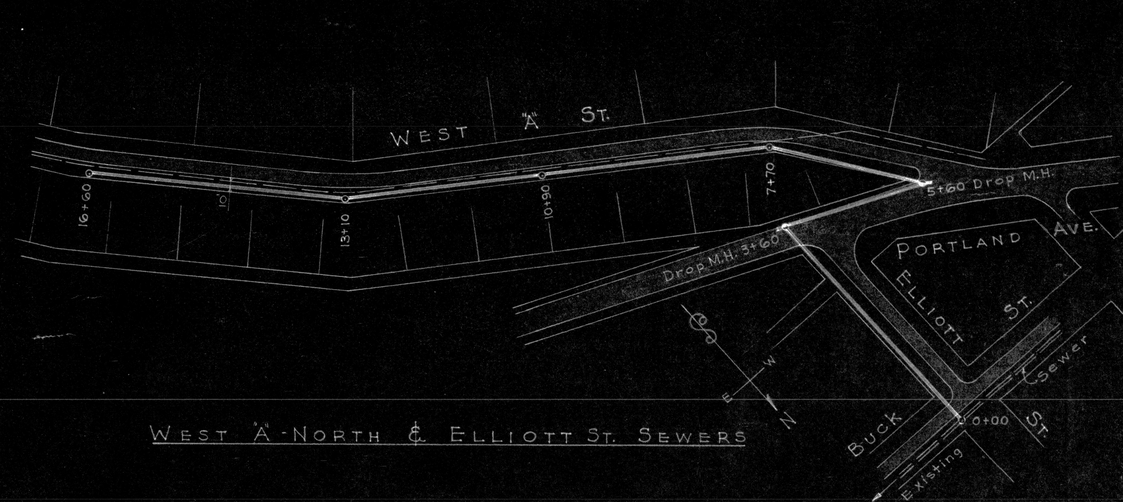

WEST "A"-NORTH & ELLIOTT ST. SEWERS

CITY OF WEST LINN, OREGON
SEWER IMPROVEMENTS
SECTIONS II & III
PLANS & PROFILES
SCALE: HORIZ.: 1"=100'
VERT.: 1"=8'

REGISTERED PROFESSIONAL ENGINEER 2408 Edward J. Jarvis OREGON EDWARD J. JARVIS

JOHN W. CUNNINGHAM & ASSOC.
CONSULTING ENGINEERS
PORTLAND, OREGON
OCTOBER, 1956

631-A-3
4039

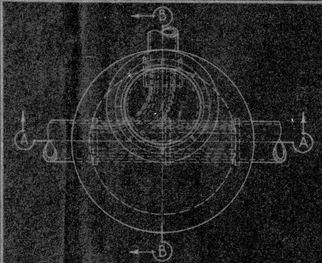

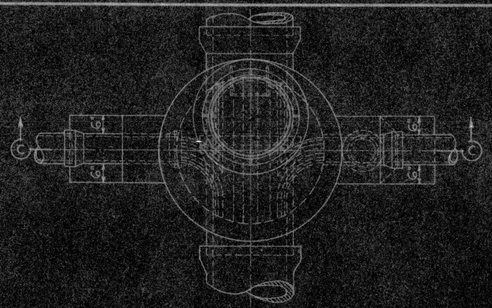

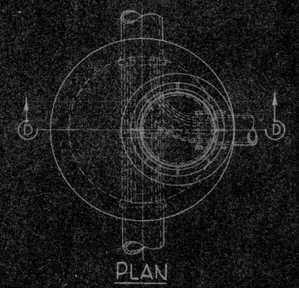

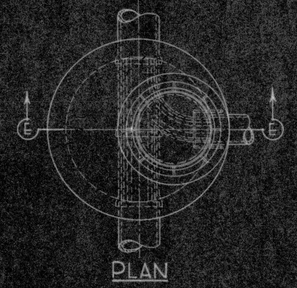

Cover and Frame to be machined to a true bearing all around.

Estimated weight:
Cover - 139 lbs.
Frame - 237 lbs.

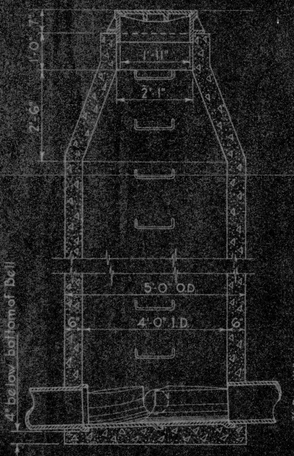

SECTION "A-A"

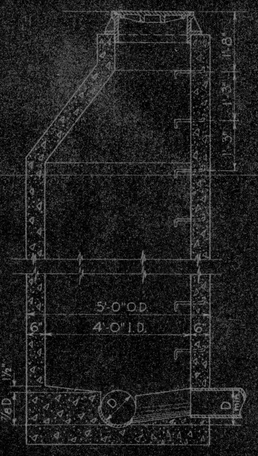

SECTION "B-B"

STANDARD MANHOLE

Scale: ½"=1'-0"

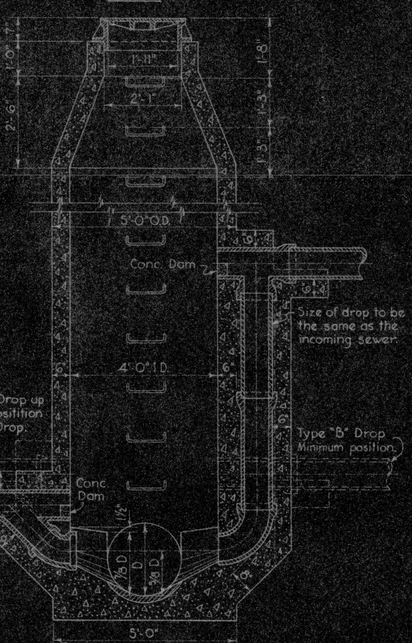

SECTION "C-C"

STANDARD DROP MANHOLE

Scale: ½"=1'-0"

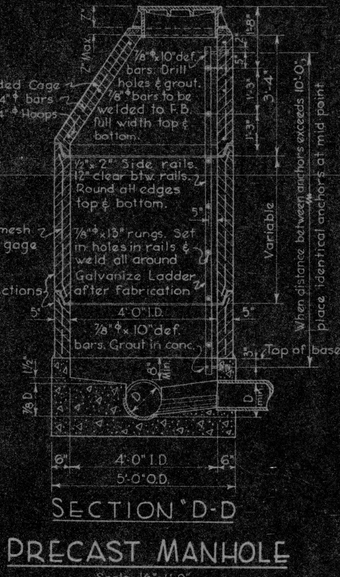

SECTION "D-D"

PRECAST MANHOLE

Scale: ½"=1'-0"

(To be used *only* where specifically provided for in contract & specifications.)

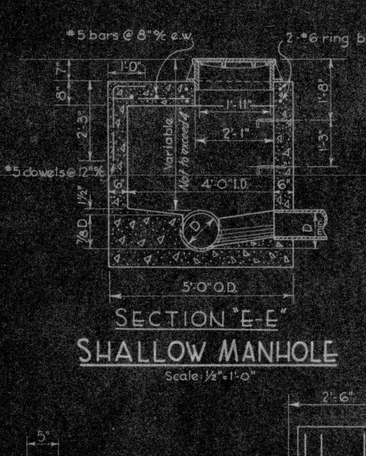

SECTION "E-E"

SHALLOW MANHOLE

Scale: ½"=1'-0"

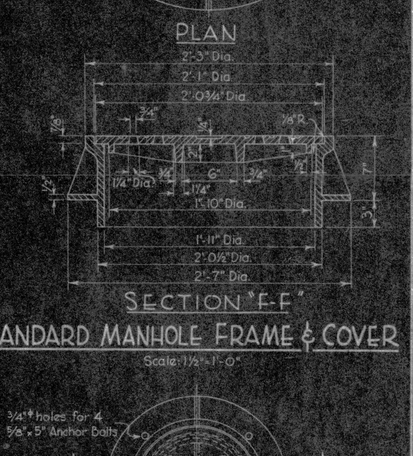

SECTION "F-F"

STANDARD MANHOLE FRAME & COVER

Scale: 1½"=1'-0"

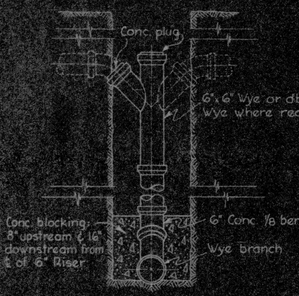

TYPICAL STANDING CONNECTION

Scale: ½"=1'-0"

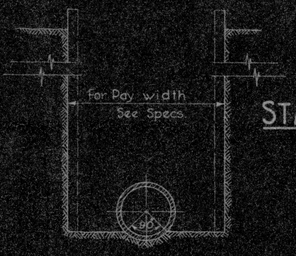

STANDARD BEDDING

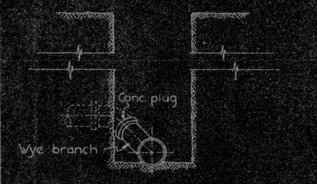

STANDARD HOUSE CONNECTION

Scale: ½"=1'-0"

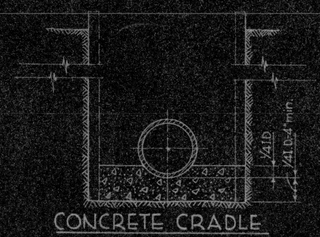

CONCRETE CRADLE

STANDARD BEDDING METHODS

Scale: 1"=1'-0"

STANDARD MANHOLE STEP

Scale: 1"=1'-0"

PLAN

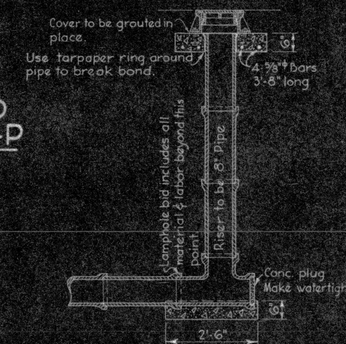

SECTION "H-H"

STANDARD LAMPHOLE

Scale: ½"=1'-0"

PLAN

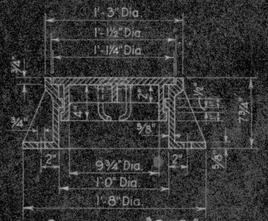

SECTION "G-G"

STANDARD LAMPHOLE FRAME & COVER

Scale: 1½"=1'-0"

JOHN W. CUNNINGHAM & ASSOCIATES
CONSULTING ENGINEERS
PORTLAND TRUST BLDG. PORTLAND, OREGON

CITY OF WEST LINN, OREGON
SEWER IMPROVEMENTS

MANHOLE DETAILS

SCALE: NOTED

DESIGN	E.J.J.	REVISIONS	DATE OCT. 1956
DRAWN			No. 4 OF 4
TRACED	L.M.C.		631-A-4
CHECKED			4040

REGISTERED PROFESSIONAL ENGINEER
STATE OF OREGON
EDWARD J. JAMES