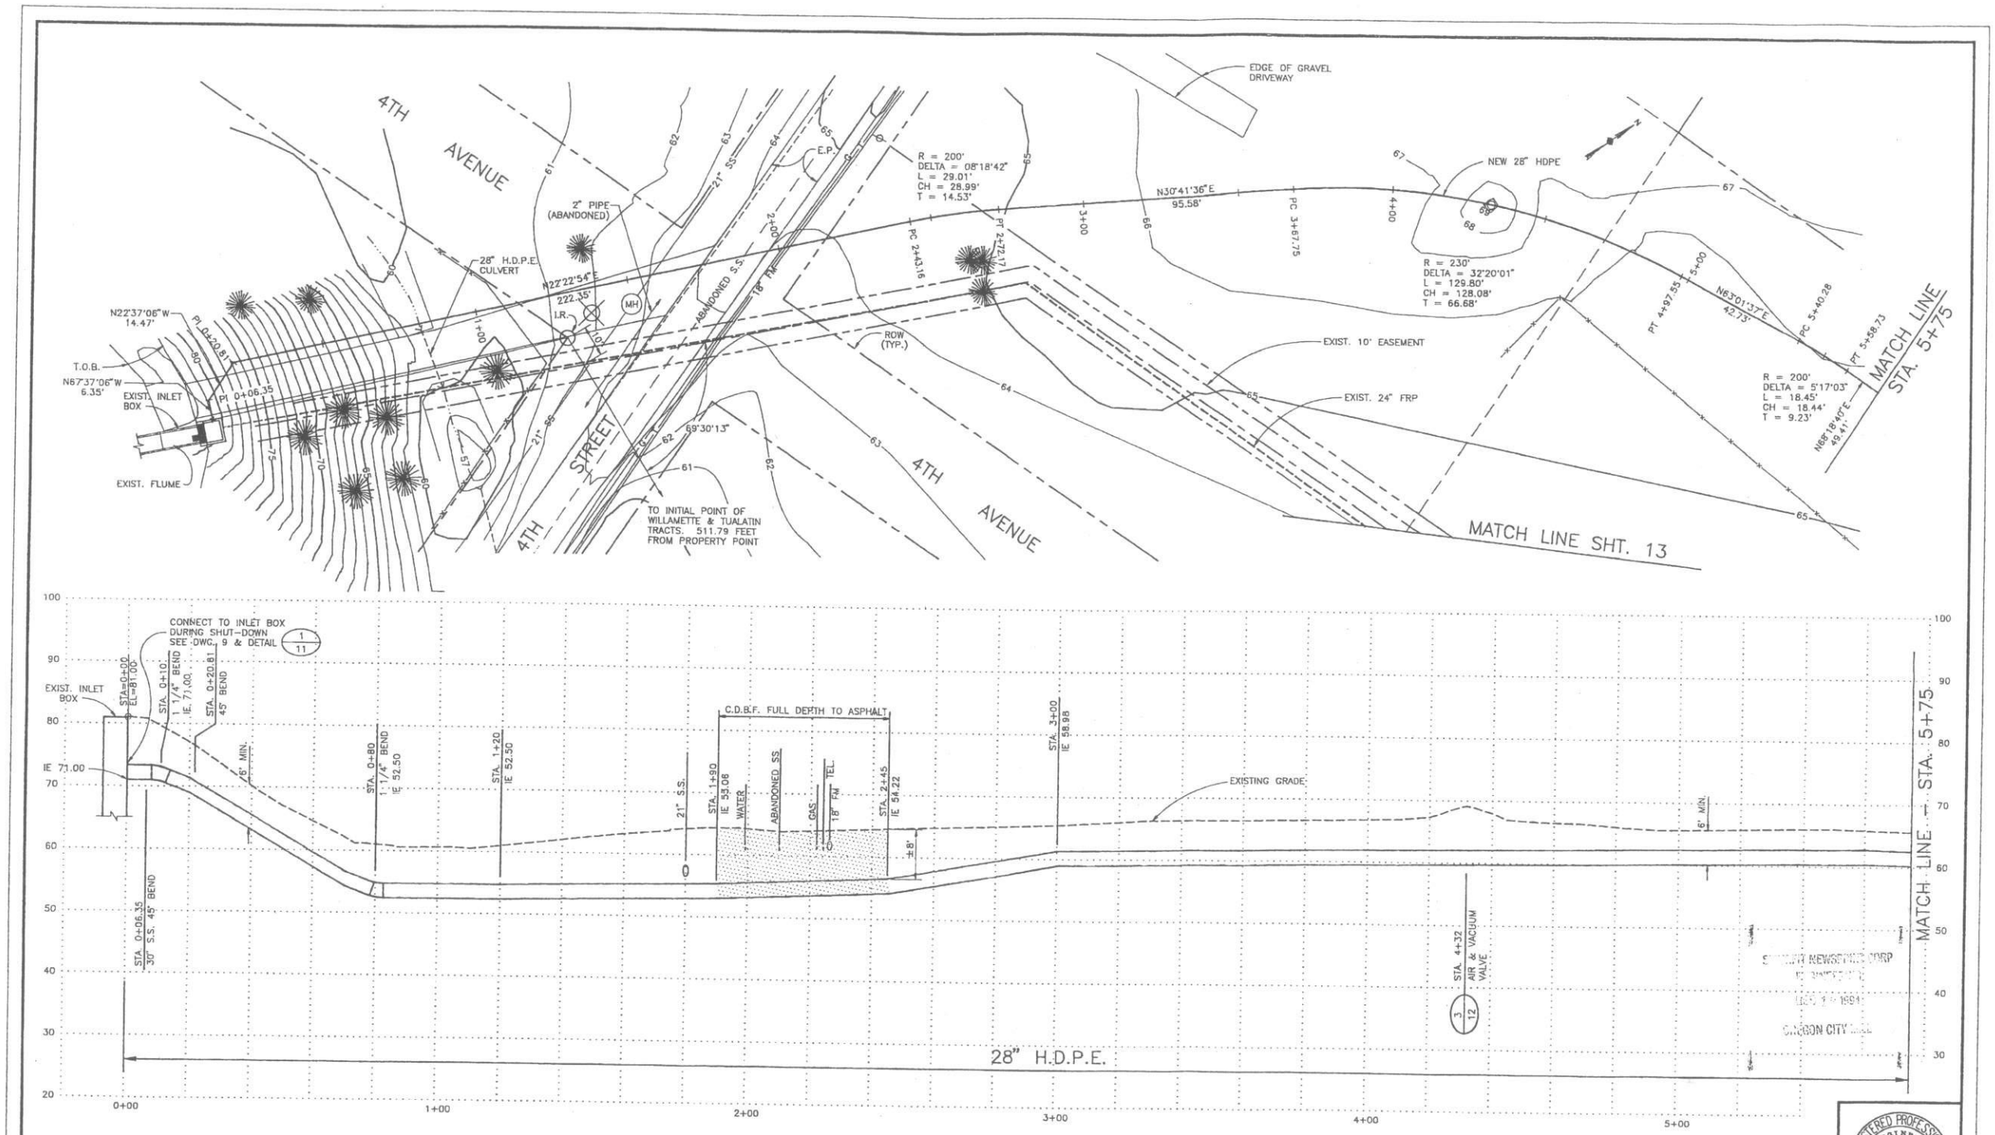

PIPING PLAN AND PROFILE – AT OUTFALL TO LAGOON

DRAWING #668-~~0000~~2000-P-D-10264

REGISTERED PROFESSIONAL ENGINEER 8508 OREGON JULY 11, 1989 ROBERT VIVIAN

			DESIGNED RWV	APPROVED	
			DRAWN SBS	SCALE 1"=20' HOR. 1"=10' VERT.	DATE APRIL 94
11/94	1	RECORD DRAWING	CHECKED RWV	FILE P9402-04-572	
DATE	NO.	REVISIONS	BY		

ACE Consultants, Inc.
Portland, Oregon (503) 297-6139

SMURFIT NEWSPRINT COMPANY
EFFLUENT PIPELINE REPLACEMENT

PLAN & PROFILE
STA. 0+00 – STA. 5+75

1/14

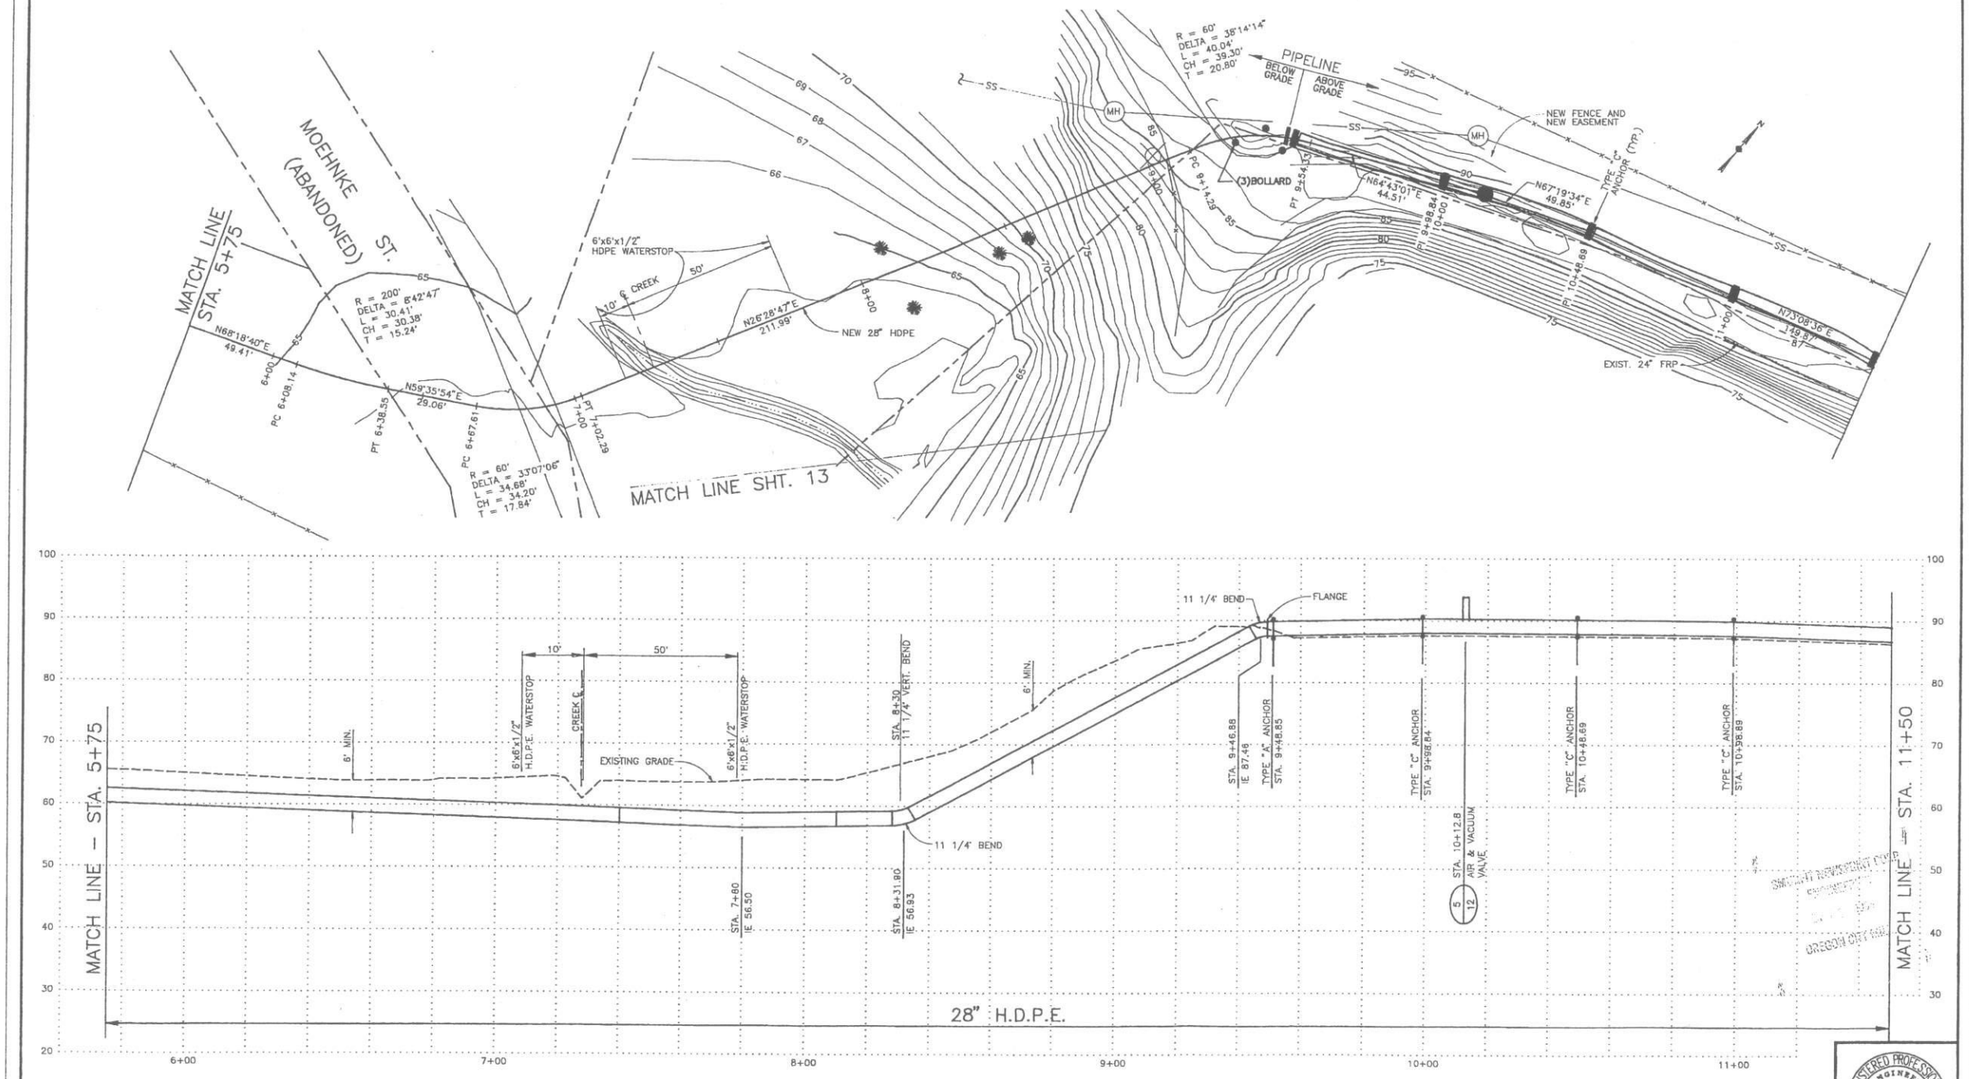

EFFLUENT PIPELINE REPLACEMENT PLAN AND PROFILE

DRAWING #668-~~0000~~ 2000-P-D-10264

REGISTERED PROFESSIONAL ENGINEER 8508 OREGON JULY 11, 1995 ROBERT VIVIAN

				DESIGNED RWV	APPROVED		
11/94	1	RECORD DRAWING	GRH	DRAWN SBS	SCALE 1"=20' HOR. 1"=10' VERT.	DATE APRIL 94	
DATE	NO.	REVISIONS	BY	CHECKED RWV	FILE P9402-04-573		

ACE Consultants, Inc.
Portland, Oregon (503) 297-6139

SMURFIT NEWSPRINT COMPANY
EFFLUENT PIPELINE REPLACEMENT

PLAN & PROFILE
STA. 5+75 – STA. 11+50

2/14

COPYRIGHT © 1994, ACE CONSULTANTS, INC., ALL RIGHTS RESERVED
PLOT DATE: FEB. 04, 1994 TIME: 0:04:24 PM

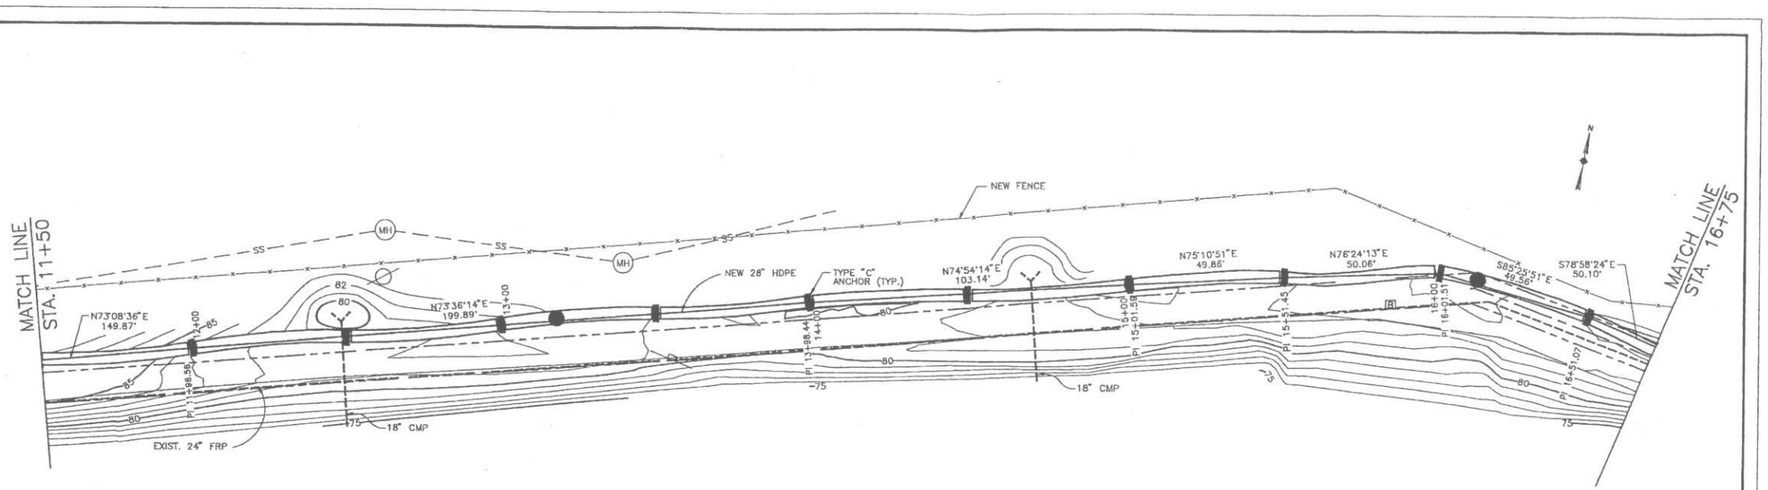

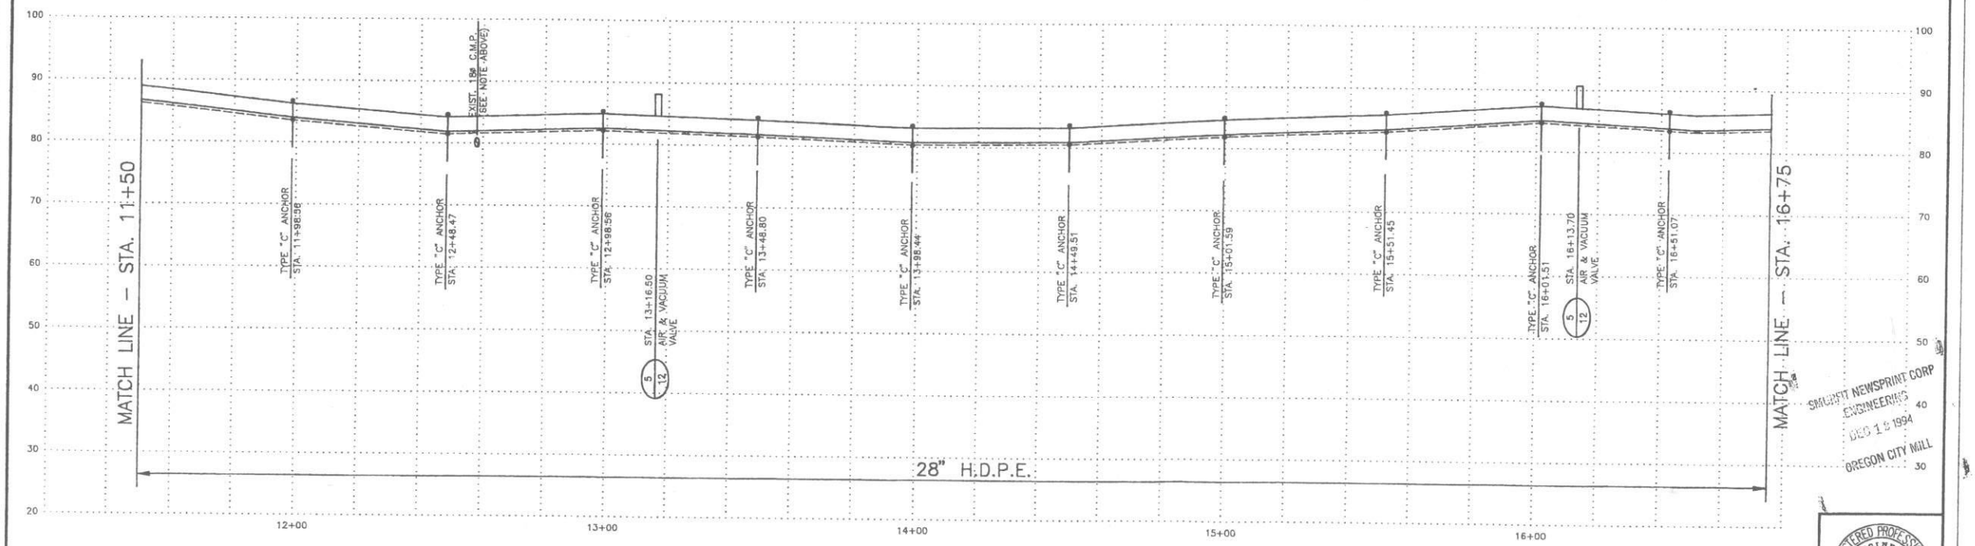

SMURFIT NEWSPRINT CORP
ENGINEERING
DEC 15 1994
OREGON CITY MILL

REGISTERED PROFESSIONAL ENGINEER 8505 OREGON JULY 11, 1975 ROBERT VIVIAN

EFFLUENT PIPELINE REPLACEMENT PLAN AND PROFILE

DRAWING #668-~~0000~~2000-P-D-10264

DATE	NO.	REVISIONS	BY
11/94	1	RECORD DRAWING	GRH

DESIGNED RWV | APPROVED
DRAWN SBS | SCALE 1"=20' HOR. 1"=10' VERT. | DATE APRIL 94
CHECKED RWV | FILE P9402-04-574

ACE Consultants, Inc.
Portland, Oregon (503) 297-6139

SMURFIT NEWSPRINT COMPANY
EFFLUENT PIPELINE REPLACEMENT

PLAN & PROFILE
STA. 11+50 – STA. 16+75

3/14

COPYRIGHT ©1994 ACE CONSULTANTS, INC. ALL RIGHTS RESERVED
PLOT DATE: DEC 14, 1994 PLOT TIME: 2:43:30 PM

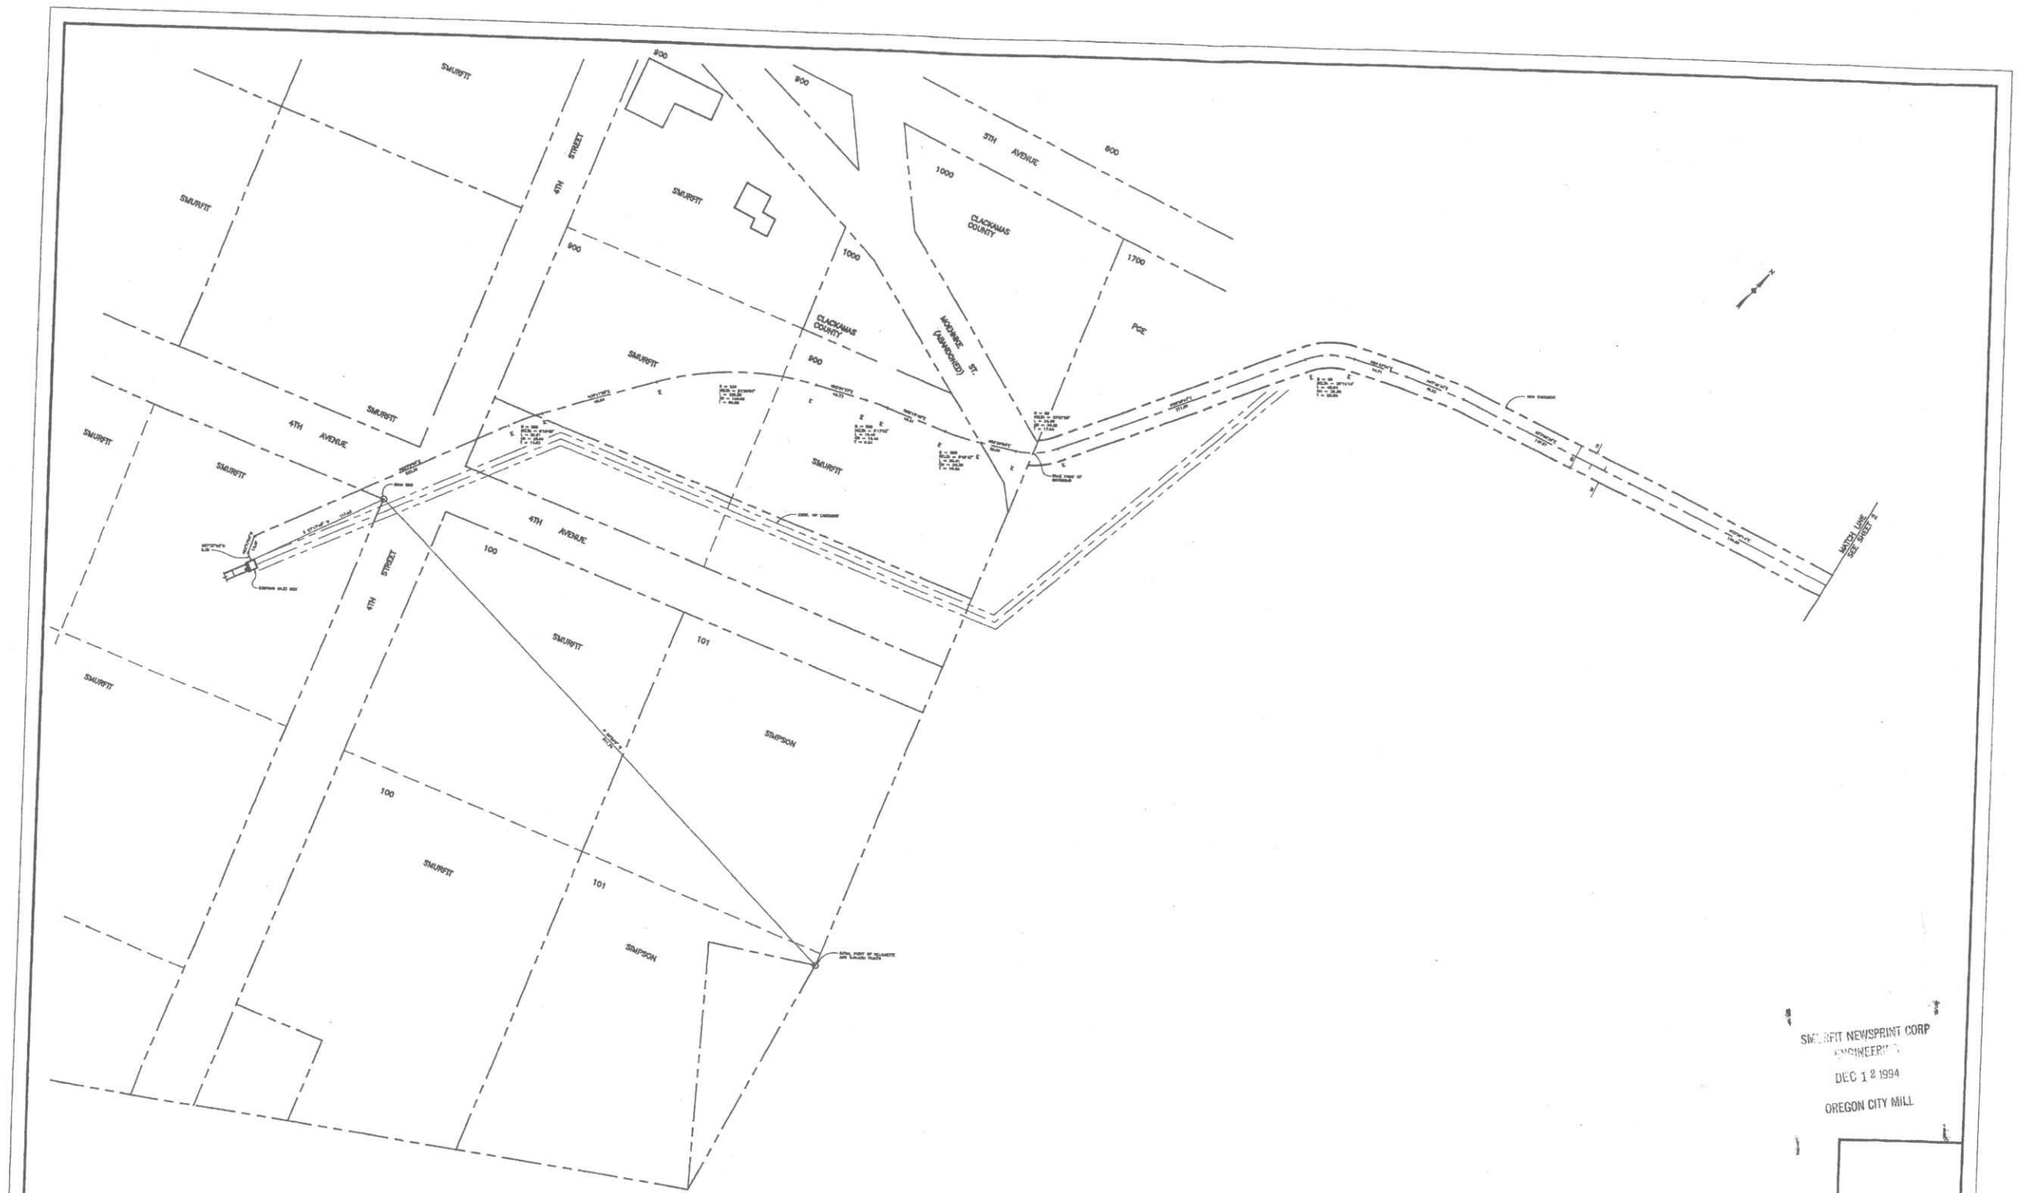

SMURFIT NEWSPRINT CORP
ENGINEERING
DEC 12 1994
OREGON CITY MILL

DATE	NO.	REVISIONS	BY

COPYRIGHT © 1994, ACE CONSULTANTS, INC., ALL RIGHTS RESERVED.
NATIONAL STANDARD: U.S.A. DATE: NOV. 24, 1994 TIME: 03:08:18 PM

DESIGNED	RWV
DRAWN	SBS
CHECKED	RWV
APPROVED	
SCALE	1"=50'
DATE	NOV. 94
FILE	P9402-04-585

ACE Consultants, Inc.
Portland, Oregon (503) 297-6139

SMURFIT NEWSPRINT CORPORATION
EFFLUENT PIPELINE REPLACEMENT

NEW PIPELINE EASEMENT

1/3

DWG. #668-~~0000~~2000-P-D-10265 PAGE 1 OF 3

D-10265

NOTES:

1. FIELD LOCATE ALL AIR RELEASE VALVES & DRAIN VALVES AT ACTUAL HIGH AND LOW POINTS, RESPECTIVELY. LOCATIONS SHOWN ARE APPROXIMATE.
2. VERIFY BY POT-HOLING THE LOCATION AND ELEVATION OF ALL UTILITY CROSSINGS PRIOR TO STARTING CONSTRUCTION OF PIPELINES.
3. MAINTAIN RISING SLOPES DOWNSTREAM OF DRAIN VALVES AND UPSTREAM OF AIR RELEASE VALVES. MAINTAIN FALLING SLOPES UPSTREAM OF DRAIN VALVES AND DOWNSTREAM OF AIR RELEASE VALVES.

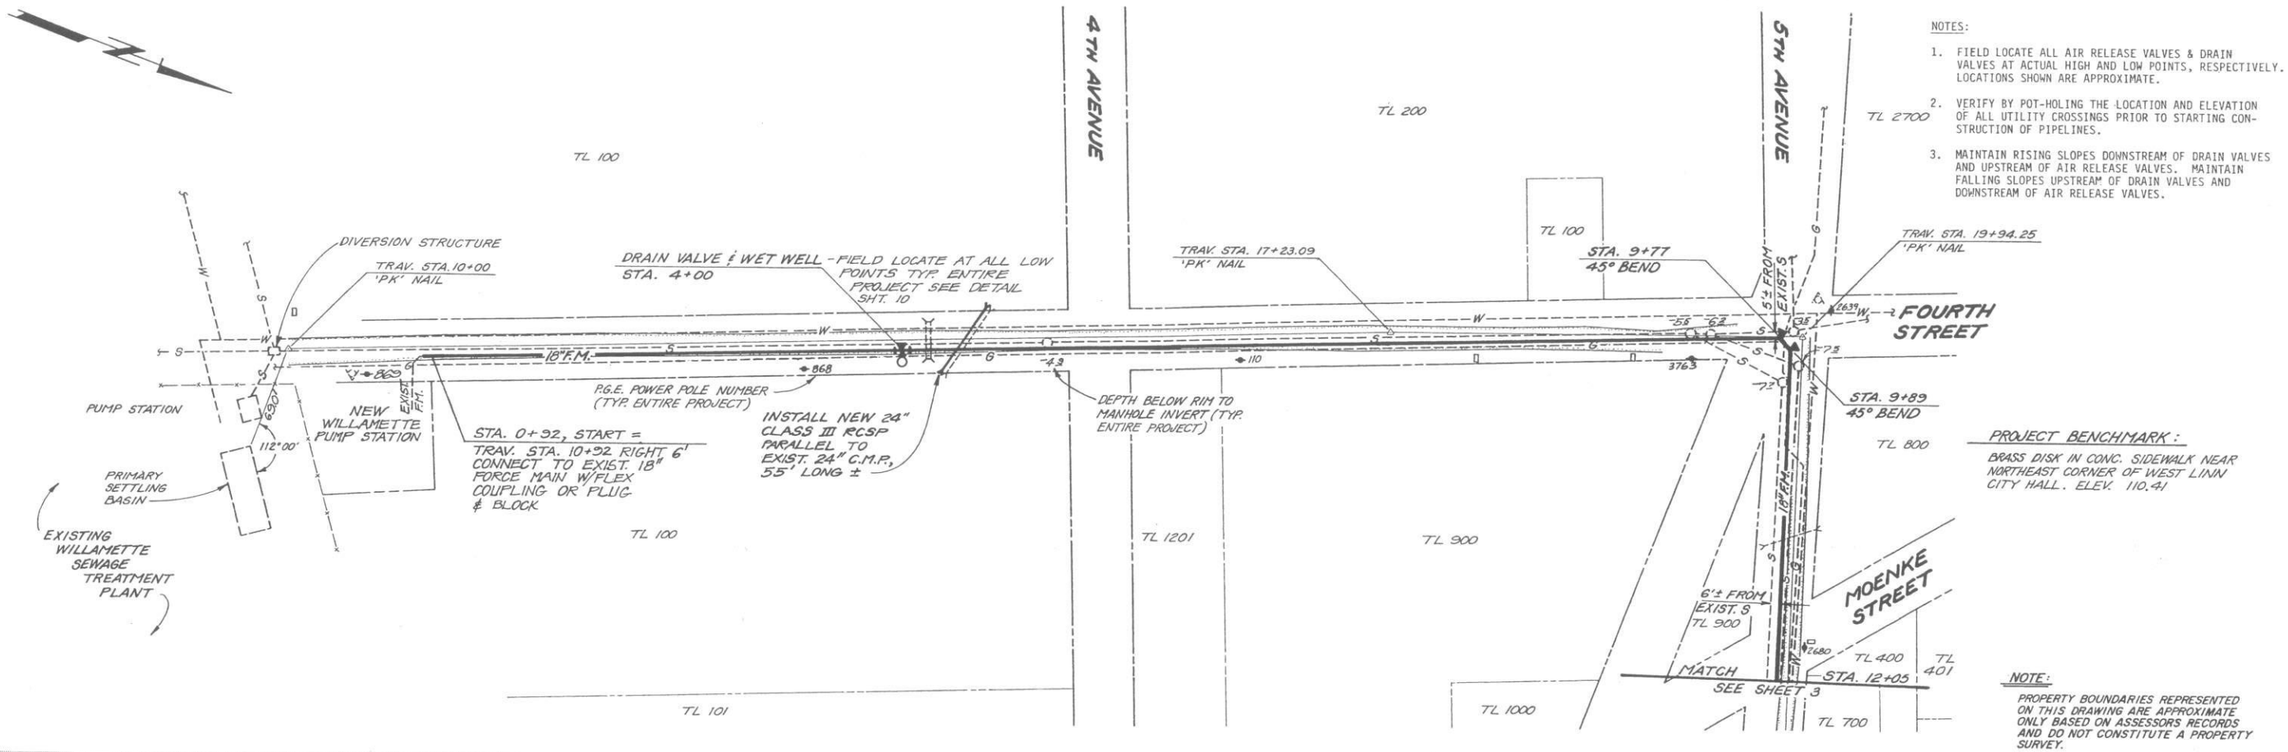

PROJECT BENCHMARK:

BRASS DISK IN CONC. SIDEWALK NEAR NORTHEAST CORNER OF WEST LINN CITY HALL. ELEV. 110.41

NOTE:

PROPERTY BOUNDARIES REPRESENTED ON THIS DRAWING ARE APPROXIMATE ONLY BASED ON ASSESSORS RECORDS AND DO NOT CONSTITUTE A PROPERTY SURVEY.

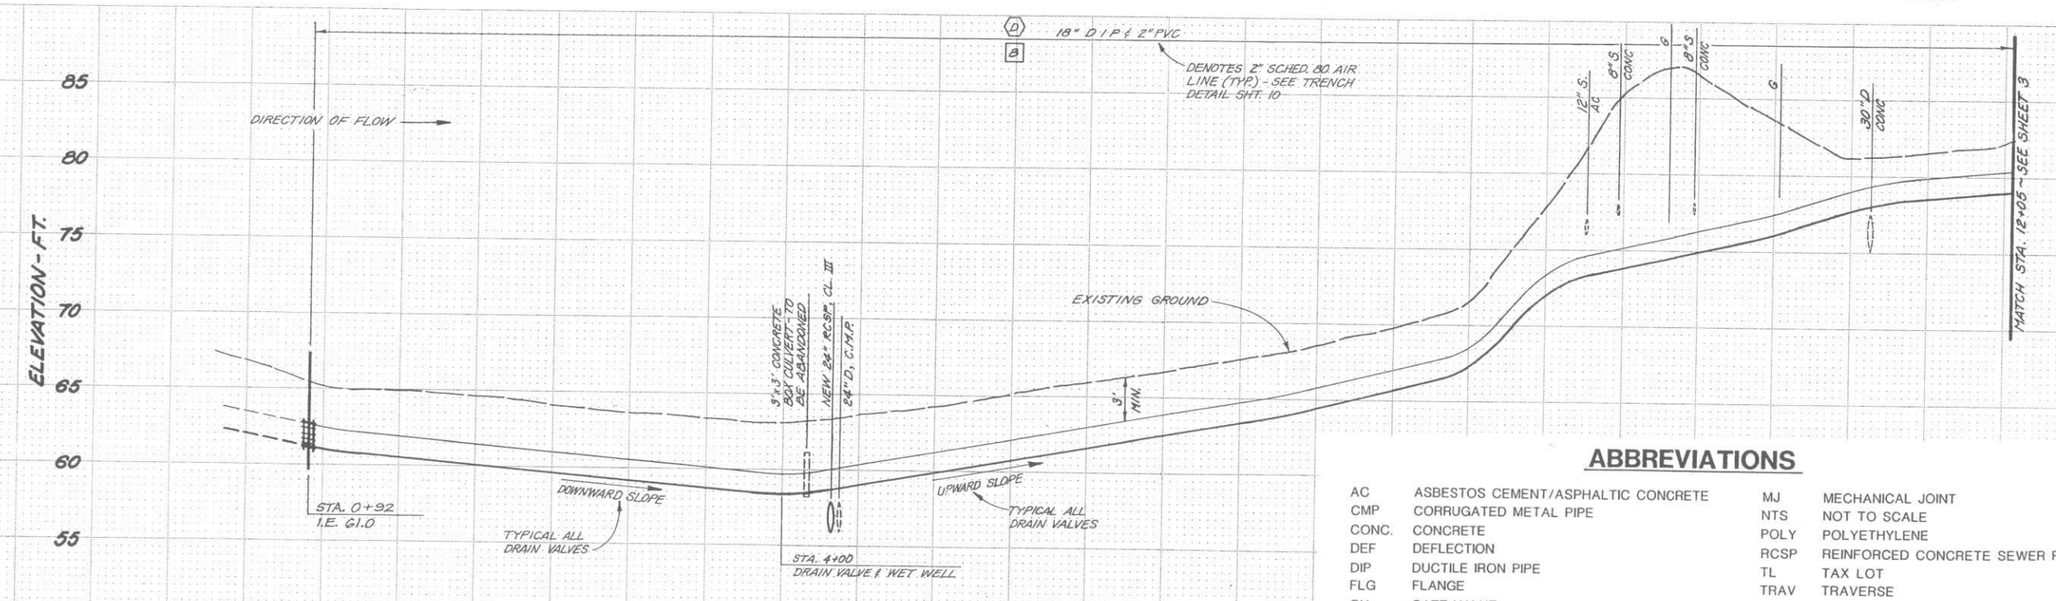

ABBREVIATIONS

AC	ASBESTOS CEMENT/ASPHALTIC CONCRETE	MJ	MECHANICAL JOINT
CMP	CORRUGATED METAL PIPE	NTS	NOT TO SCALE
CONC.	CONCRETE	POLY	POLYETHYLENE
DEF	DEFLECTION	RCSP	REINFORCED CONCRETE SEWER PIPE
DIP	DUCTILE IRON PIPE	TL	TAX LOT
FLG	FLANGE	TRAV	TRAVERSE
GV	GATE VALVE	V	VERTICAL
H	HORIZONTAL	PVC	POLYVINYL CHLORIDE

P.V.C. RIBBED PVC SEWER PIPE

REGISTERED PROFESSIONAL ENGINEER 7754 OREGON JULY 13, 1973 PHILIP H. SMITH

NO.	REVISION	BY	DATE

PLAN & PROFILE
STA. 0+00 to 12+05

SCALE 1" = 50' H., 1" = 5' V. | DATE FEB., 1986

TRI-CITY SERVICE DISTRICT
CLACKAMAS COUNTY, OREGON
WEST LINN FORCE MAIN AND GRAVITY SEWER

DESIGNED NLV | DRAWN R.F.D. | CHECKED PHS

MURRAY, SMITH & ASSOCIATES, INC.
Engineers / Planners
Harrison Square
1800 S.W. First, Suite 510
Portland, Oregon 97201
503-226-1400

MSA

SHEET 2 of 17

FILE NO.

TL 401

TL 500

Les Burmeister

TL 400

TL 700

TL 600

5TH AVE.

STA. 12+05

SEE SHEET 2 MATCH

TL 900

TL 1000

MOEHNKE STREET

TL 900

TL 1000

TL 1703

Steinley

TL 2000

DRAIN VALVE AND WET WELL
STA. 14+59

STA. 15+17
22½° & 11¼° BENDS

TPAV. STA. 26+43.71
HUB & TACK

N.72°16'E. ~300'

106' M/L

N.61°01'E. ~251' M/L

N.72°16'E. ~115'

COMBINATION AIR
VALVE STA. 13+74
FIELD LOCATE AT ALL
HIGH POINTS TYP.
ENTIRE PROJECT SEE
DETAIL SHT. 10

STA. 15+80
45° BEND

20' PERMANENT
EASEMENT

10' TEMPORARY
EASEMENT

N.17°44'W. ~10.00

TL 1700

COMBINATION AIR
VALVE STA. 18+15

STA. 18+48
11¼° BEND

10' PERM. EASE.

10' TEMP. EASE.

N.72°16'E. ~713'

10' MIN. CLEARANCE - TYP.
ALL POLES THIS SHEET

DRAIN VALVE & WET WELL
STA. 18+95

STA. 20+50
AIR INJECTION POINT
SEE DETAIL SHEET 17

10' TEMP. EASE.

10' PERM. EASE.

STA. 23+88
11¼° BEND

STA. 24+10
11¼° BEND

TL 1704
"SCHOOL BUS YARD"

WILLAMETTE FALLS DRIVE

STA. 25+60
11¼° BEND

STA. 25+80
TRAV. STA. 35+80
11¼° BEND

ABOVE GROUND CONC.
ENCASEMENT ON
EXIST. SEWER LINE
(SEE SPECS.)

MATCH STA. 26+00
SEE SHEET 4

NOTE:
PROPERTY BOUNDARIES REPRESENTED ON THIS DRAWING ARE APPROXIMATE ONLY BASED ON ASSESSORS RECORDS AND DO NOT CONSTITUTE A PROPERTY SURVEY.

CONC. PIPE
ENCASEMENT-
SEE DETAIL
SHEET 11

BEARING BASIS : "PLAT OF WILLAMETTE & TUALATIN TRACTS"

D 18" DIP & 2" PVC
B

A 18" DIP & 2" PVC
B

A 18" DIP & 1" PVC
B

STA. 13+77

STA. 20+50

MATCH STA. 12+05 - SEE SHEET 2

MATCH STA. 26+00 - SEE SHEET 4

EXISTING GROUND

EARTH MOUND FOR MIN. COVER

12"S AC

3' MIN.

DOWNWARD SLOPE

TYPICAL ALL
AIR VALVES

DOWNWARD SLOPE

STA. 13+74
COMBINATION AIR
VALVE
I.E. 83.85

STA. 14+59
DRAIN VALVE & WET WELL
I.E. 81.00

STA. 18+15
COMBINATION AIR
VALVE
I.E. 85.00

STA. 18+95
DRAIN VALVE & WET WELL
I.E. 80.50

I.E. 83.30

STA. 20+50
AIR INJECTION POINT
SEE DETAIL SHT. 17

ANCHOR WALL
(TYPICAL)

STA. 23+20

STA. 23+55

STA. 23+90

STA. 24+25

STA. 24+60

12"S AC

STA. 24+95

STA. 25+10

12"S D.I.P.

STA. 25+45

STA. 25+65

ELEVATION - FT.

100
95
90
85
80
75

135
130
125
120
115
110
105
100

165
160
155
150
145
140
135
130

195
190
185
180
175
170
165

12+00
13+00
14+00
15+00
16+00
17+00
18+00
19+00
20+00
21+00
22+00
23+00
24+00
25+00
26+00

& STATION - FT.

REGISTERED PROFESSIONAL ENGINEER
7754
OREGON
JULY 13, 1979
PHILIP H. SMITH

PLAN & PROFILE
STA 12+05 to 26+00

SCALE 1" = 50' H., 1" = 5' V. | DATE FEB., 1986

NO.	REVISION	BY	DATE

TRI-CITY SERVICE DISTRICT
CLACKAMAS COUNTY, OREGON

WEST LINN FORCE MAIN
AND GRAVITY SEWER

DESIGNED N.L.V. | DRAWN R.F.D. | CHECKED P.H.S.

MURRAY, SMITH & ASSOCIATES, P.C.
Engineers/Planners
Harrison Square
1800 S.W. First Avenue, Suite 510
Portland, Oregon 97201
503 225-9010

MSA

SHEET
3 of 17

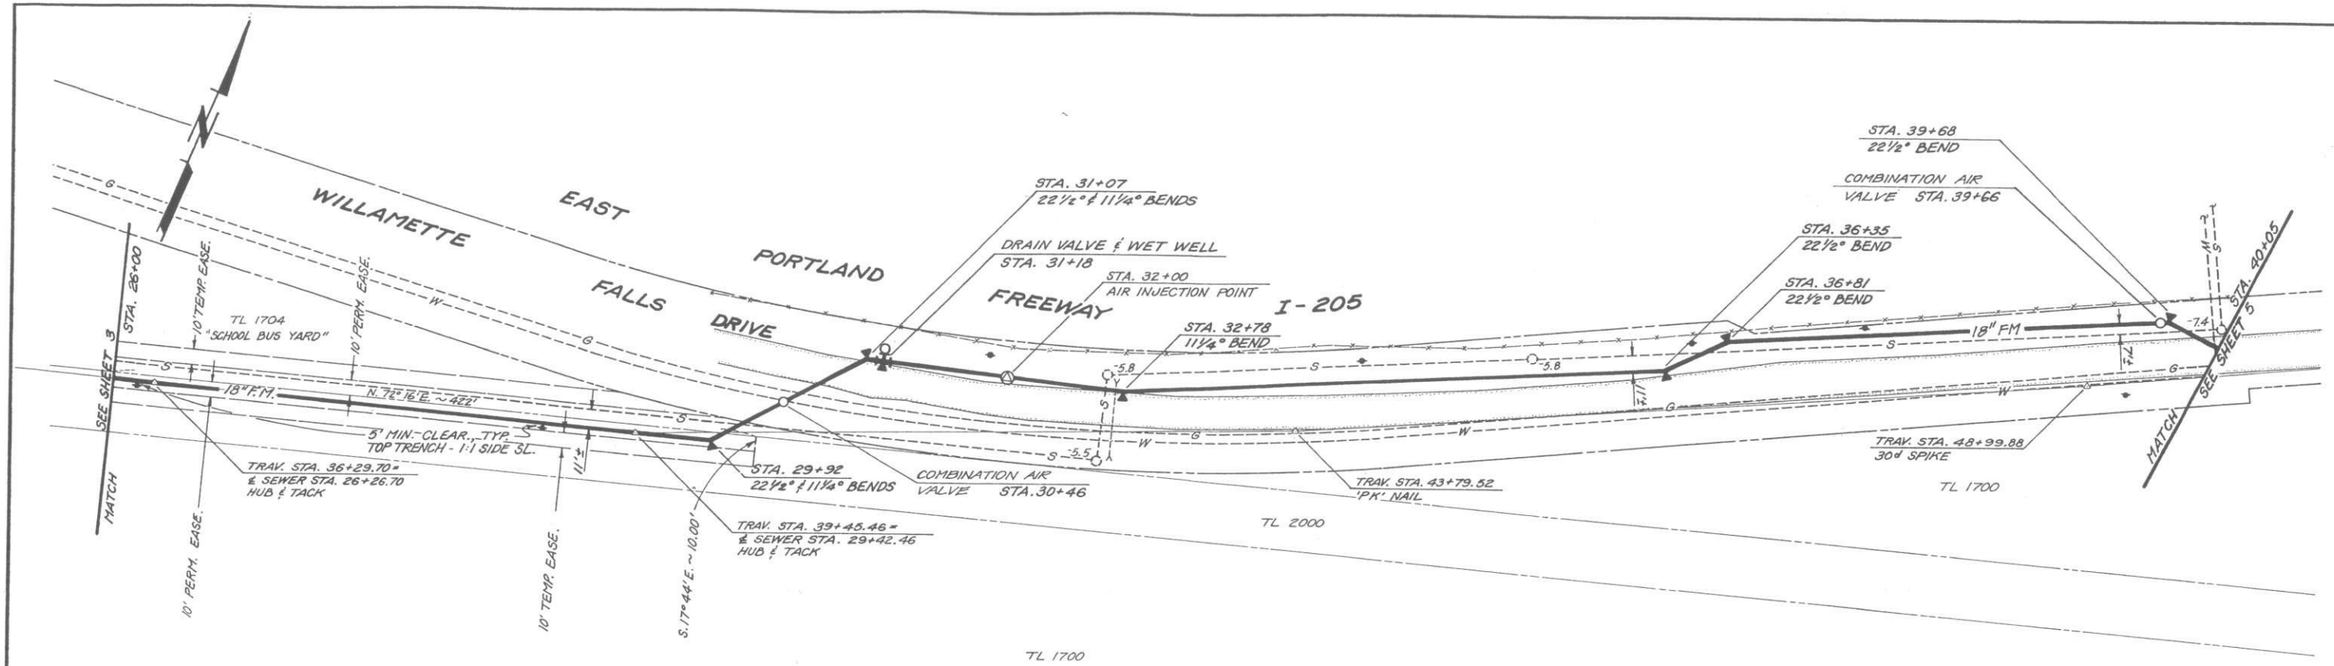

BEARING BASIS: PLAT OF "WILLAMETTE & TUALATIN TRACTS"

NOTE:
PROPERTY BOUNDARIES REPRESENTED ON THIS DRAWING ARE APPROXIMATE ONLY BASED ON ASSESSORS RECORDS AND DO NOT CONSTITUTE A PROPERTY SURVEY.

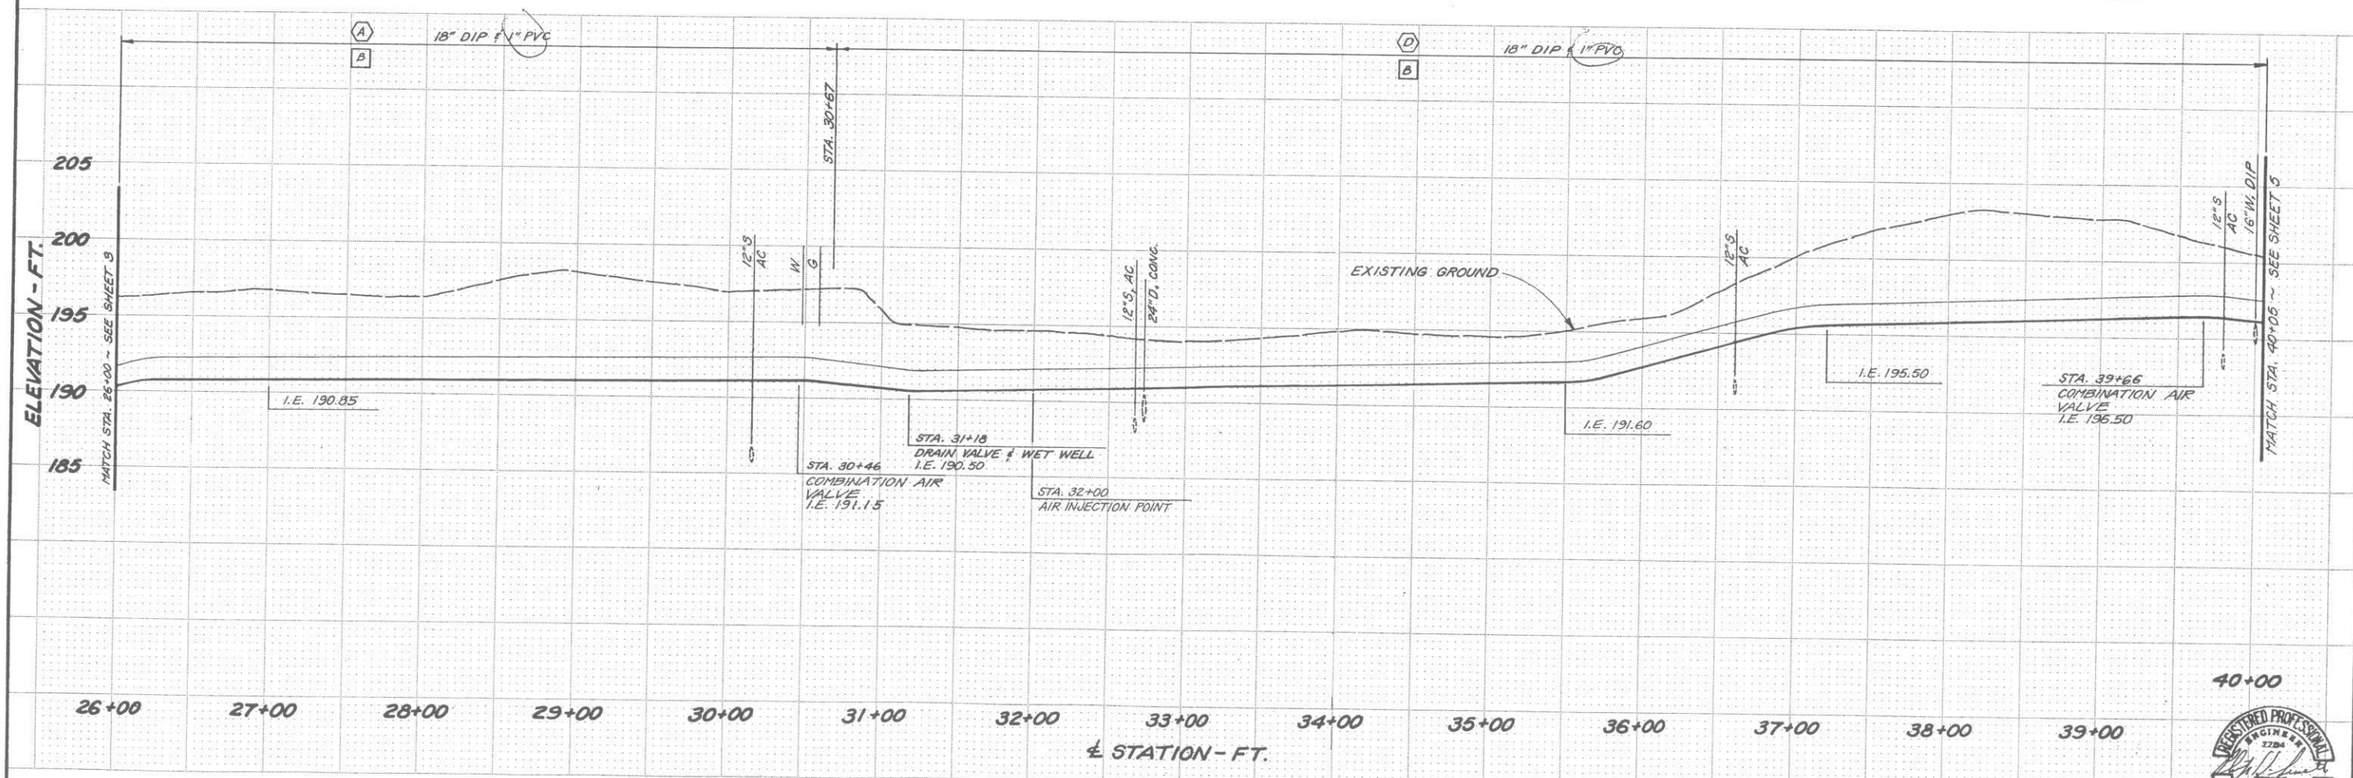

REGISTERED PROFESSIONAL ENGINEER
7784
OREGON
JULY 12, 1972

NO.	REVISION	BY	DATE

PLAN & PROFILE
STA. 26+00 to 40+05

SCALE 1" = 50' H., 1" = 5' V. | DATE FEB., 1986

TRI-CITY SERVICE DISTRICT
CLACKAMAS COUNTY, OREGON
WEST LINN FORCE MAIN
AND GRAVITY SEWER

DESIGNED NLV | DRAWN RFD | CHECKED PHS

MURRAY, SMITH & ASSOCIATES, P.C.
Engineers / Planners
Harrison Square
1800 S.W. First, Suite 500
Portland, Oregon 97201
503-225-9010

MSA

SHEET
4 of 17